


DRG. NO. K-7031

DIMENSIONS ARE IN mm.
UNTOLERATED DIMNS. AS PER IS : 2102 (MED)
ALL SHARP EDGES TO BE REMOVED

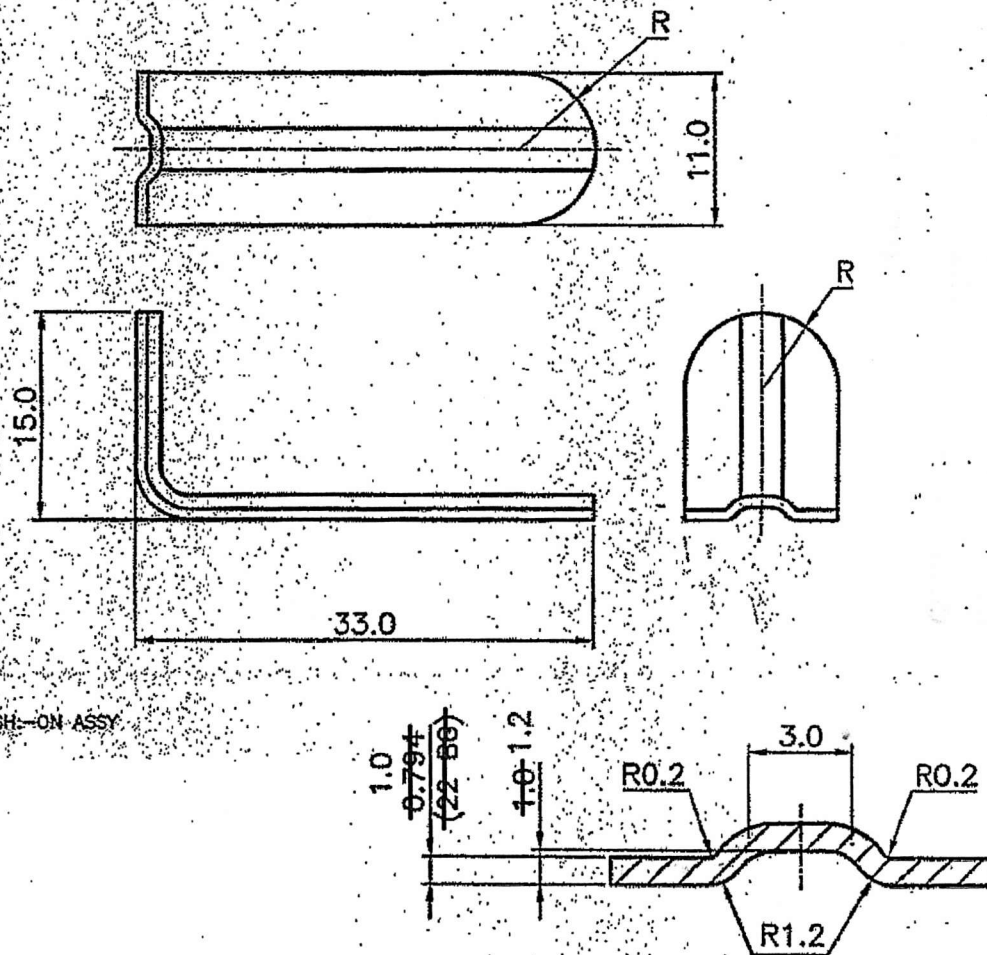

MATERIAL:-
6061/6063
ALUMINIUM ALLOY SHEET ~~5000-1192~~
~~PER AMS-QQ-A-250/7~~
1 mm THICK SHEET

(NODAL OFFICER
FOR TAR)

GUIDE SPRING		AS ABOVE			
PART NO.	DESCRIPTIONS	NO OFF	MATERIAL	TREATMENT	REMARKS
 TRACED DRAWN CHECKED HOS/D&DO OFFICER/PRODN. OFFICER/D&DO	SIGNATURE & DATE.				SCALE
	SUB: GUIDE SPRING				STORE DRG.NO.
	FOR: Aluminium MAGAZINE				K-7031
	OF: TRICHY ASSAULT RIFLE				OPERATION NO.
	DES. REF. NO.				
DA.No.50/19 Dt.:09/12/19		DRG. No.: TAR-K-7131*		SHEETS: 1	
AMENDMENTS		APPROVED ON: 11/11/2019		SHEET No.: 1	



ORDNANCE FACTORY
TIRUCHIRAPPALLI-16.