


TECHNICAL CONDITIONS

1. Zinc plating 15 followed by chromate treatment.
2. Provide for sizes by appropriate tools which are to be checked at least once quarterly.

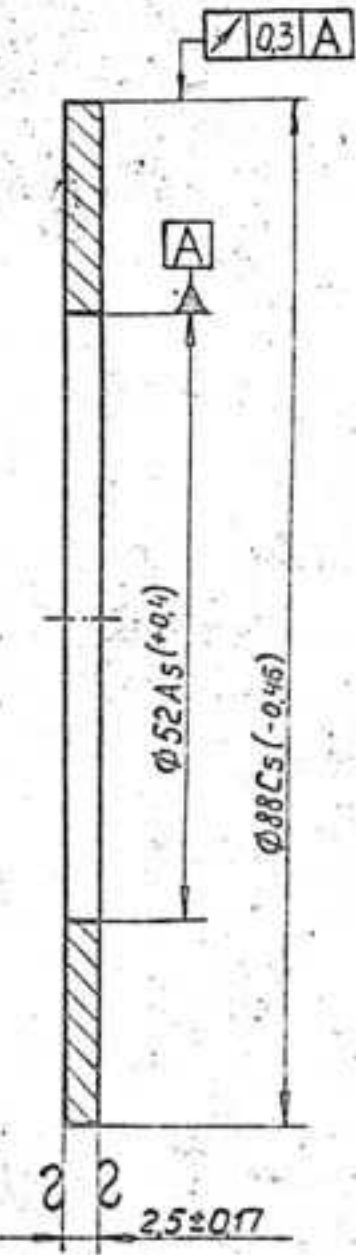

EXPLANATORY NOTES TO TECH. CONDITIONS

1. CROSS BEAM SHOULD BE MANUFACTURED FROM COLD ROLLED QUALITY CARBON STEEL OF GRADE 10, SHEET 2.5 mm THK. WITH STANDARD ROLLING ACCURACY (B) CATEGORY 4 & HIGH SURFACE FINISH (II) HAVING THE DIMENSION OF SHEET AS PER GOST 19904-74 AND CHEMICAL COMPOSITIONS & MECHANICAL PROPERTIES CONFORM TO GOST 16523-78 & GOST 1050-74.

2. CHEMICAL COMPOSITION (GOST 1050-74)

CONTENTS OF ELEMENTS %			
CARBON	SILICON	MANGANESE	CHROMIUM
0.07-0.14	0.17-0.37	0.35-0.65	0.15 (MAX.)

3. MECHANICAL PROPERTIES :-

- a) TENSILE STRENGTH — 30-42 Kgf/mm²
- b) RELATIVE ELONGATION — 2.8%

iv) $\square 0.3 A$:- REPRESENTS THE RUN OUT OF INDICATED DIMENSION TO BE WITHIN 0.3 mm FROM THE BASE INDICATED AS 'A'

v) $\square A$:- INDICATES BASE DIMENSION IS 'A'

vi) DIMENSIONS SHOWN IN RECTANGLES ARE WITHOUT TOLERANCES BUT THOSE ARE NOT A FREE DIMENSIONS.

4. SURFACE FINISH :-

ab - REPRESENTS SURFACE FINISH TO BE OBTAINED IN Ra VALUE OF 50 μ ON BOTH SIDE OF THE JOB.

▽3(V) - REPRESENTS SURFACE FINISH TO BE OBTAINED IN Ra VALUE OF 20 μ ON THOSE SURFACES WHERE SURFACE FINISH IS NOT SPECIFIED.

$\square +0.12$ DISPLACEMENT OF HOLE AXES TO BE WITHIN 0.12 mm FROM ITS THROUGH POSITION

APPROVED	50 10 20 73	3A 25 005	WEIGHT	SCALE
CHECKED			0.066	2:1
		CROSS BEAM	SHT	SHTS. 1
		SHEET 52-5 GOST 19904-74		
		4-1-10 GOST 16523-78		

DESCRIBED	DWG. NOT TO BE SCALED.	PERTAINS TO
CHECKED	ALL SHARP EDGES & CORNERS ARE TO BE ROUNDED OFF.	
APPROVED	ALL DIMENSIONS ARE IN MM. UNLESS OTHERWISE SPECIFIED.	
DATE		CROSS BEAM
TOLERANCE UNLESS OTHERWISE SPECIFIED.		3A 25 005
SCALE:-		CONTROLLERATE OF INSPECTION FIRE FIGHTING EQPT. PUNE.

3A 25.006 CB

Справ. №


Подпись и дата

№ Инв. №-автом.

Взв.

Подпись и дата

№ док. №

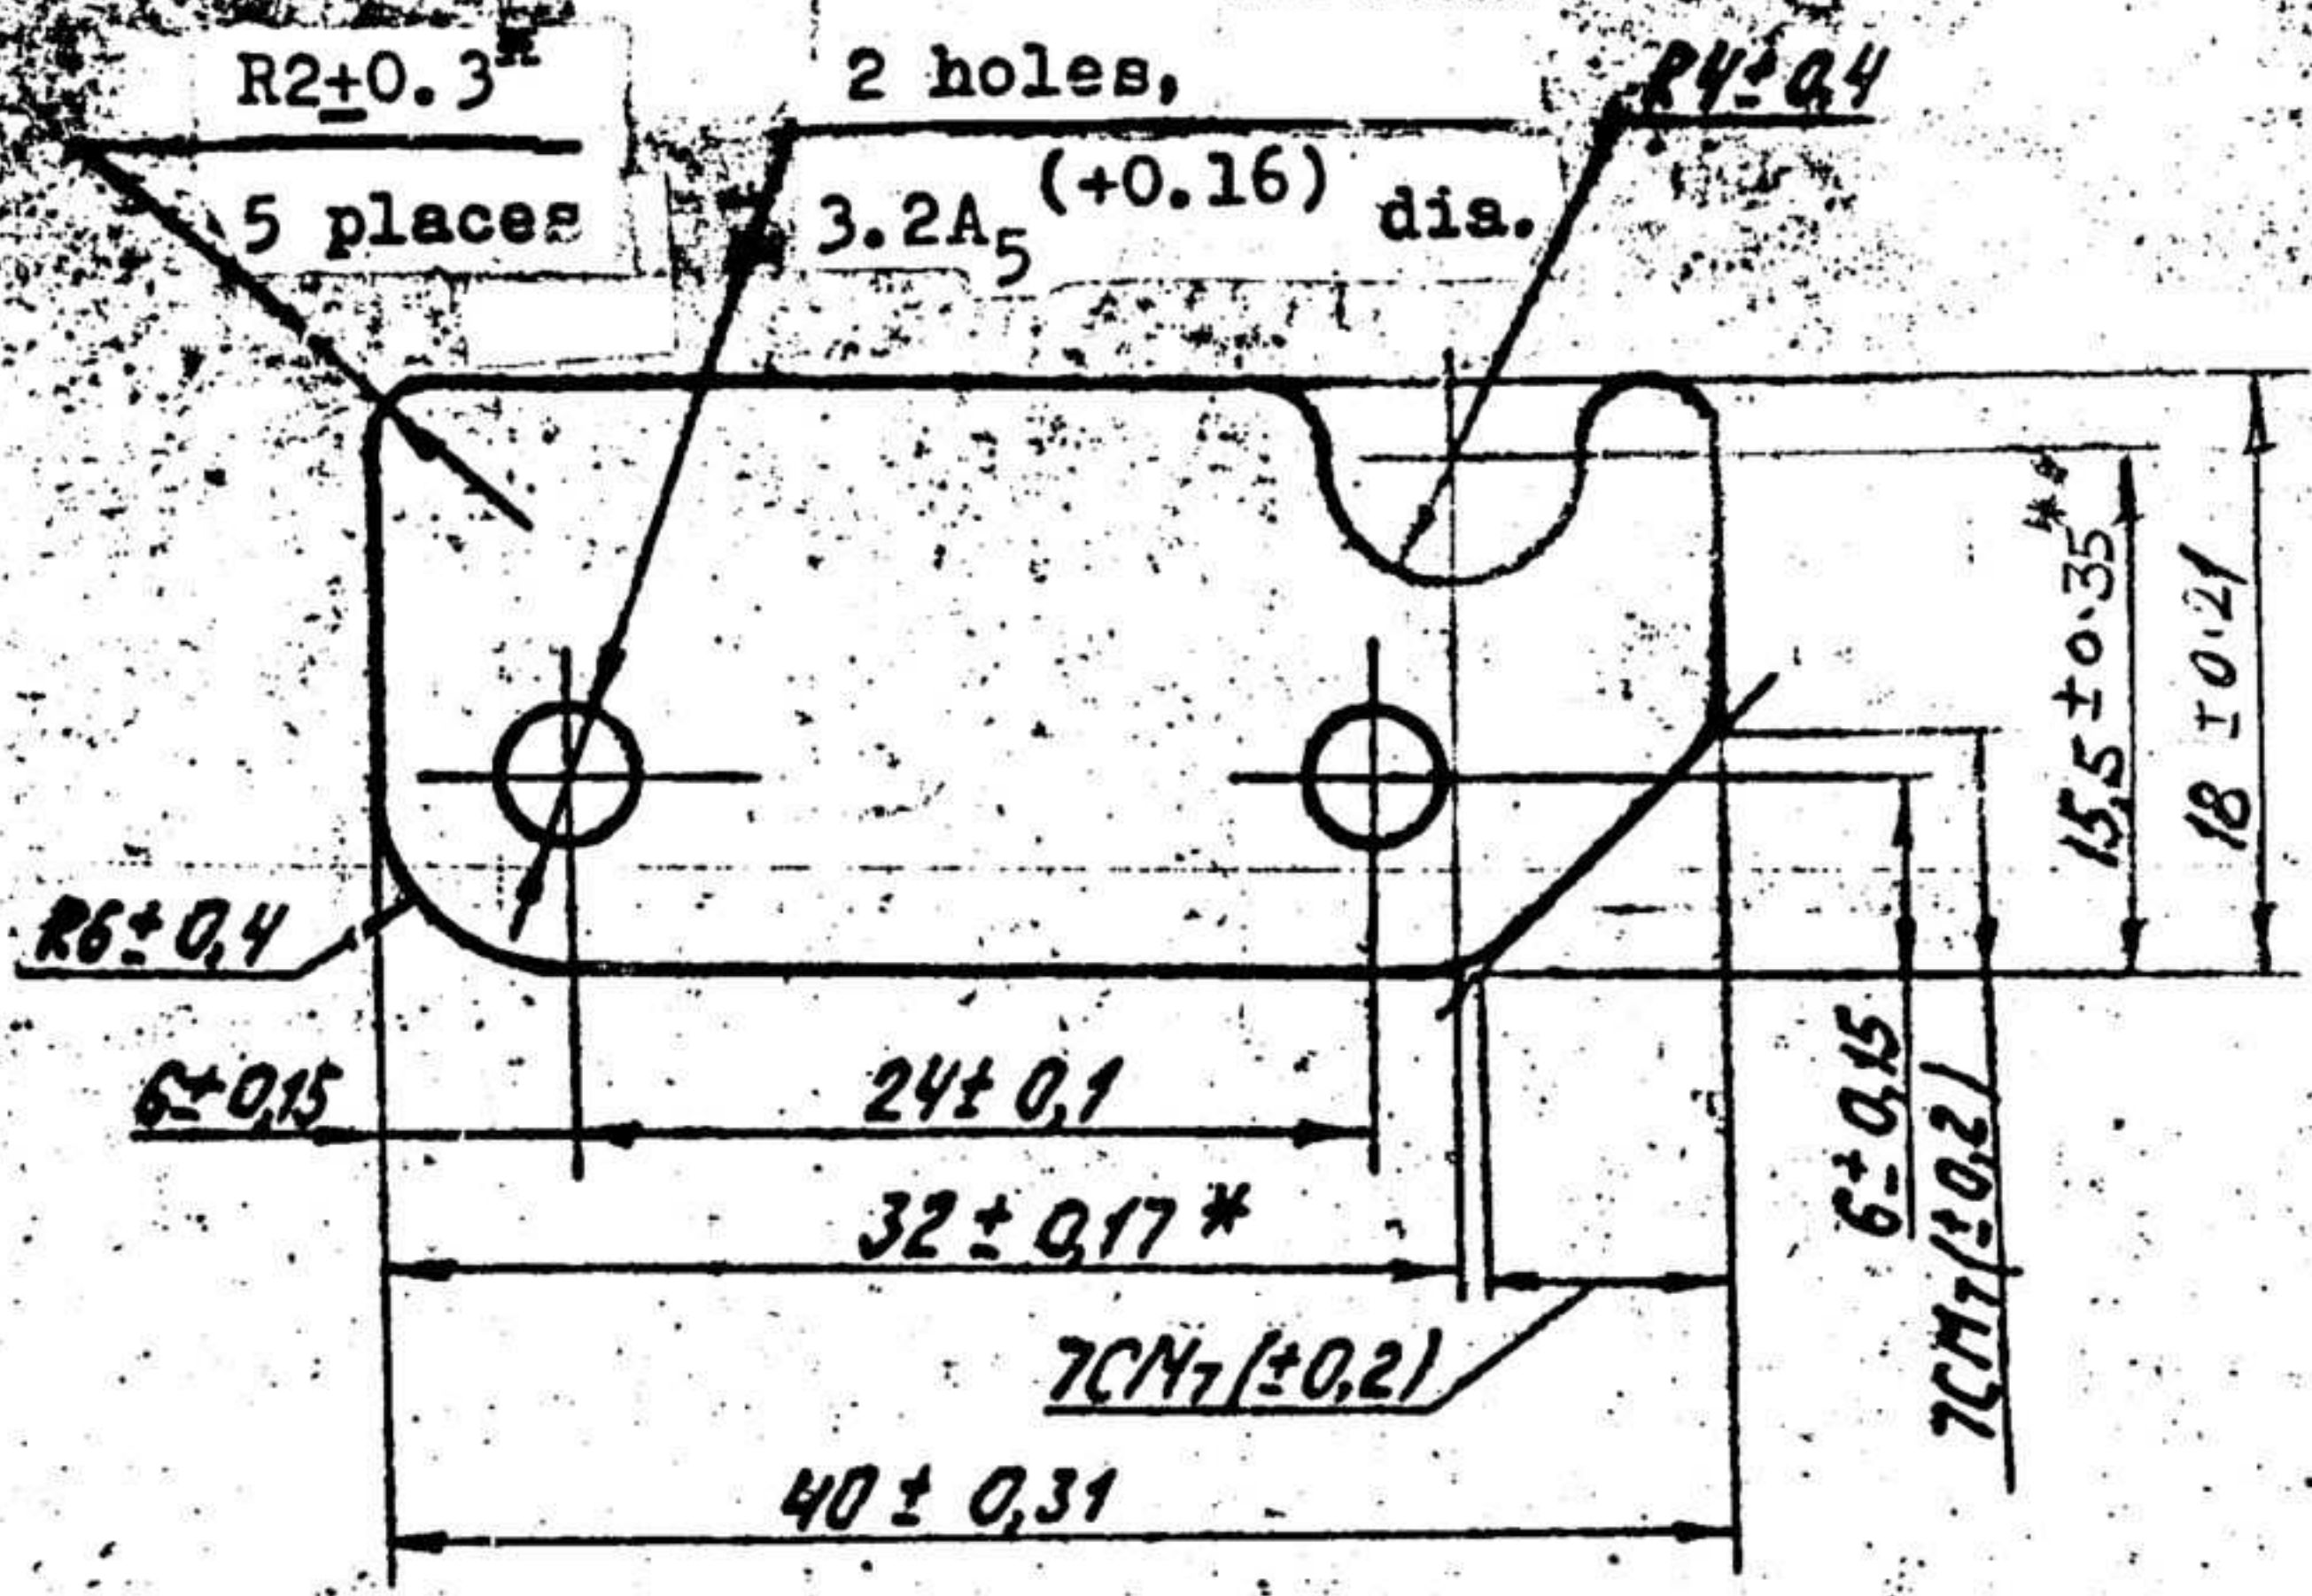

TECHNICAL CONDITIONS

1. Impregnate with varnish ГФ-95 ГОСТ 8018-70.
 2. Local tears of 0.5 mm, max., deep are allowed on the part contour without chipping of surfaces A.
 3. Provide for sizes by appropriate tools which are to be checked at least once quarterly.
 4. Size for reference.
- REFER TO DRG No ЭД.25.003 FOR EXPLANATORY NOTES

SURFACE FINISH

REPRESENTS THE REMOVAL OF MATERIAL IS NOT PERMITTED ON BOTH SIDES OF THE JOB.

Jeenu
(R. VEERARAGHAVAN)
SSO-II


51/02073

APPROVED <i>MVABU</i>		ЭД 25.006	
CHECKED <i>H. Balachandran</i>		GASKET	WEIGHT SCALE
CONTROLLERATE OF INSPECTION			0.028 2:1
		SHT SHTS 1	
PUNE		GLASS-CLOTH-BASE LAMINATE CT-I-1.5, ГОСТ 12652-74	

LOOSE

▽3 (▽)

2 holes, 3.2A₅ (+0.16) dia.

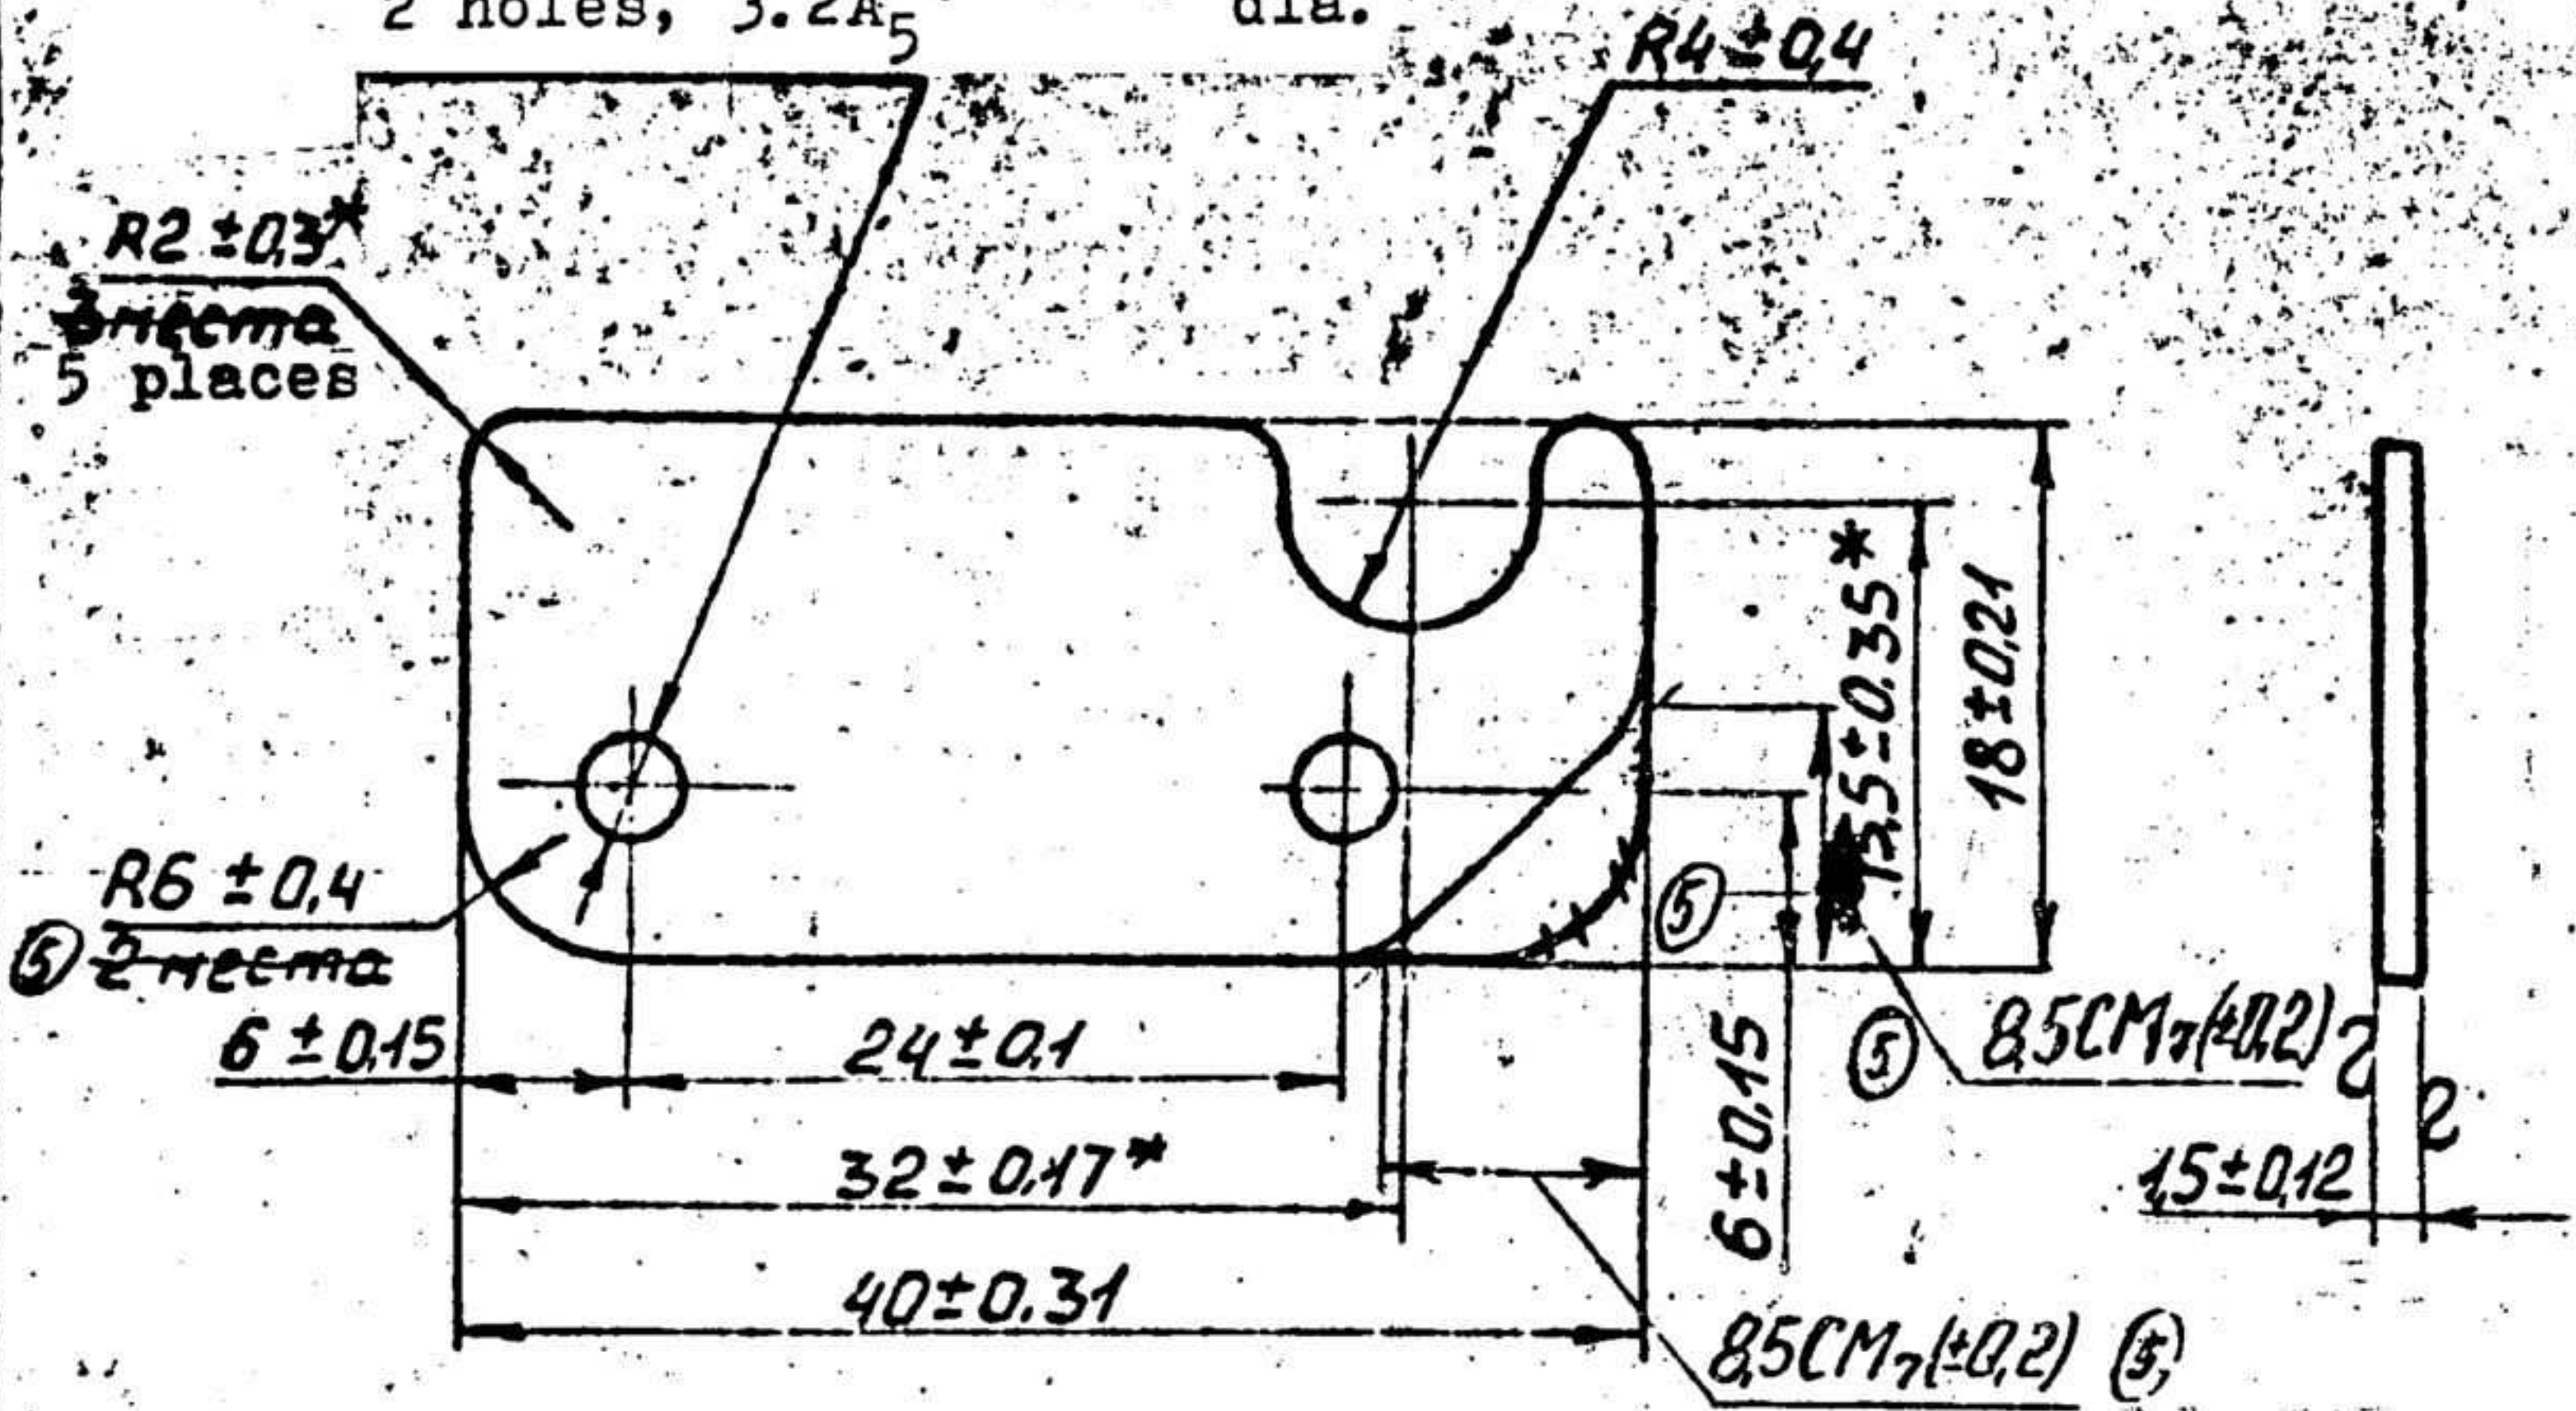

REFER TO DRG No 3A 25.005 FOR EXPLANATORY NOTES

SURFACE FINISH

∇_5 - REPRESENTS SURFACE FINISH TO BE OBTAINED IN Ra VALUE 80 μ MAX; ON BOTH SIDE OF THE JOB

$\nabla_3(\nabla)$ - REPRESENTS SURFACE FINISH TO BE OBTAINED IN Ra VALUE 20 μ MAX ON THOSE SURFACES WHERE SURFACE FINISH IS NOT SPECIFIED.

TECHNICAL CONDITIONS

(Signature)
(R VEERARAGHAVAN)
550II

1. Coating: zinc plating 15 followed by chromate treatment.
2. Provide for size by appropriate tools which are to be checked at least once quarterly.

Восстановлен с подлинника.

3A25.050C6

52102073

APPROVED *(Signature)* AVASU

CHECKED *(Signature)* Palashan

CONTROLLERATE OF INSPECTION

FE (ICV) PUNE

3A 25.007

GASKET

SHEET Б 1.5 ГОСТ 19904-74
4-II-10 ГОСТ 16523-70

WEIGHT	SCALE
0.008	2:1
SHT	SHTS 1
1-4-4	

No.	Designation	Description	Qty	Remark
	3D25.050 CB	<u>Documentation</u> Assembly drawing		
		<u>Parts</u>		
1	MB67.035	Brush holder	4	
3	MB67.110	Spring	4	
5	MB67.111	Shaft	4	
7	X2-43-92	Nut	4	
9	X3-10323	Washer	4	
10	X3-10482	Washer 3.01.016 ГОСТ 10450-78	8	Maximum number
11	X5-29-48-01	Insulating washer	16	
13	X3-9675	Washer	8	
15	X5-114-53-01	Washer	4	
17	8X-525	Rivet	4	
18	8X-4191	Rivet	4	
19	3D25.005	Cross beam	1	
21	3D25.006	Gasket	2	
22	3D25.007	Gasket	2	
		<u>Standard Items</u>		
30		Pin 1.6x12.016 ГОСТ 397-79	4	


19/02073

APPROVED	<i>[Signature]</i>	3D25.050		
CHECKED	<i>[Signature]</i>			
CONTROLLERATE OF INSPECTION FE (ICV) PUNE	CROSS BEAM	WEIGHT SCALE		
		SHT	SHTS	


TECHNICAL CONDITIONS

1. Set the pressure (550 ± 25 g) of springs, Ref. No. 3, at points "П" by turning the shaft, Ref. No. 5. Lock the shaft with nut, Ref. No. 7.
2. Upon beading the rivets, coat surfaces K and B with enamel ГФ-92XC, grey, ГОСТ 9151-75.
3. Parallel misalignment relative to windows of opposite brush holders is within 0.2 mm.
4. Use washers, Ref. No. 10 or Ref. No. 13, as may be required by the protruding length of rivets, Ref. No. 17 or Ref. No. 18.

A - A
Scale 2:1

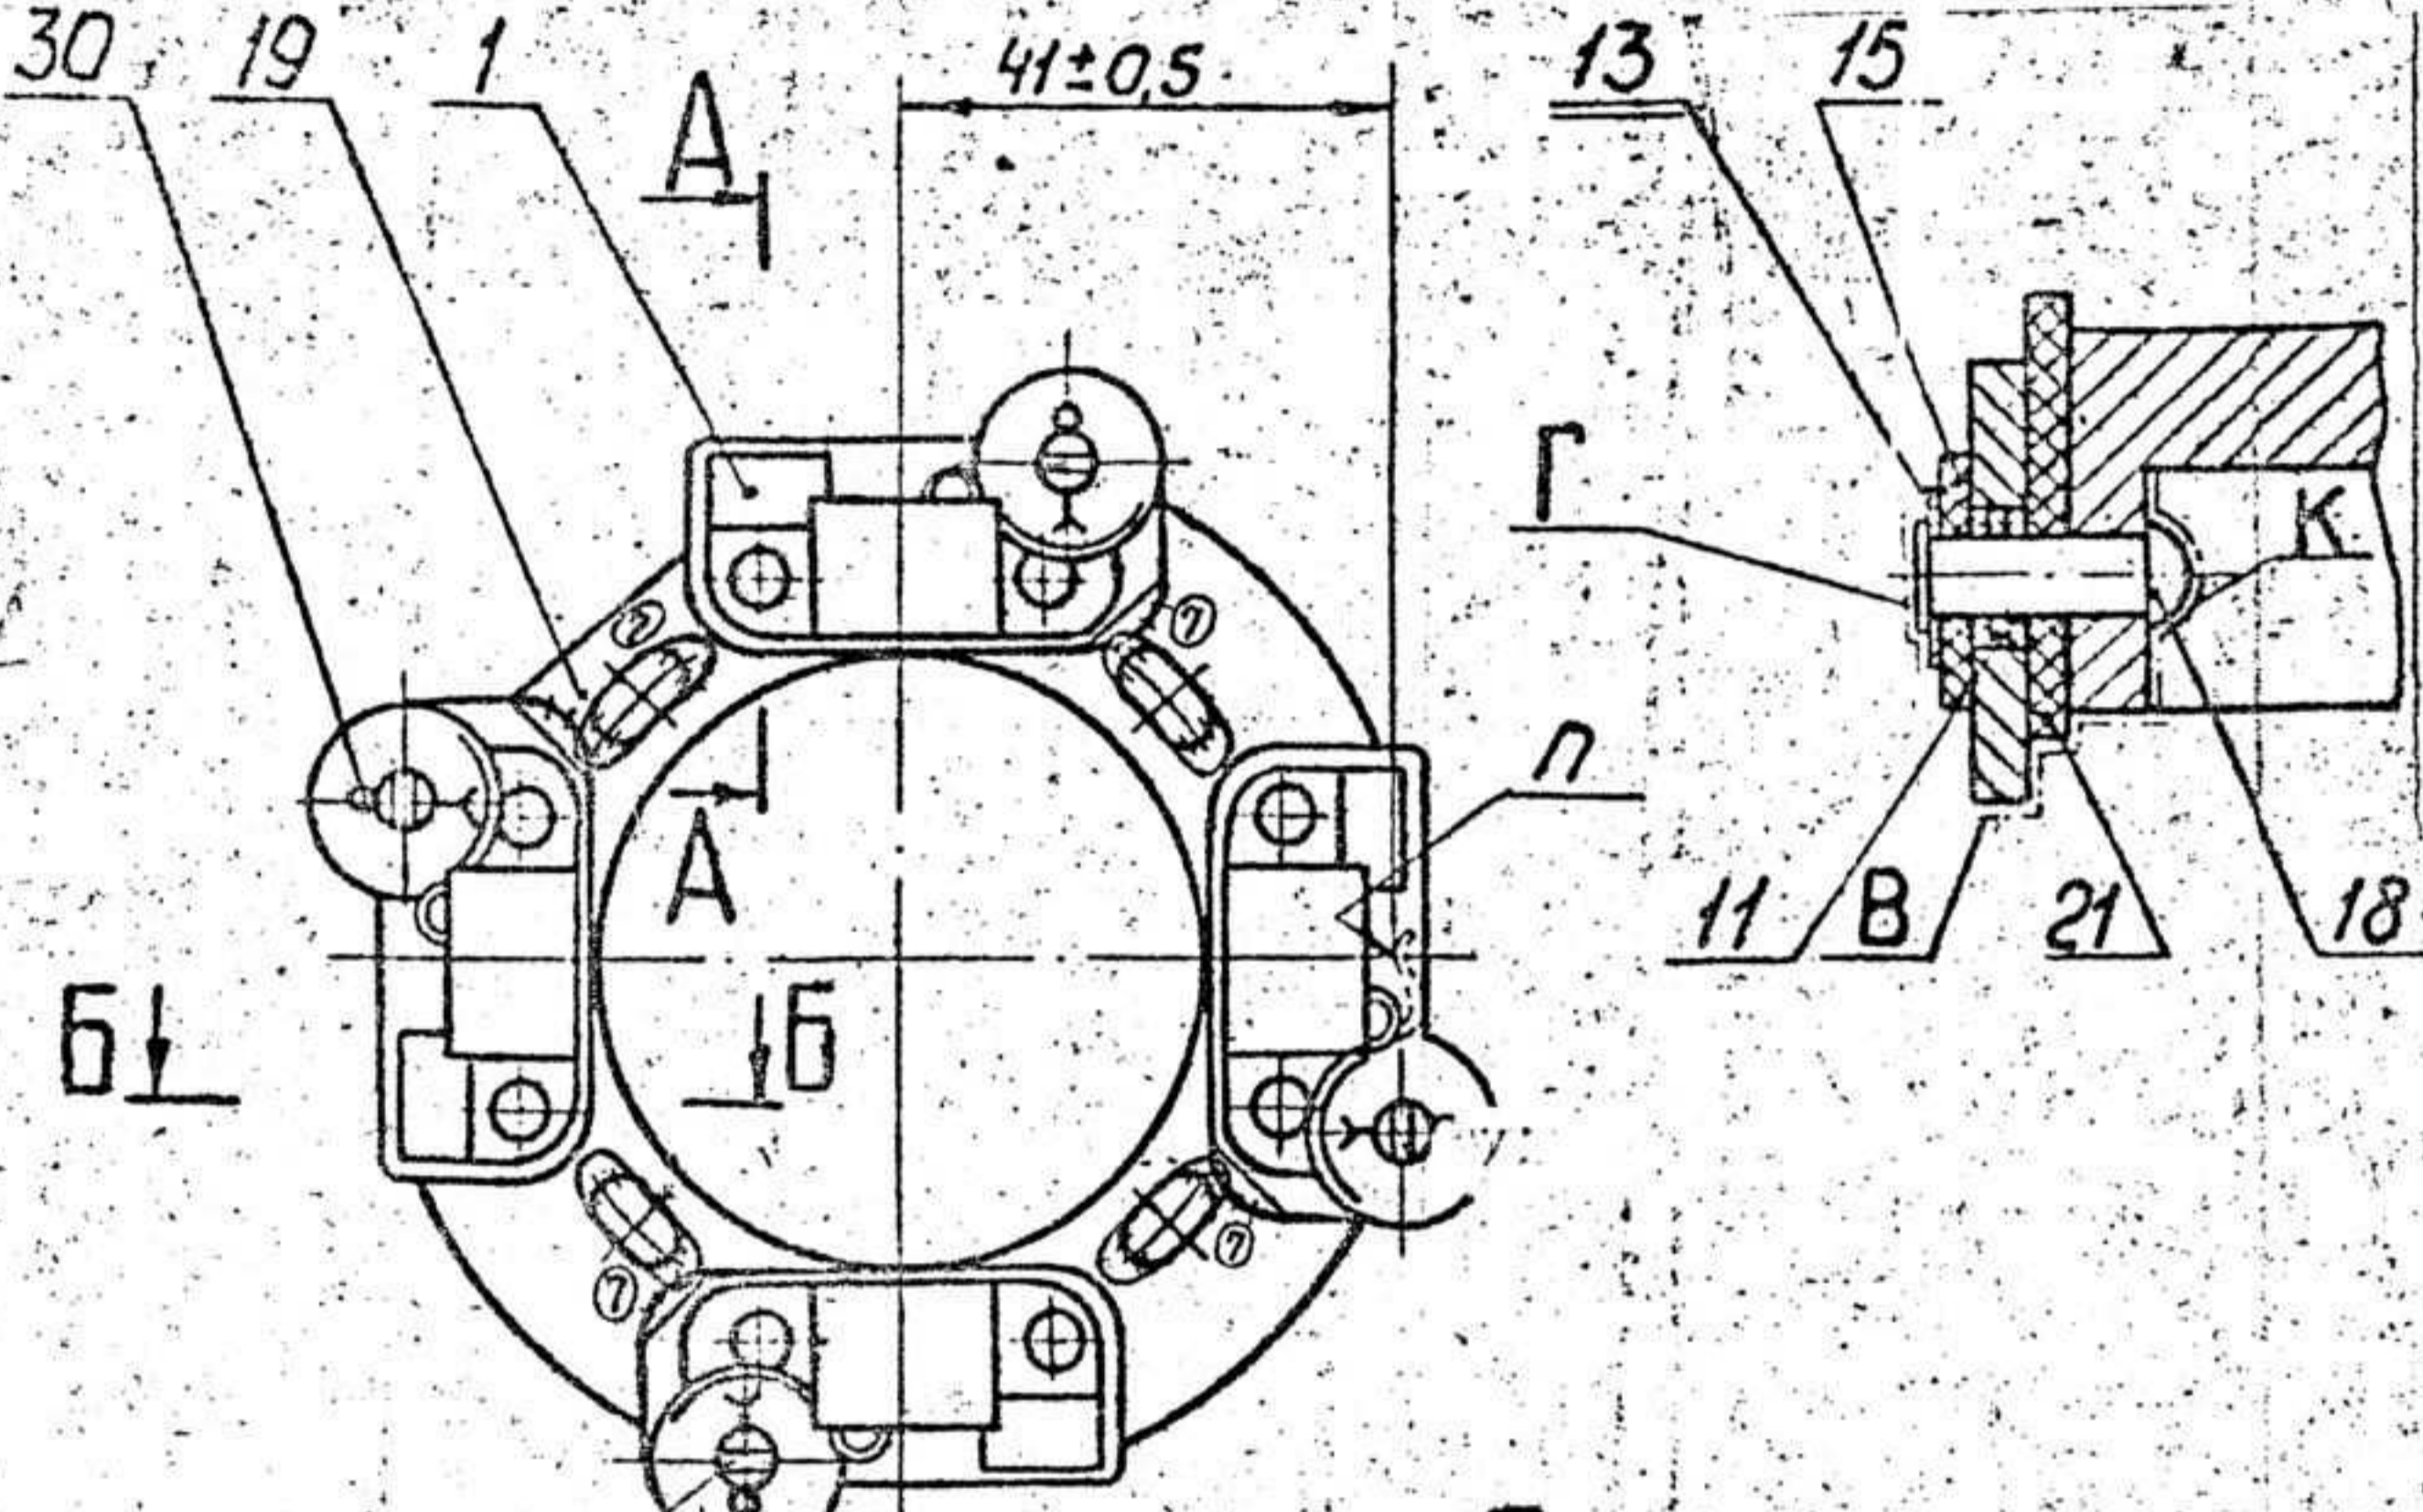

Б - Б
Scale 2:1

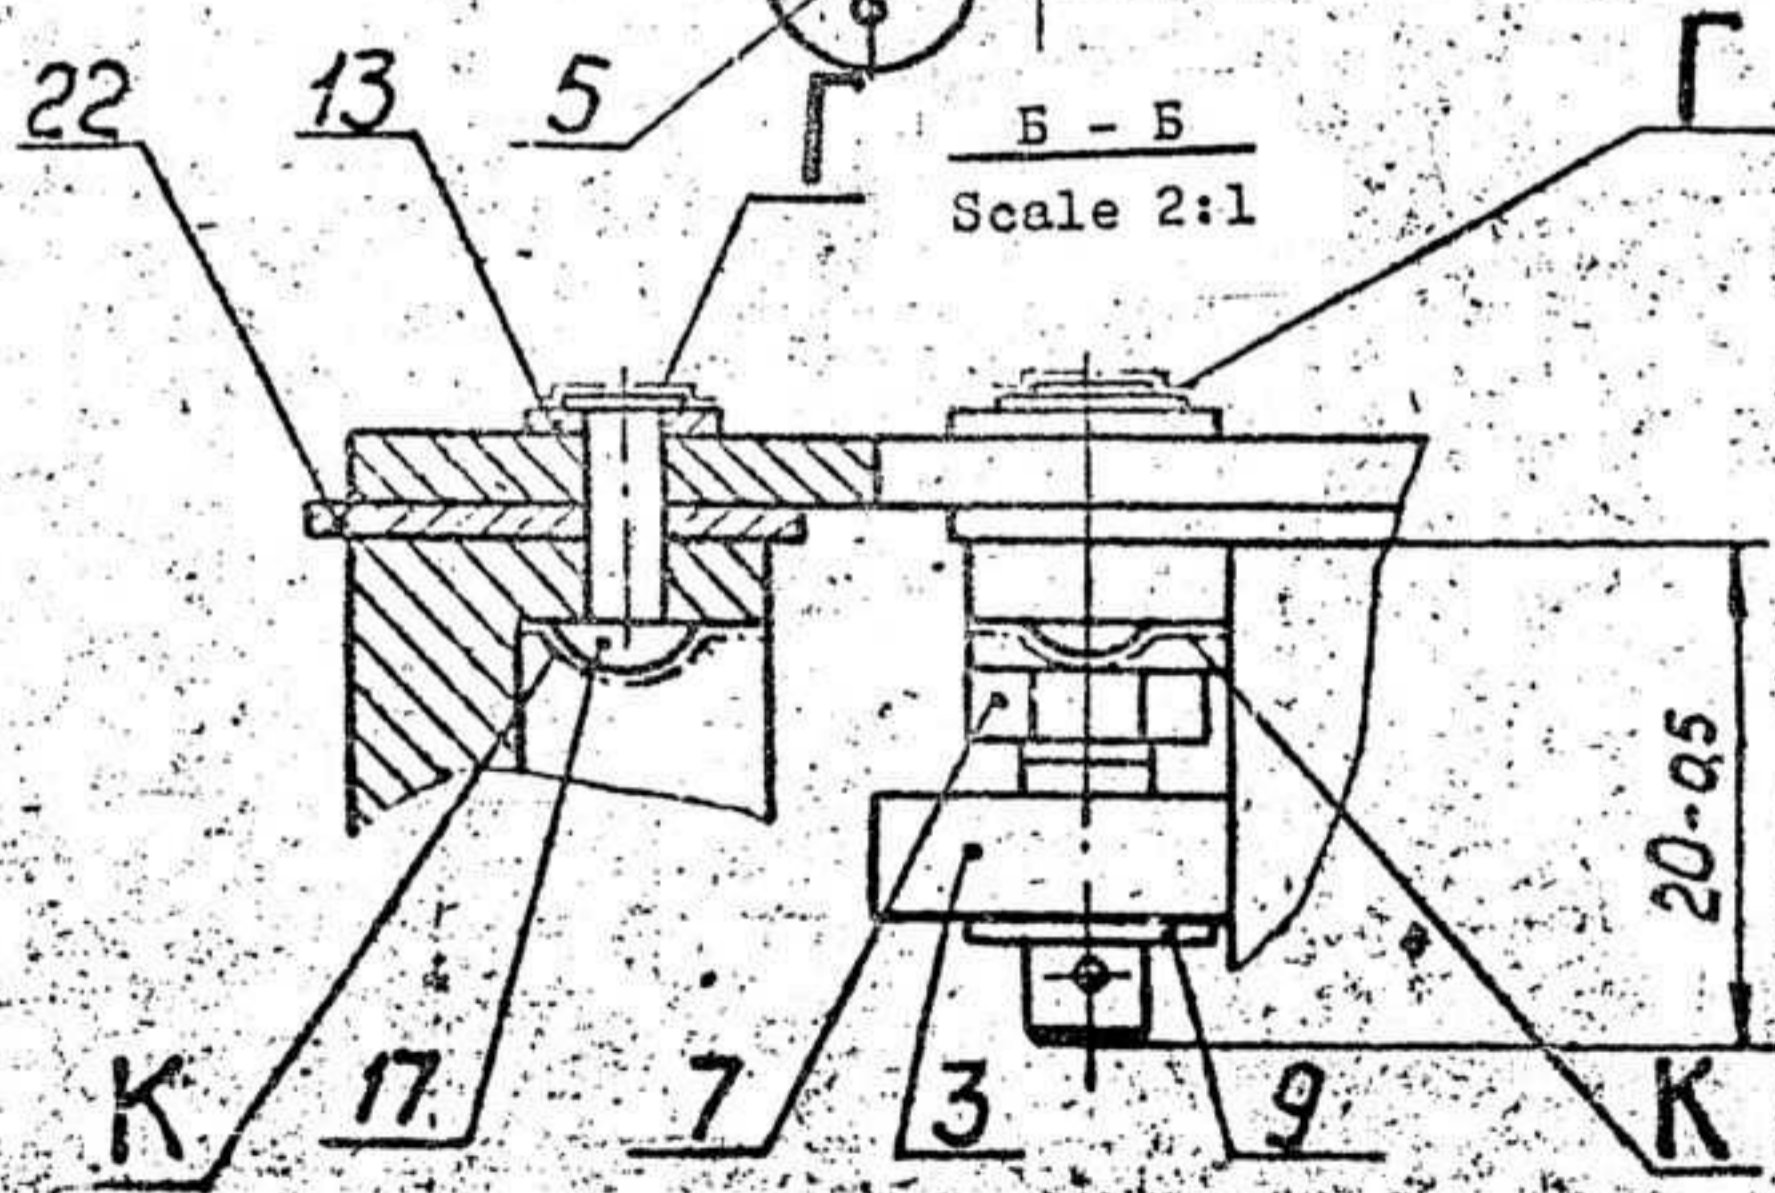

APPROVED <i>[Signature]</i>		3A25.050 CB	
CHECKED <i>[Signature]</i>		CROSS BEAM ASSEMBLY DRAWING	WEIGHT
CONTROLLERATE OF INSPECTION			SCALE
FE (IC) PUNE		SHT	SHTS 1


20/02073

Easy2Convert
www.easy2convert.com

8X-525

Rz 40
✓✓

Sphere R 2.9[#]

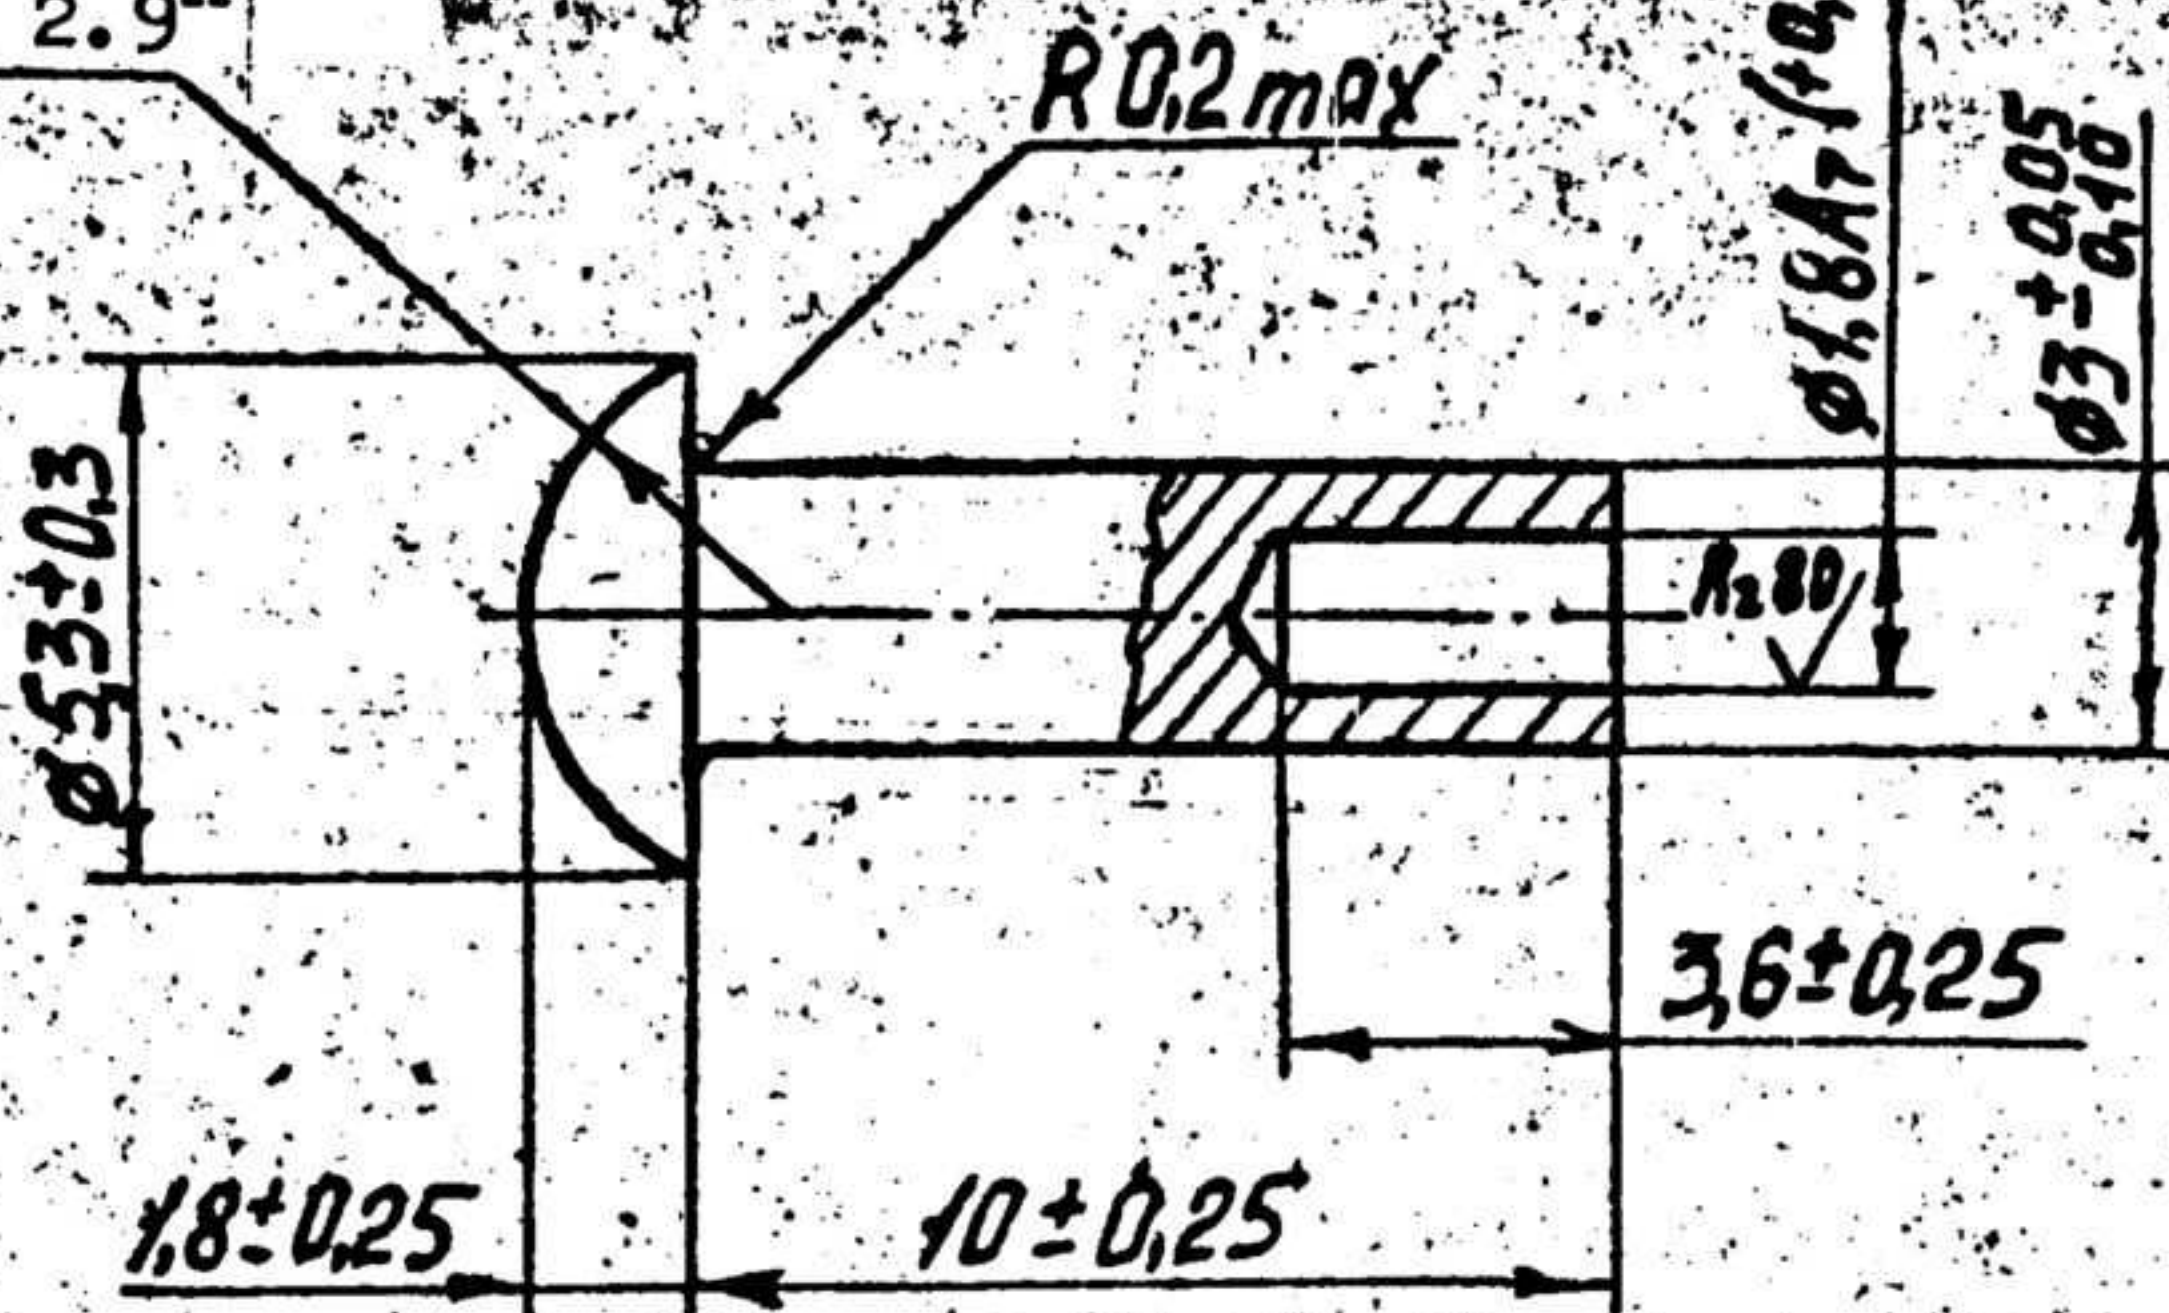

REFER DRG NO X2-4392 FOR MATERIAL

Designation	Coating	HARDNESS
8X-525	Zinc plating 6 followed by chromate treatment	BHN (143 MAXIMUM)

TECHNICAL CONDITIONS

- Size for reference.
- Tolerable displacement relative to the rod axis:
head axis - 0.2 mm, hole axis - within 0.1 mm.
- Other technical requirements as per ISCT 12644-80.

SURFACE FINISH

Rz 80/ :- REPRESENTS SURFACE FINISH TO BE OBTAINED BY ANY PRODUCTION METHOD IN Rz VALUE 80 μL MAX.
 Rz 40/ (V) :- REPRESENTS SURFACE FINISH TO BE OBTAINED BY ANY PRODUCTION METHOD IN Rz VALUE 40 μL MAX ON THOSE SURFACES WHERE SURFACE FINISH IS NOT SPECIFIED.

(R VEERARAGHAVAN) 01 / D2073
SSO II

APPROVED *[Signature]*
 CHECKED *[Signature]*
 CONTROLLERATE
 OF
 INSPECTION
 (ICV) PUNE

8X-525
 RIVET
 STEEL 10 ISCT1050-74

WEIGHT	SCALE
0.68	5:1
SHT	SHTS 1


1-4-4

Восстановлен с подлинн. во
 Подпись и дата
 Мис. № 2551
 100

Испр. № 2
 НВН-2
 Справ. №

1614-X8

Rz 40 / (V)

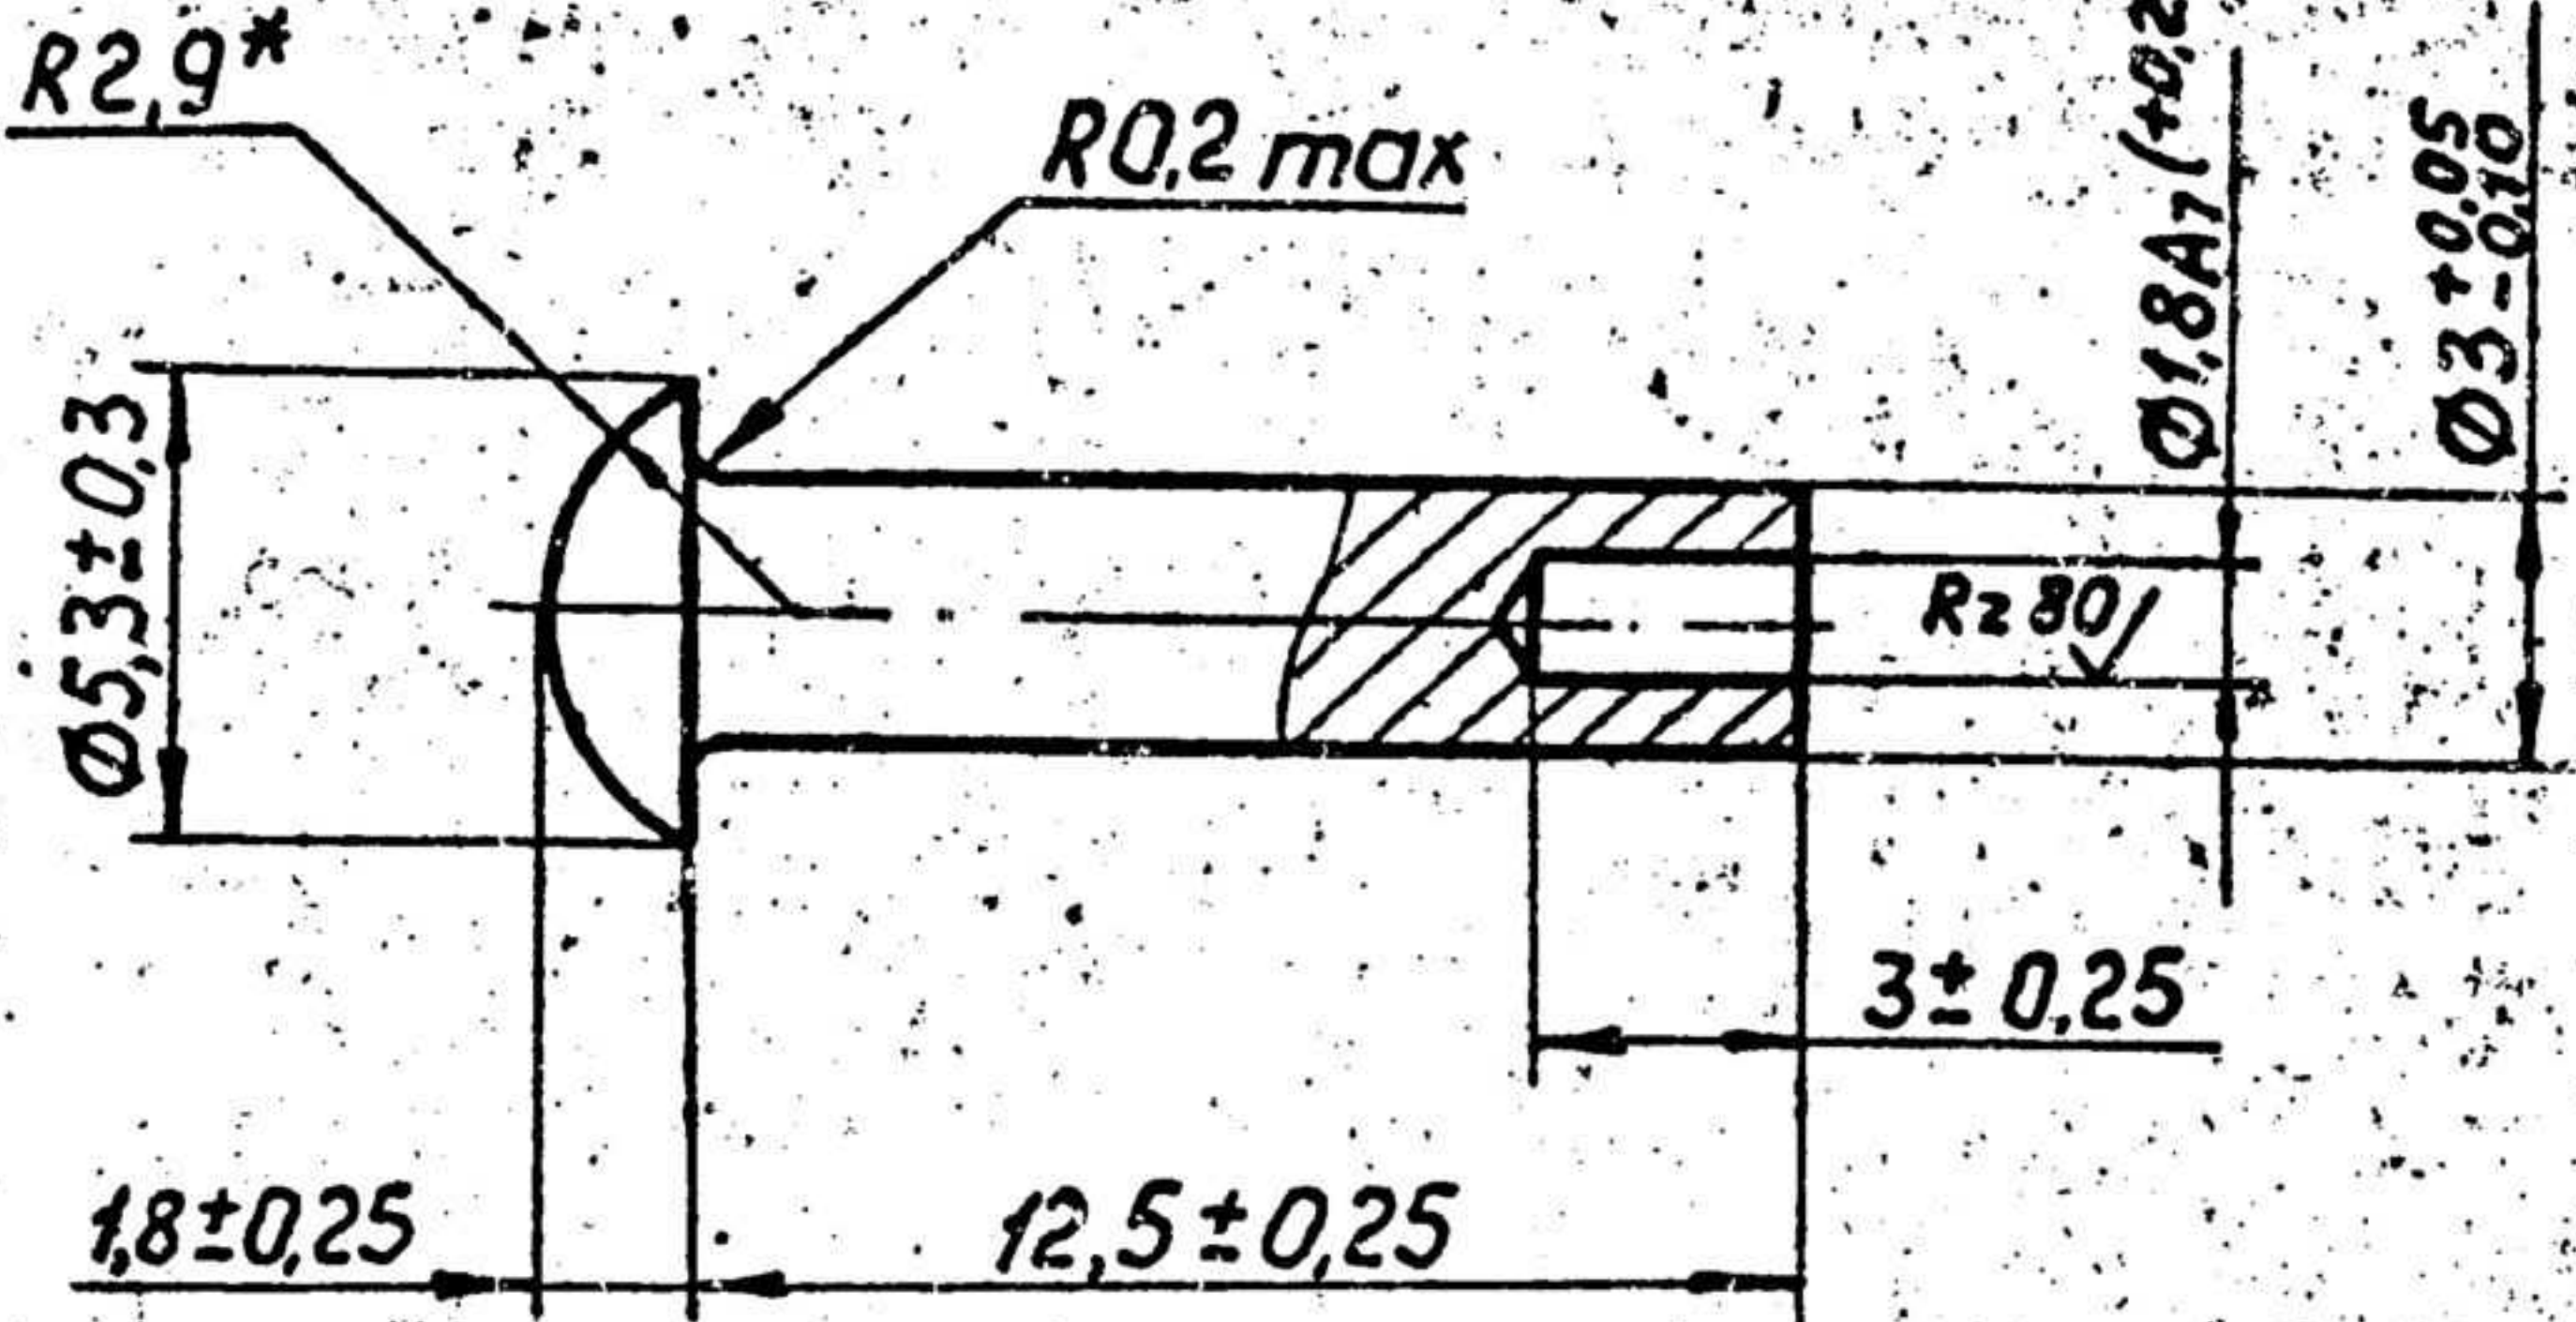

HARDNESS-BHN 143 (MAXIMUM)

Designation	Coating
8X-4191	Zinc plating 6 followed by chromate treatment

Rz 80 / (V) REPRESENTS SURFACE FINISH TO BE OBTAINED BY ANY PRODUCTION METHOD IN Rz VALUE 80 μ MAX.

TECHNICAL CONDITIONS

- “ REFER DRG NO X2-4392 FOR MATERIAL ”
- * Size for reference.
 - Tolerable displacement relative to the rod axis:
head axis - 0.2 mm; hole axis - 0.1 mm.
 - Other technical requirements as per IOCT 12644-80.

SURFACE FINISH

Rz 40 / (V) REPRESENTS SURFACE FINISH TO BE OBTAINED BY ANY PRODUCTION METHOD. IN Rz VALUE 40 μ MAX. ON THOSE SURFACES WHERE SURFACE FINISH IS NOT SPECIFIED.




(R VEERARAGHAYAN) 85/ D2073
SSOTF

APPROVED *[Signature]*
 CHECKED *[Signature]*
 CONTROLLERATE
 OF
 INSPECTION
 FE (ICV) PUNE

8X-4191		WEIGHT	SCALE
SPECIAL RIVET		0.85g	5:1
		SHT	SHTS. 1
STEEL 10 IOCT 1050-74			

1-4-4

MB67.035

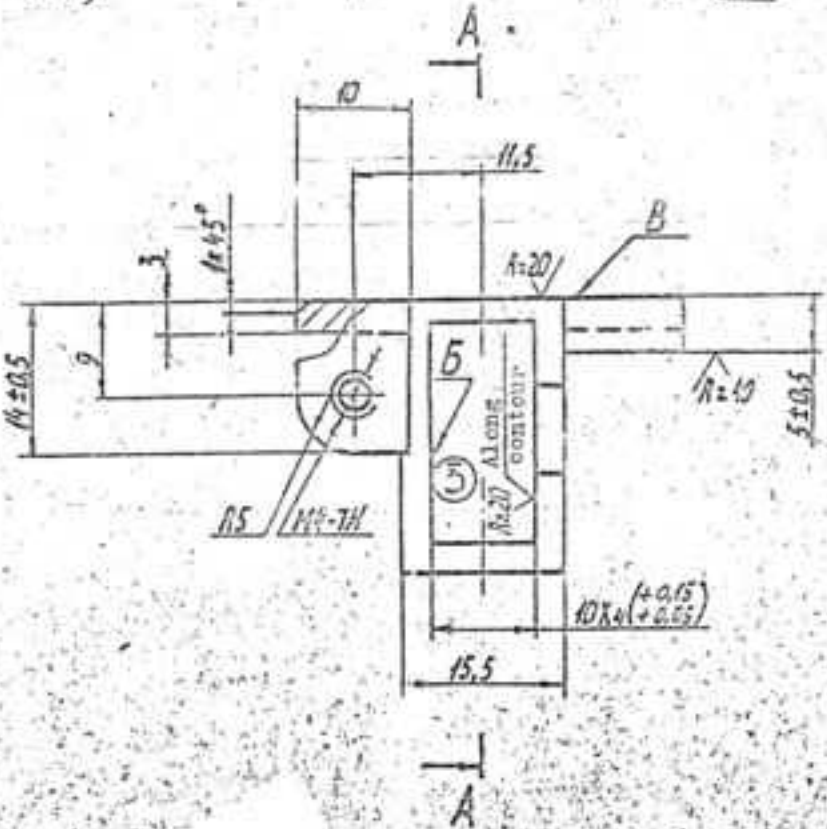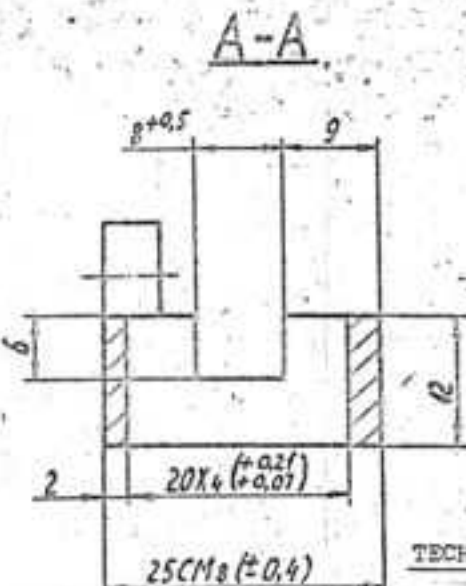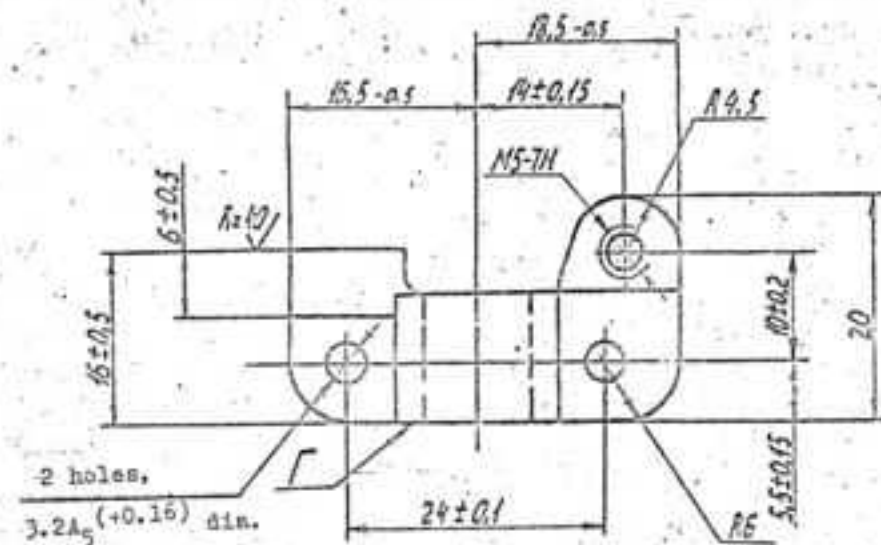

TECHNICAL CONDITIONS

1. Material substitute: Casting I-OCT3-4227-79 AL9 KTS GOCT 2685 75
2. Tolerable deviations of sizes are within ±0.25 mm, angular deviations, within ±30' unless otherwise specified.
3. Casting slope gradients are 2 in increasing order of outer sizes and in decreasing order of inner sizes.
4. Casting radii are within 1 mm.
5. Round off sharp edges to R = 0.3 mm.
6. Squareness tolerance of axis of window B relative to surface is within 0.3 mm.
7. Markings may be omitted.
8. Tolerable sinks left by the pushers on surface Γ, should be within 0.5 mm deep.

APPROVED	MB67-035	WEIGHT	SCALE
CHECKED	BRUSH HOLDER	12g	2
		SHT	SHTS
CASTING	I-OCT3-4227-79		
	AL9 KTS GOCT 2685-75		

MB67-035

EXPLANATORY NOTES TO TECHNICAL CONDITIONS

BRUSH HOLDER SHOULD BE MANUFACTURED FROM ALUMINIUM PRESSURE DIE CASTING ALLOYS OF GRADES AL2 OR AL9 OF GOCT 2685-75 THE METHOD OF CASTING FOR AL2 IS PRESSURE DIE CASTINGS (A) AND FOR AL9 CHILL MOULD CASTING (K)

CHEMICAL COMPOSITION

GRADE OF ALLOYS	BASIC COMPONENTS%		ADMIXTURE % (MAX)													
	ALUMINIUM	MAGNESIUM	SILICON	MANGANESE	IRON	MAGNESIUM	MANGANESE	COPPER	ZINC	TIN	LEAD	TITANIUM	BERILLIUM	ZIRCONIUM	TOTAL OF CALCULATED ADMIXTURES	
					K	Д									K	Д
AL2	BASE	-	10-130	-	-	1.50	0.10	0.50	0.60	0.30	-	-	0.10	-	0.10	2.70
AL9	BASE	0.2-0.4	6-80	-	100	-	-	0.50	0.20	0.30	0.01	0.05	-	0.10	0.15	1.50

III MECHANICAL PROPERTIES OF GRADE AL2 Д AND GRADE AL9 KTS IS AS GIVEN BELOW

GROUP OF ALLOYS	GRADE OF ALLOYS	PARTIAL RESISTANCE kg/mm ²	SPECIFIC ELONGATION %	HARDNESS AS PER BRINELL MB
I	AL2 Д	16	1	50
I	AL9 K	21	2	60



15 HARDENING AND SHORT TIME (INCOMPLETE) ARTIFICIAL AGEING

SURFACE FINISH

- Rz 30/√ :- REPRESENTS THE SURFACE FINISH OF Rz VALUE 30 MICRONS ON THOSE SURFACES BY ANY PRODUCTION METHOD WHERE THE SURFACE FINISH IS NOT SPECIFIED
- Rz 40/ :- REPRESENTS THE SURFACE FINISH OF Rz VALUE OF 40 MICRONS
- Rz 20/ :- REPRESENTS THE SURFACE FINISH OF Rz VALUE OF 20 MICRONS

INSCRIBED		DRG NOT TO BE SCALED	PERTAINS TO
CHECKED		ALL SHARP EDGES & CORNERS TO BE ROUNDED OFF	
APPROVED		ALL DIMENSIONS ARE IN MM UNLESS OTHERWISE SPECIFIED	
DATE	12-11-91	BRUSH HOLDER	MB67-035
TOLERANCE UNLESS OTHERWISE SPECIFIED	GEN + DEC + ANG	SCALE :-	CONTROL OFFICE OF INSPECTION FIRE FIGHTING FOOT POSE

Восстановлен с подлинного чертежа
 Изд. № 4 (изм. № 2105)
 1994 (изм. № 1.1.79)

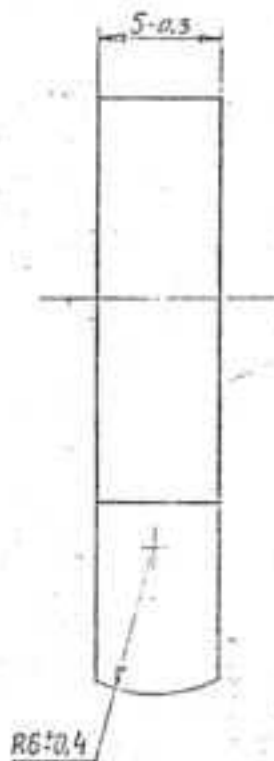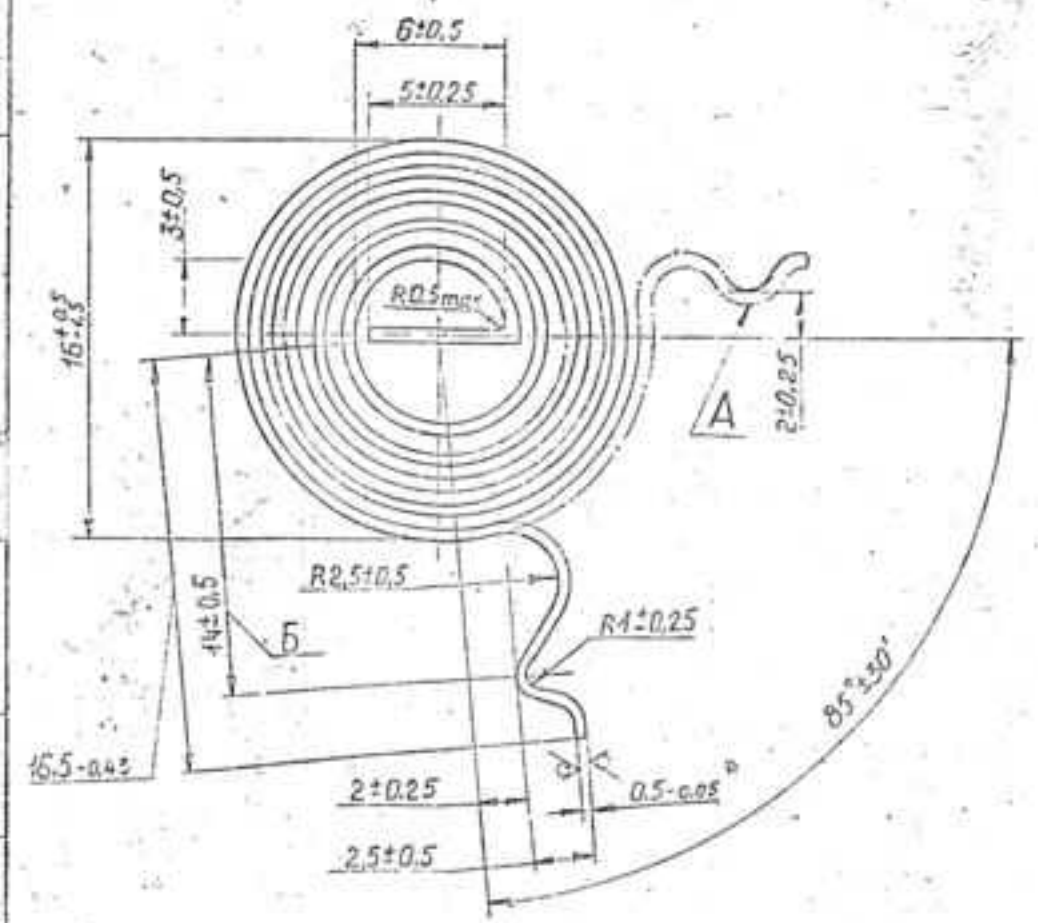

- HRA 72 to 75.
- Dimensions given with symbol (±) it given for reference.
- Number of working turns 5.
- Increase in the width of spring upto 6mm due to face projection of turns, as well as deviation from the face plane upto 1mm over dimension B are allowed.
- Torque angle can be changed depending on heat treatment of material during the coiling of springs.
- Touching of turns after heat treatment is not allowed.
- Pressure of spring 'A' at point 'A' should be 600-1000 kg.
- Coating varnish applied in varnish ΓΦ-95, GOST 8018-70.

Easy2Convert MB67-110

SHEETWEIGHT/SCALE: 10 3.7g 3:1

TOTAL SHEET: 1

www.easy2convert.com

Band Y84-L-0.5
ГОСТ 2283-69

DESIGNER	DATE	SCALE
DRW	12.11.99	3:1
CHECKED		
APPROVED		
DATE		
TOLERANCE UNLESS OTHERWISE SPECIFIED		
GEN	DEC	ANG

EXPLANATORY NOTES TO TECH. CONDITIONS.

SPRING SHOULD BE MANUFACTURED FROM COLD-DRAWN SPRING STEEL BARS WITH RESPECT TO THE SURFACE INTO LIGHT-IN DARK (C) WITH THICKNESS 0.5MM OF GRADE Y84 AS PER GOST 2283-69.

CHEMICAL COMPOSITION AS PER GOST 1435-74 (AS REFERRED IN GOST 2283-69)

- 1) CARBON % - 0.75 - 0.84
- 2) MANGANESE % - 0.15 - 0.30
- 3) SILICON % - 0.15 - 0.38
- 4) SULPHUR % - 0.025 MAX.
- 5) PHOSPHORUS % - 0.030 MAX.

MECHANICAL PROPERTIES AS PER GOST 2283-69

- 1) ULTIMATE TENSILE STRENGTH Kgf/mm^2 - 75 TO 120
- 2) THE TOTAL DEPTH OF SINGLE-SIDE DECARBONISING OF THE SHEET MUST NOT EXCEED - 0.02 mm.

COATING + PHYSICO - CHEMICAL AND ELECTRICAL PROPERTIES OF THE VARNISH ΓΦ-95 (ELECTRO-INSULATING, IMPREGNATING) OF GOST 8018-70 ARE GIVEN BELOW:

PROPERTIES	NORMS
1 PRESENCE OF MECHANICAL INCLUSIONS IN VARNISH	NIL
2 APPEARANCE OF VARNISH FILM	AFTER DRYING THE VARNISH SHOULD FORM A GLOSSY, HOMOGENEOUS AND SMOOTH FILM
3 VISCOSITY BY VISCOMETER B3-4 AT 20°C, IN SECS.	30 → 60
4 DRY RESIDUE CONTENT IN % NOT LESS THAN	45
5 ACID NUMBER IN MG OF KOH, NOT EXCEEDING	12

PROPERTIES	NORMS
6 DRYING TIME AT 105 - 110°C IN HOURS NOT EXCEEDING	2
7 THERMOELASTICITY OF FILM AT 150°C IN HOURS NOT LESS THAN	48
8 HARDNESS OF FILM BY PENDULUM TESTER AT 20°C NOT LESS THAN	0.40
9 OIL RESISTANCE OF FILM IN KG NOT LESS THAN	6
10 ELECTRICAL STRENGTH OF FILM IN KV/MM NOT LESS THAN	70
AT 20 ± 2°C	40
AT 120 ± 2°C	20
AFTER ACTION OF WATER FOR 24 HRS. AT 20 ± 2°C	
11 VOLUME RESISTIVITY OF FILM IN OHM CM NOT LESS THAN	1 · 10 ¹⁴
AT 20 ± 2°C	
AFTER ACTION OF WATER FOR 24 HRS. AT 20 ± 2°C	1 · 10 ¹²

SURFACE FINISH


1) R_{a16} SPECIFIED ROUGHNESS TO BE OBTAINED BY WITHOUT REMOVAL AT MATERIAL ON BOTH SIDE OF THE JOB

2) R_{z90} REPRESENTS SURFACE FINISH VALUE RZ 90 MICRONS ON THOSE SURFACES WHERE SURFACE FINISH IS NOT SPECIFIED.

INSCRIBED		DRG NOT TO BE SCALED	PERTAINS TO
CHECKED		ALL SHARP EDGES & CORNERS TO BE ROUNDED OFF	
APPROVED		ALL DIMENSIONS ARE IN MM UNLESS OTHERWISE SPECIFIED	MB67-110
DATE	12.11.99	SCALE -	
TOLERANCE UNLESS OTHERWISE SPECIFIED		SCALE -	
GEN	DEC	ANG	CONTROLLERATE OF INSPECTION FIRE FIGHTING EQPT PUNE

MB67-111-199W

Rz40
✓(✓)

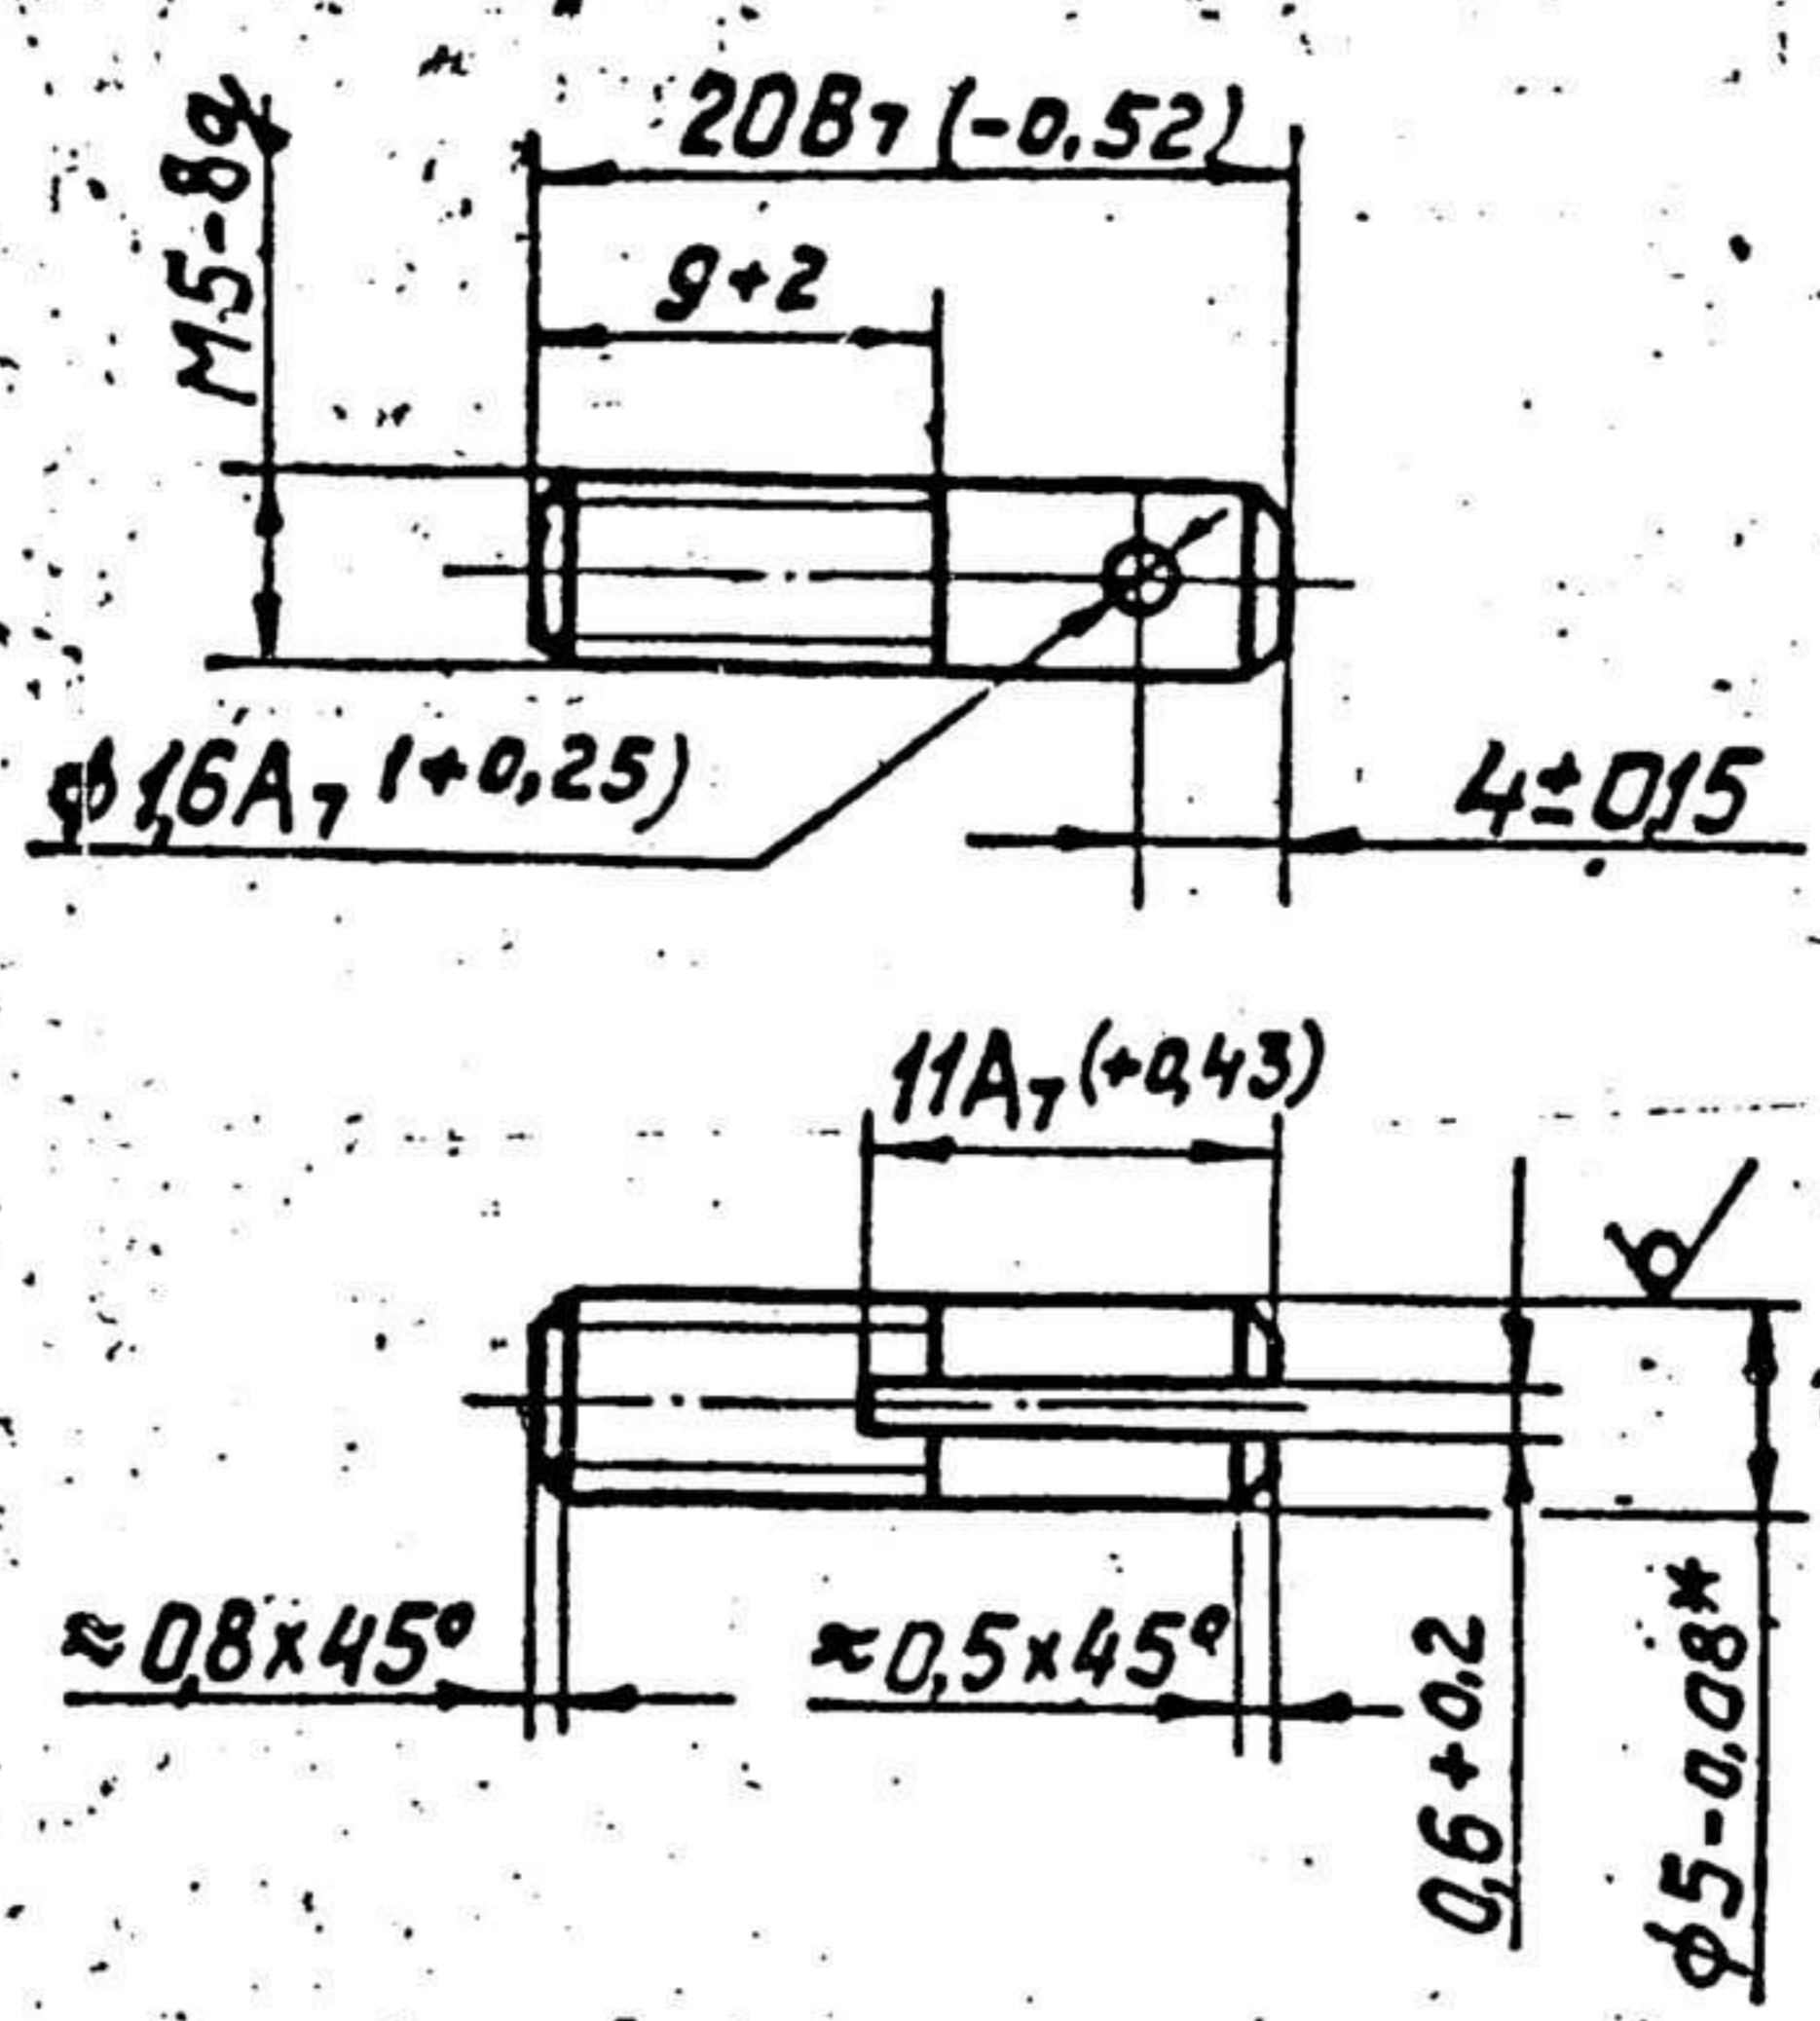

Designation	Coating
MB67-111	Zinc plating 6 followed by chromate treatment

TECHNICAL CONDITIONS

1. Size for reference.
2. The slot displacement relative to the axis should be within 0.4 mm.
3. Round off sharp edges: chamfer ≈0.3 mm x 45° or radius ≈0.3 mm.

REFER TO DRG NO 3425.038 FOR EXPLANATORY NOTES

(R. VEERARAGHAVAN)
SSO-II

78/D2073

APPROVED *[Signature]*

MB67-111

CHECKED. *[Signature]*

WEIGHT SCALE

CONTROLLERATE OF INSPECTION

SHAFT

3.1g 2:1

SHT SHTS. 1

ROUND BAR 5-4 DCT7417-75
A-12-H-B DCT1414-75

1-4-4

М867-021


Срощ. №

Получено в 2273

Мат. № дубл.

Мат. № дубл.

1853

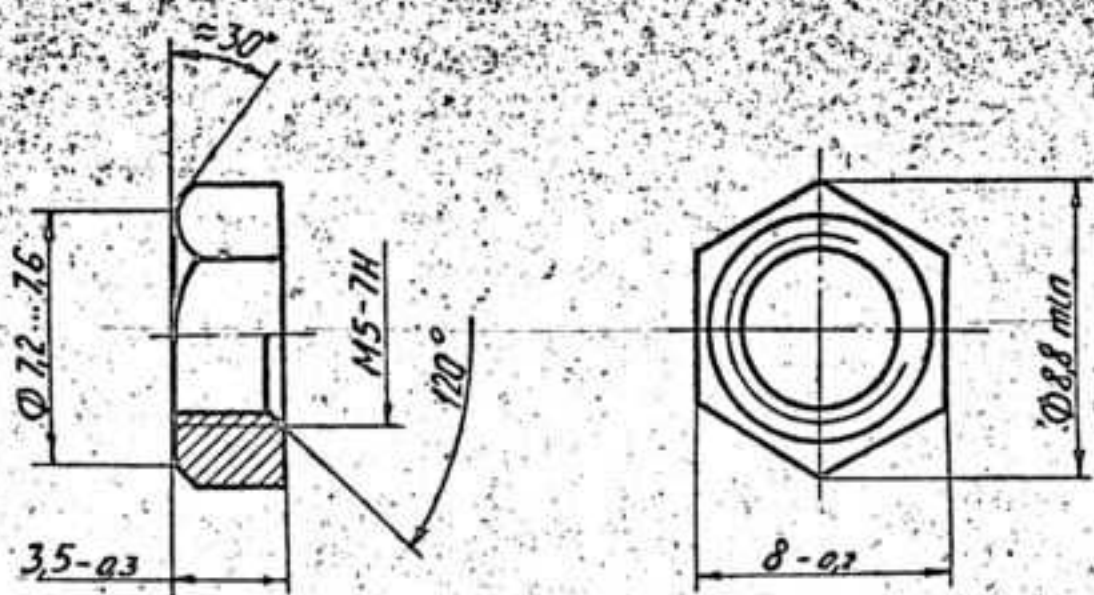

Designation	Coating
X2-4392	Zinc plating 6 followed by chromate treatment

TECHNICAL CONDITIONS

1. Tolerable displacement of hole axis relative to edges is within 0.4 mm.
2. Technical requirements as per ISCT 1759-70.

06/D2073

APPROVED	<i>[Signature]</i>	X2-4392	
CHECKED	<i>[Signature]</i>	WEIGHT	SCALE
		0.9g	5:1
		SHT	SHTS 1
		STEEL 10 ISCT 1050-74	

X2-4392

EXPLANATORY NOTES TO TECHNICAL CONDITIONS

(I) NUT, ~~SCREW~~, ~~WASHER~~ SHOULD BE MANUFACTURED FROM CARBON STRUCTURAL HOT ROLLED STEEL OF GRADE 10, OF Q0ST 1050-74. HAVING THE FOLLOWING CHEMICAL COMPOSITION.

STEEL OF GRADE	CONTENT OF ELEMENT%			
	CARBON	SILICON	MANGANESE	CHROMIUM (MAX)
10	0.07-0.14	0.17-0.37	0.35-0.65	0.15

(II) MECHANICAL PROPERTIES OF STEEL GRADE 10, OF Q0ST 1050-74 IS GIVEN BELOW.

HEAT TREATMENT OF BLANKS	NORMALISING
YIELD POINT	21 kgf/mm ² (MIN)
ULTIMATE TENSILE STRENGTH	34 kgf/mm ² (MIN)
PERCENTAGE ELONGATION	31% (MIN)
REDUCTION OF AREA	55% (MIN)

(III) THE RECOMMENDED HEATING TEMPERATURE DURING HEAT TREATMENT OF BLANKS, CARRYING OUT THE TESTS OF MECHANICAL PROPERTIES OF STEEL GRADE IS GIVEN BELOW.

STEEL GRADE	NORMALISING
10	920°C

RECOMMENDED MINIMUM HOLDING PERIOD IN NORMALISING - 30 MINUTES



(IV) SURFACE FINISH

Rz 80 REPRESENTS SURFACE FINISH TO BE OBTAINED BY ANY PRODUCTION METHOD IN Rz VALUE 80-11 MAX. ON THOSE SURFACES WHERE SURFACE FINISH IS NOT SPECIFIED.

INSCRIBED	<i>[Signature]</i>	DRG NOT TO BE SCALED ALL SHARP EDGES & CORNERS TO BE ROUNDED OFF.	PERTAINS TO
CHECKED	<i>[Signature]</i>		
APPROVED	<i>[Signature]</i>	ALL DIMENSIONS ARE IN MM UNLESS OTHERWISE SPECIFIED	X2-4392
DATE	5/11/80		
TOLERANCE UNLESS OTHERWISE SPECIFIED		SCALE:-	CONTROLLERATE OF INSPECTION FIRE FIGHTING DEPT PUNE
DC(I) DATE ZONE BRIEF RECORD SIGN	GEN DEC ANG		

X3-9675

Rz 80
✓M

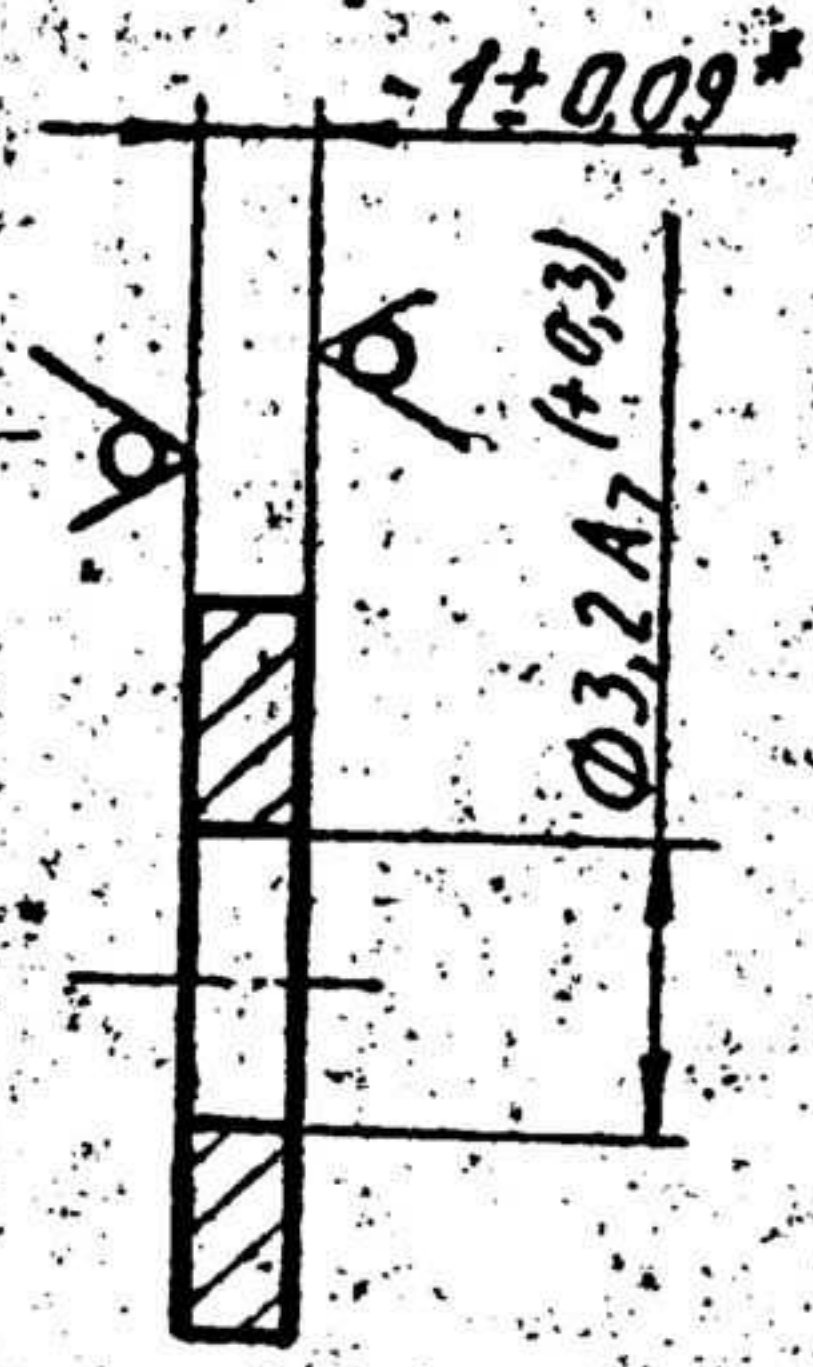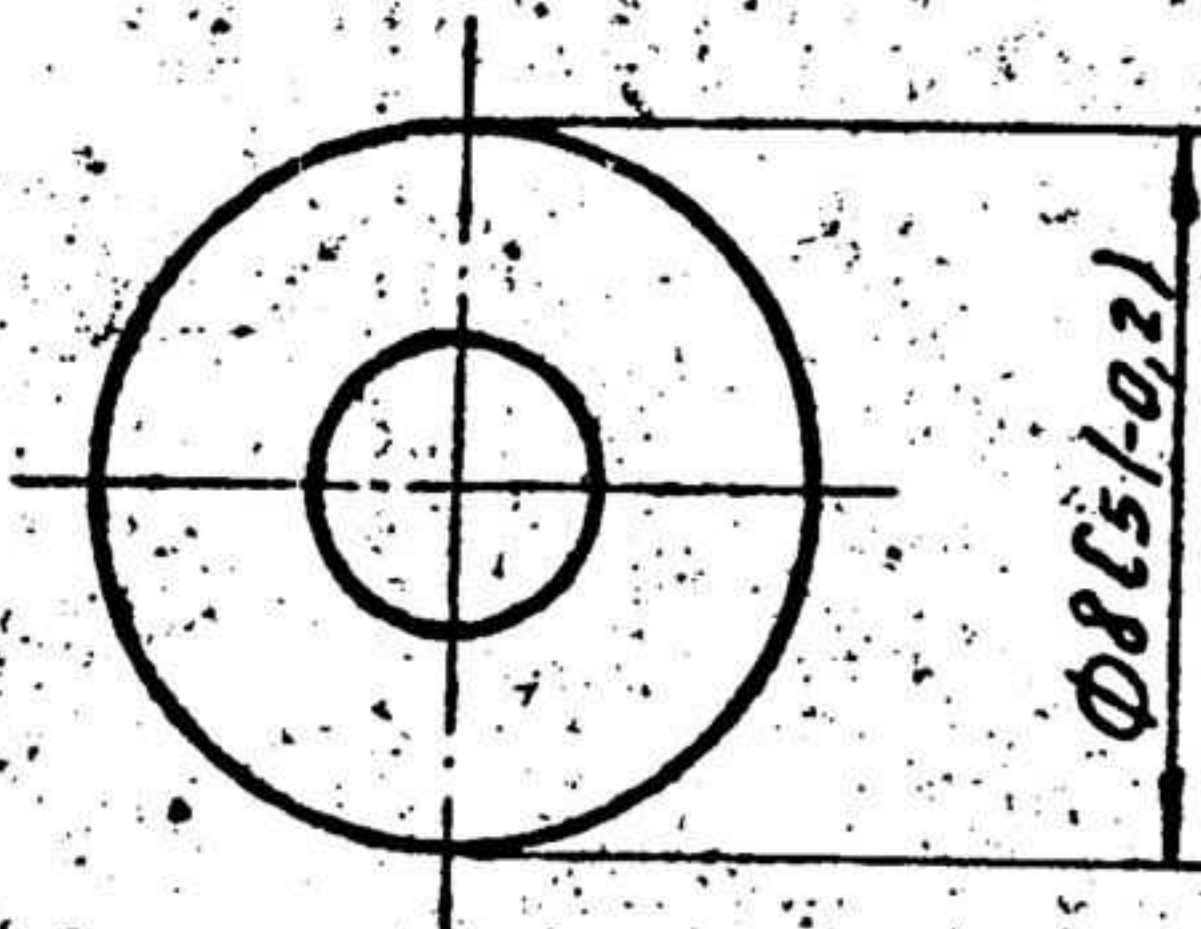

Designation	Coating
X3-9675	Zinc plating 6 followed by chromate treatment


1. [#]Size for reference.

REFER TO DRG NO 371 25.005 FOR EXPLANATORY NOTES.

SURFACE FINISH



REPRESENTS SURFACE FINISH TO BE OBTAINED BY WITHOUT REMOVAL OF MATERIAL ON BOTH SIDES OF THE JOB

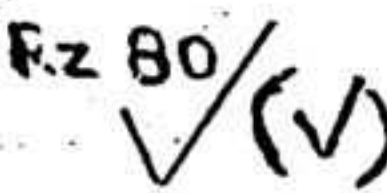

REPRESENTS SURFACE FINISH TO BE OBTAINED BY ANY PRODUCTION METHOD IN Rz VALUE 80 μm MAX, ON THOSE SURFACES WHERE SURFACE FINISH IS NOT SPECIFIED.

(R. VEERA RAGHAVAN)
SSO-II

97/D2073

APPROVED

[Signature]

X3-9675

CHECKED

[Signature]

CONTROLLERATE
OF
INSPECTION

WASHER

WEIGHT SCALE

0.6g 5:1

SHT SH'S 1.

SHEET 51 OCT 19904-74
4-II-10 OCT 16523-70


Easy2Convert
www.easy2convert.com 1-4-4

PUNE

X3-10323

Rz80/√

Designation	Coating
X3-10323	Zinc plating 6 followed by chromate treatment

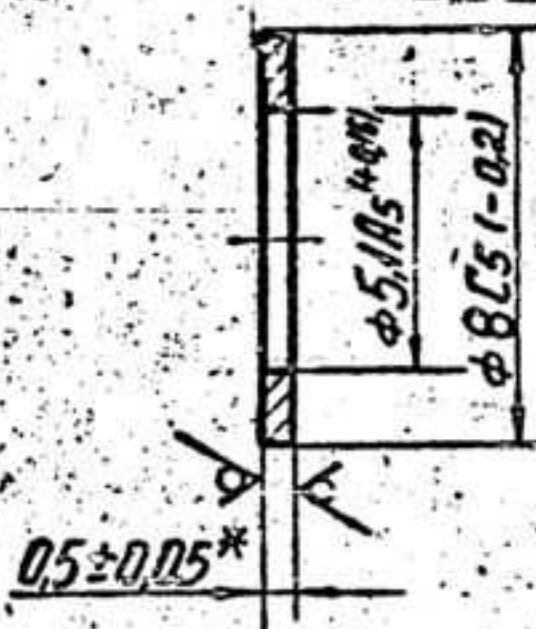

1. Material substitute: Band 10-M-HT-2-0,5 ГОСТ 503-71.
2. *Size for reference.

X3-10323
EXPLANATORY NOTES TO TECHNICAL CONDITIONS

WASHER SHOULD BE MANUFACTURED FROM COLD ROLLED QUALITY CARBON STEEL TO GRADE 10 OF SHEET 0.5 MM THICK WITH STANDARD ROLLING ACCURACY (B) CATEGORY 4, HIGH SURFACE FINISH (II) OR SHOULD BE MANUFACTURED FROM COLD ROLLED LOW CARBON STEEL BAND OF GRADE 10 SOFT (M), COLD WORKED WITH INCREASED MANUFACTURING ACCURACY IN THICKNESS (ND) AND SECOND GROUP SURFACE QUALITY WITH TRIMMED EDGE HAVING THE DIMENSIONS OF SIZE CHEMICAL COMPOSITIONS AND MECHANICAL PROPERTIES CONFORMING TO GOST 19904-74, GOST-16523-70, GOST-503-8) AND GOST 1050-74 AS GIVEN BELOW

(I) CHEMICAL COMPOSITION TO GOST 1050-74 (AS REFERRED IN GOST 16523-70 AND GOST 503-71)

CHEMICAL ELEMENTS %			
CARBON	SILICON	MANGANESE	CHROMIUM
0.07 - 0.14	0.17 - 0.37	0.35 - 0.65	0.15 (MAX)

(II) MECHANICAL PROPERTIES TO GOST 16523-70 AND GOST 503-71

GOST NO	TENSILE STRENGTH	RELATIVE ELONGATION
GOST 16523-70	30-42 kgf/mm ²	28% (MIN)
GOST 503-71	32-45 kgf/mm ²	17% (MIN)

SURFACE FINISH

√K - REPRESENTS SURFACE FINISH TO BE OBTAINED WITHOUT REMOVED OF MATERIAL ON THOSE BOTH SIDE OF JOB.


Rz80/√ - REPRESENTS SURFACE FINISH TO BE OBTAINED BY AMV PRODUCTION METHOD IN Rz VALUE OF 80 μ ON THOSE SURFACE WHERE SURFACE FINISH IS NOT SPECIFIED.

91/D2073

APPROVED <i>[Signature]</i>	X3-10323	
CHECKED <i>[Signature]</i>	WEIGHT	SCALE
	0.15g	5:1
	SHT	SHTS. 1
WASHER		
SHEET 50.5 ГОСТ 19904-74		
4-II-10 ГОСТ 16523-70		

INSCRIBED	DRG NOT TO BE SCALED	PERTAINS TO
CHECKED <i>[Signature]</i>	ALL SHARP EDGES & CORNERS TO BE ROUNDED OFF.	
APPROVED <i>[Signature]</i>	ALL DIMENSIONS ARE IN MM UNLESS OTHERWISE SPECIFIED	WASHER X3-10323
DATE 17.11.98		
TOLERANCE UNLESS OTHERWISE SPECIFIED	SCALE:-	
D. CO. DT. ZONE BRIEF RECORD SIGN GEN I DEC I ANG	CONTROLLERATE OF INSPECTION FIRE FIGHTING EOPF PUNE	

X3-10482

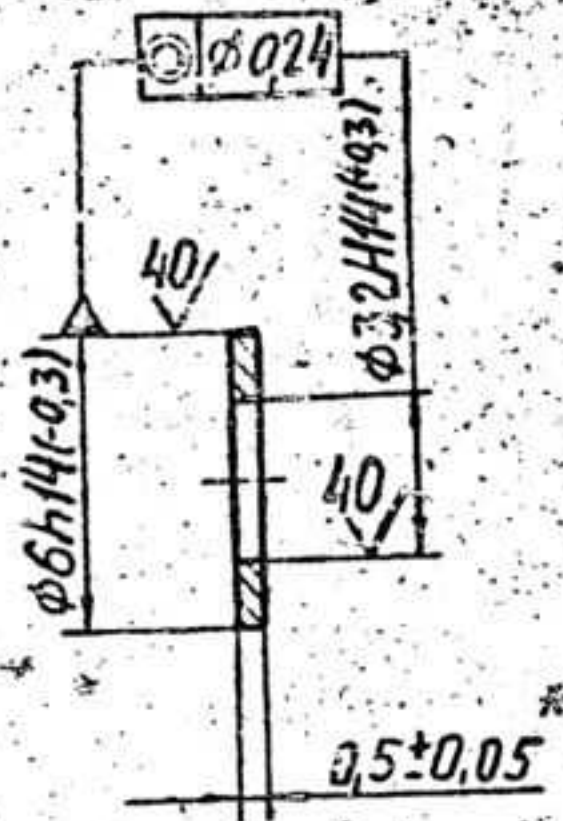

Designation	#	Coating
X3-10482	016	Zinc plating 6 followed by chromate treatment

TECHNICAL CONDITIONS

1. Material substitute: Band 08-M-HT-2-0,5 ГОСТ 503-71
2. *Size for reference.
4. Other technical requirements as per ГОСТ 18123-72.

92/D2073

APPROVED *[Signature]*
 CHECKED *[Signature]*

X3-10482
 WASHER 3-01
 ГОСТ 10450-78

WEIGHT	SCALE
0.079g	5:1
SHT	SHTS. 1

SHEET 50-5 ГОСТ 19904-74
 11-BF-0-8КП 9045-80

X3-10482

EXPLANATORY NOTES TO TECH CONDITIONS

WASHER SHOULD BE MANUFACTURED FROM COLD ROLLED THIN SHEET OUT OF LOW CARBON ALLOY STEEL OF HIGH SURFACE FINISH, EXTREMELY DEEP DRAWN OF GRADE 08 K1 TO GOST 9045-80.

(I) CHEMICAL COMPOSITION

CONTENT OF ELEMENTS %							
CARBON	MANGANESE	SULPHUR	PHOSPHORUS	SILICON	CHROMIUM	NICKEL	COPPER
0.10 (Max)	0.20 - 0.40	0.030 (Max)	0.025 (Max)	0.03 (Max)	0.10 (Max)	0.10 (Max)	0.15 (Max)

(II) MECHANICAL PROPERTIES

ULTIMATE STRENGTH, kgf/mm ²	RELATIVE ELONGATION %
26 - 37	28

(III) DEEP DRAWING TEST

DEPTH OF SPHERICAL INDENTATION NOT LESS THAN 9.0 mm.

(IV) SYMBOL

$\odot \phi 0.24$ CONCENTRICITY OF HOLE DIA 3.2 H14 TO BE WITHIN 0.24 mm WITH REFERENCE TO BASE.


(V) SURFACE FINISH

40° - REPRESENTS SURFACE FINISH TO BE OBTAINED BY ANY PRODUCTION METHOD IN Ra VALUE 40 μ MAXIMUM

$\nabla(\nabla)$ - REPRESENTS SURFACE FINISH TO BE OBTAINED WITHOUT REMOVAL OF MATERIAL, ON THOSE SURFACES WHERE SURFACE FINISH IS NOT SPECIFIED

					INSCRIBED	DRG NOT TO BE SCALED	PERTAINS TO
					<i>[Signature]</i>	ALL SHARP EDGES & CORNERS TO BE ROUNDED OFF.	X3-10482
					<i>[Signature]</i>		
					APPROVED <i>[Signature]</i>	ALL DIMENSIONS ARE IN MM UNLESS OTHERWISE SPECIFIED	WASHER 3-01 GOST 10450-78
					DATE <i>[Signature]</i>		
					TOLERANCE UNLESS OTHERWISE SPECIFIED	SCALE :-	CONTROLLERATE OF INSPECTION FIRE FIGHTING EQPT PUNE.
					GEN DEC ANG		
DCC(I)	DATE	ZONE	BRIEF RECORD	SIGN			
4				3			

See table

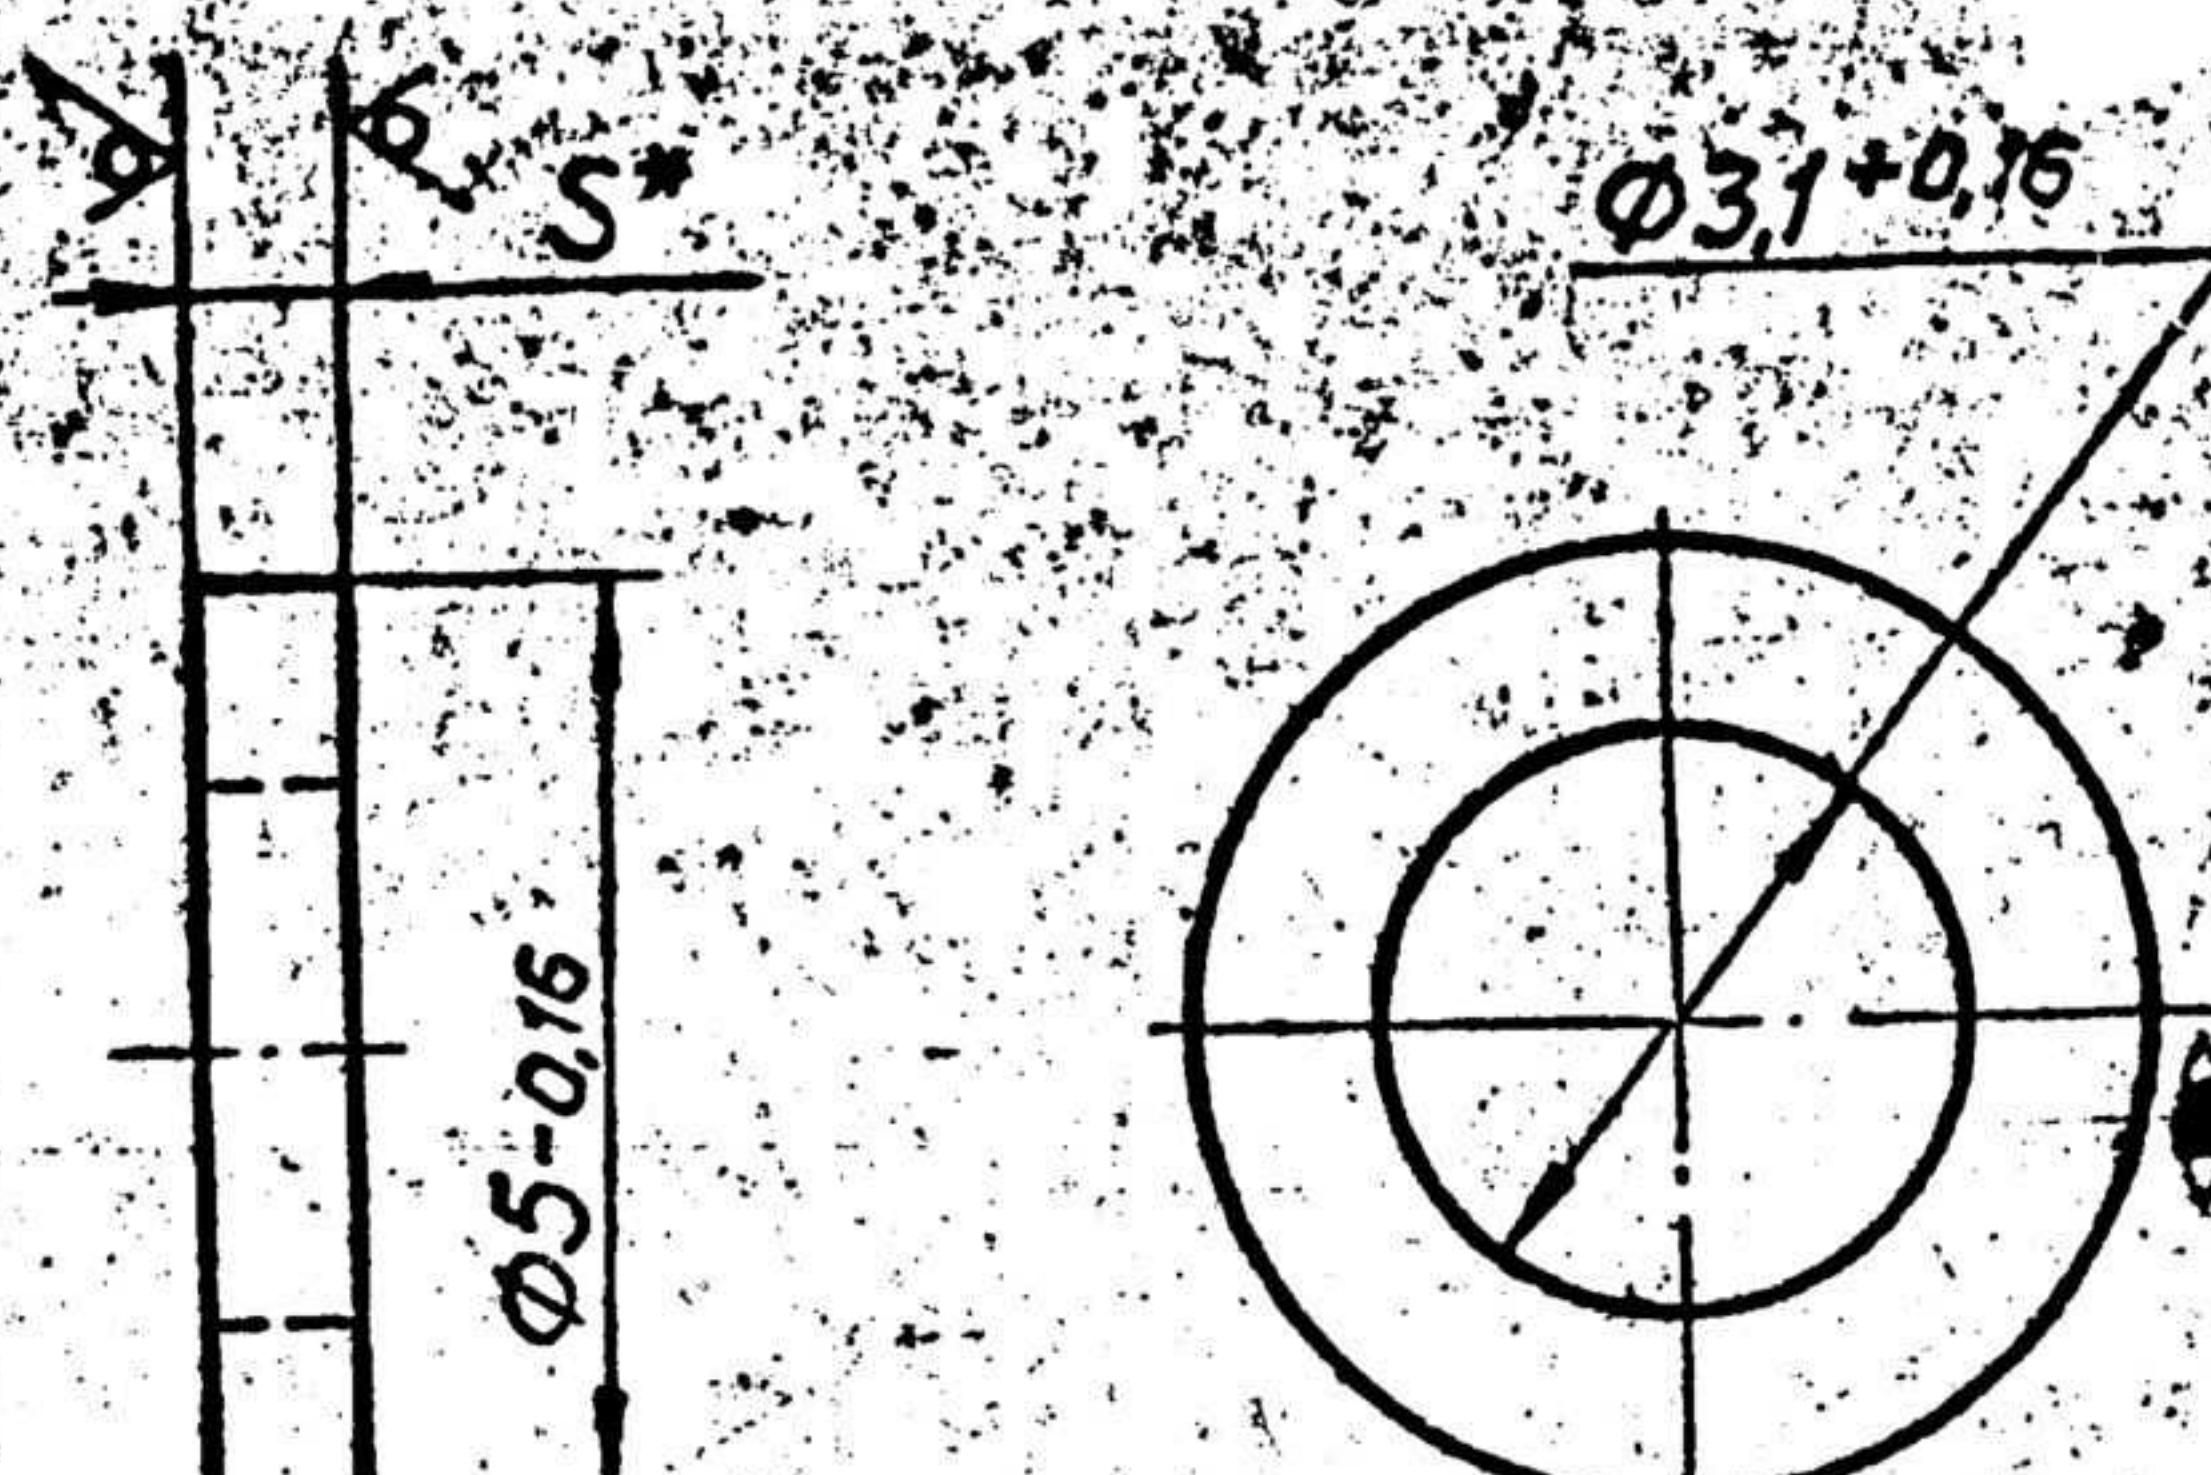

Designation	S [#]	Material	Coating	Material substitute	Mass, kg	Rz ✓
X5-29-48						
X5-29-48-01	0.5±0.15	Glass-cloth base laminate CT-I-0,5 ГOCT 12652-74	Varnish ГФ-95(1) ГOCT 8018-70	Glass-cloth-base laminate CT3Ф-1-0,5 ГOCT 12652-74	0.01	320

TECHNICAL CONDITIONS

- (3) 1. [#]Size for reference.
- 2. Varnish MI-92(1) ГOCT 15865-70 may be also used.

REFER TO DRG NO 3A 25.003 FOR EXPLANATORY NOTES
SURFACE FINISH

OK INDICATES REMOVAL OF MATERIAL IS NOT PERMITTED ON BOTH SIDE OF THE JOB

(Signature)
 (R. VEERA RAGHAVAN)
 SSO-II

84/D2073


APPROVED *(Signature)*
CHECKED. *(Signature)*
CONTROLLERATE OF INSPECTION

X5-29-48
 INSULATING WASHER
 SEE TABLE

	WEIGHT	SCALE
	SEE TABLE	10:1
SHT	SHTS. 1	

FE () NAME

1-4-4

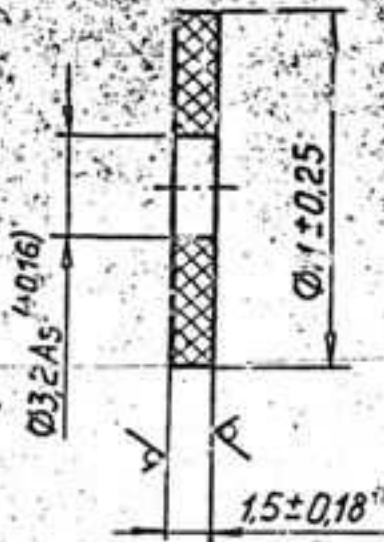

Designation	Material	Material substitute	Coating
X5-114-53-01	Glass-cloth-base laminate CT-T-1,5 FOCT 12652-74		

TECHNICAL CONDITIONS

- Size for reference.
- Varnish M7-92(1) FOCT 15865-70 may be also used.

96/D2073

APPROVED <i>[Signature]</i>	X5-114-53	
CHECKED <i>[Signature]</i>	WASHER	SEE TABLE
	WEIGHT (1.17g)	SCALE (5:1)
	SHT	SHTS. 1

ES 711 SX

EXPLANATORY NOTES TO TECHNICAL CONDITIONS

- WASHER SHOULD BE MADE FROM GLASS TEXTOLITE OF GRADE CT-I-1 OF THICKNESS 1.5 M.M. AS PER GOST 12652-74. HAVING THE TECHNICAL REQUIREMENTS AS FOLLOWS:
 - ELECTRICAL QUALITY TEXTOLITE SHEET IS A PRESSED MATERIAL CONSISTING OF TWO OR MORE LAYERS OF GLASS FIBRE CLOTH IMPREGNATED WITH THERMOACTIVE RESIN.
 - GLASS TEXTOLITE OF THICKNESS UP TO 2.0 M.M. IN THE HEATED CONDITION MUST BE SUITABLE FOR STAMPING OPERATION.
- GLASS TEXTOLITE OF GRADE CT-1-1.5 HAVING THE PHYSICAL MECHANICAL AND ELECTRICAL REQUIREMENTS AS PER GOST 12652-74.
 - DENSITY — 1.60 — 1.90 g/cm³
 - RESISTANCE TO SHORT-DURATION HEATING — 200 OHM (MINIMUM)
 - RESISTANCE TO ACTION OF OIL — IN TRANSFORMER OIL FOR 4 HOURS AT NOT LESS THAN 130°C
 - WATER ABSORPTION NOT MORE THAN -1%
 - SURFACE RESISTIVITY, OHMS, NOT LESS THAN 1x10¹³ AT RELATIVE HUMIDITY 45 TO 75% AND 15 TO 35°C
 - 1x10¹² AFTER SOAKING FOR 24 HOURS IN A HUMIDITY CHAMBER AT RELATIVE HUMIDITY OF 95±2% AND 20±2°C
 - VOLUME RESISTIVITY, OHM.CM NOT LESS THAN 1x10¹³ AT RELATIVE HUMIDITY OF 45 TO 75% AND 15 TO 35°C
 - 1x10¹² AFTER SOAKING FOR 24 HOURS IN A HUMIDITY CHAMBER AT RELATIVE HUMIDITY OF 95±2% AND 20±2°C
 - DISSIPATION FACTOR AT 50 HZ A RELATIVE HUMIDITY 45 TO 75% AND 15 TO 35°C — 0.03 (MAXIMUM)
 - DIELECTRIC STRENGTH PERPENDICULAR TO THE LAYERS AT 50 HZ IN TRANSFORMER OIL AT 90±7°C — 27 KVEFT (MINIMUM)

REF NO - 2

- PHYSICO-CHEMICAL PROPERTIES OF THE VARNISH GRADE M7-92 AS PER GOST 15865-70 ARE AS FOLLOWS:
 - VISCOSITY AS PER VISCOSIMETER B3-4 AT 20°C IN SEC } 25 MINIMUM
 - CONTENT OF DRY-RESIDUE IN % — 50 — 55
 - ACID NO IS MG OF KOH — 10 (MAXIMUM)
 - CONTENT OF SEPERATE FORMALDEHYDE IN % } 0.6 (MAXIMUM)
 - TIME OF DESICCATION AT 105-110°C IN HRS } -1 (MAXIMUM)
 - DRYING - CAPACITY OF VARNISH IN THICK-LAYER AT 115-120°C IN HRS } -16 (MAXIMUM)
 - THERMO ELASTICITY OF LAYER AT 150°C IN HRS } -48 (MINIMUM)
 - HARDNESS OF LAYER AS PER PENDULUM INSTRUMENT AT 20±1°C } -0.40 (MINIMUM)
 - OIL-RESISTANCE OF FILM IN KG — 8 (MINIMUM)
 - ELECTRICAL STRENGTH OF FILM IN K VOLT/MM AT 20±2°C AFTER THE ACTION OF WATER FOR A PERIOD OF 24 HRS AT 20±2°C } -55 MINIMUM } -30

- SPECIFIC - VOLUMERIC ELECTRIC RESISTANCE OF FILM IN CM } 1·10¹⁴ (MINIMUM)
- AFTER THE ACTION OF WATER FOR A PERIOD OF 24 HRS AT 20±2°C } 5·10¹²

SURFACE FINISH

[Symbol] :- REPRESENT SURFACE FINISH TO BE OBTAINED BY WITHOUT REMOVAL OF MATERIA ON BOTH SIDE OF JOB.

Rz 80/√ :- REPRESENTS Rz VALUE OF SURFACE FINISH OF 80 MICRONS ON THOSE SURFACES WHERE SURFACE FINISH IS NOT SPECIFIED

Easy2Convert
www.easy2convert.com

						INSCRIBED	DRG NOT TO BE SCALED	PERTAINS TO
						CHECKED <i>[Signature]</i>	ALL SHARP EDGES & CORNERS TO BE ROUNDED OFF	
						APPROVED <i>[Signature]</i>	ALL DIMENSION ARE IN MM UNLESS OTHERWISE SPECIFIED	
						DATE 17.11.21	WASHER	X5-114-53
						TOLERANCE UNLESS OTHERWISE SPECIFIED	SCALE :-	
						GENI DEC ANG	CONTROLLERATE OF INSPECTION FIRE FIGHTING EDPT PUNE	