



BLANK FOR BENDING

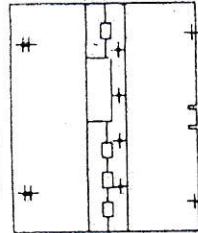

DWG NO: 640-08-1070-1
BASE FOR SEATING
(FRONT, LHS)
QTY/REQ: 1 NO.

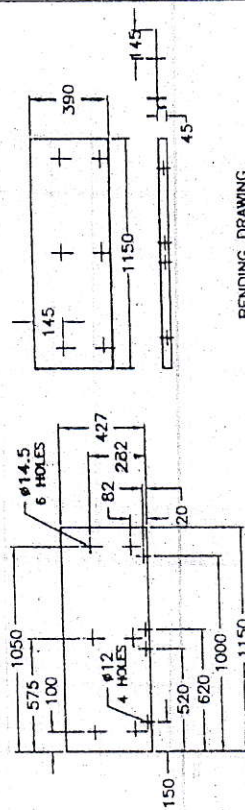

DWG NO: 640-08-1052-1
TOP PLATE QTY/ASSY: 1 NO.


Technical drawing of a rectangular plate. The drawing shows a rectangle with a horizontal dimension of 1150 and a vertical dimension of 25. The dimensions are indicated by dimension lines with arrows and numerical values.

DWG NO: 640-08-1055-1
STRIP
QTY/VEH: 1 NO.

DWG NO: 640-08-1056-1
HANDLE
QTY/ASSY: 1 NO.
MTL: 66mm M.S.ROD-IS:172

LENGTH OF THE OPENED ROD 215mm

BLANK DRAWING

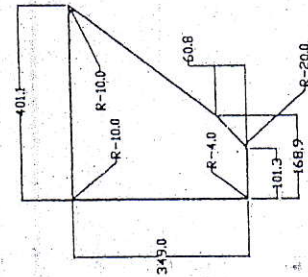

DWG NO: 640-08-1053-1
SIDE PLATE
QTY/ASSY: 2 NOS.

DWG NO: 640-08-1054-1
MIDDLE PLATE
QTY/ASSY: 2 NOS.

NOTE:

1. ALL DIMENSIONS ARE IN mm.
2. UNSPECIFIED LIMIT DEVIATIONS ON LINEAR DIMENSIONS ARE ± 1 mm.
3. COMPLETE ASSY IS A WELDED STRUCTURE.
4. COATING : TWO COATS OF OLIVE GREEN PAINTING OVER ONE COAT OF RED-OXIDE COATING.

NOT SAMPLE TO BE APPROVED BEFORE BULK SUPPLY.

NOTE: DRG NO: 2658-57-31 FOR LOGS
REFER TO DIVISION BKT.
~~B~~ TWM/DDC

~~B FUM/00C~~

二二〇

2

7001

UNION OF THE MOUNTAINS

WILLIAM. F. FITE, JR.

08-1052-1 DUMAS 520 520 W

0-08-1051-1 D.M.H.S 430, 460

SY. BOSS & BOLT ARE NEWLY F...

GREEN: COATING INTRODUCED IN

NATURE OF AMENDMENT	DATE	BY	REASON
1. Addition of new section 101	10/15/2023	John Doe	Clarification of existing law
2. Amendment to section 102	10/20/2023	Jane Smith	Correction of typo
3. Deletion of section 103	10/25/2023	John Doe	Redundant provision
4. Addition of new section 104	10/30/2023	Jane Smith	New regulatory requirement
5. Amendment to section 105	11/05/2023	John Doe	Update to reflect current standards
6. Deletion of section 106	11/10/2023	Jane Smith	Outdated provision
7. Addition of new section 107	11/15/2023	John Doe	New regulatory requirement

DRG. NO: 640-01

040-01

--	--

SEAT BASE	
-----------	--

DATE	(FRONT)	15
------	---------	----


FILE

(ARMY & M.H.)

--	--

MATERIAL: 4mm THIC


St42-IS:10

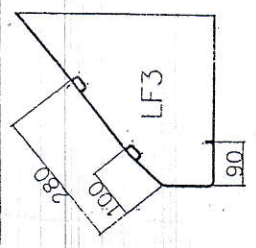


VIEW: C-C

NOTE:

1. ALL DIMENSIONS ARE IN MM.
2. UNSPECIFIED LIMIT DEVIATIONS ARE ± 1 mm.

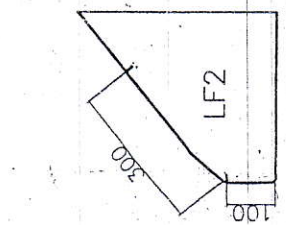[illegible]

VIEW: B-B

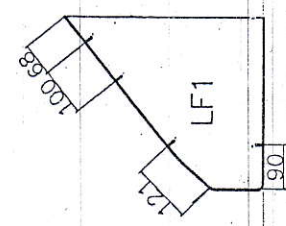

VIEW: A-A

LOCATION OF CLAMPING BRKT.
MODIFICATION INCORPORATED IN VEH. HULL 532-
4 FOUND SATISFACTORY

As done 281115
CBA-COFVJAE