
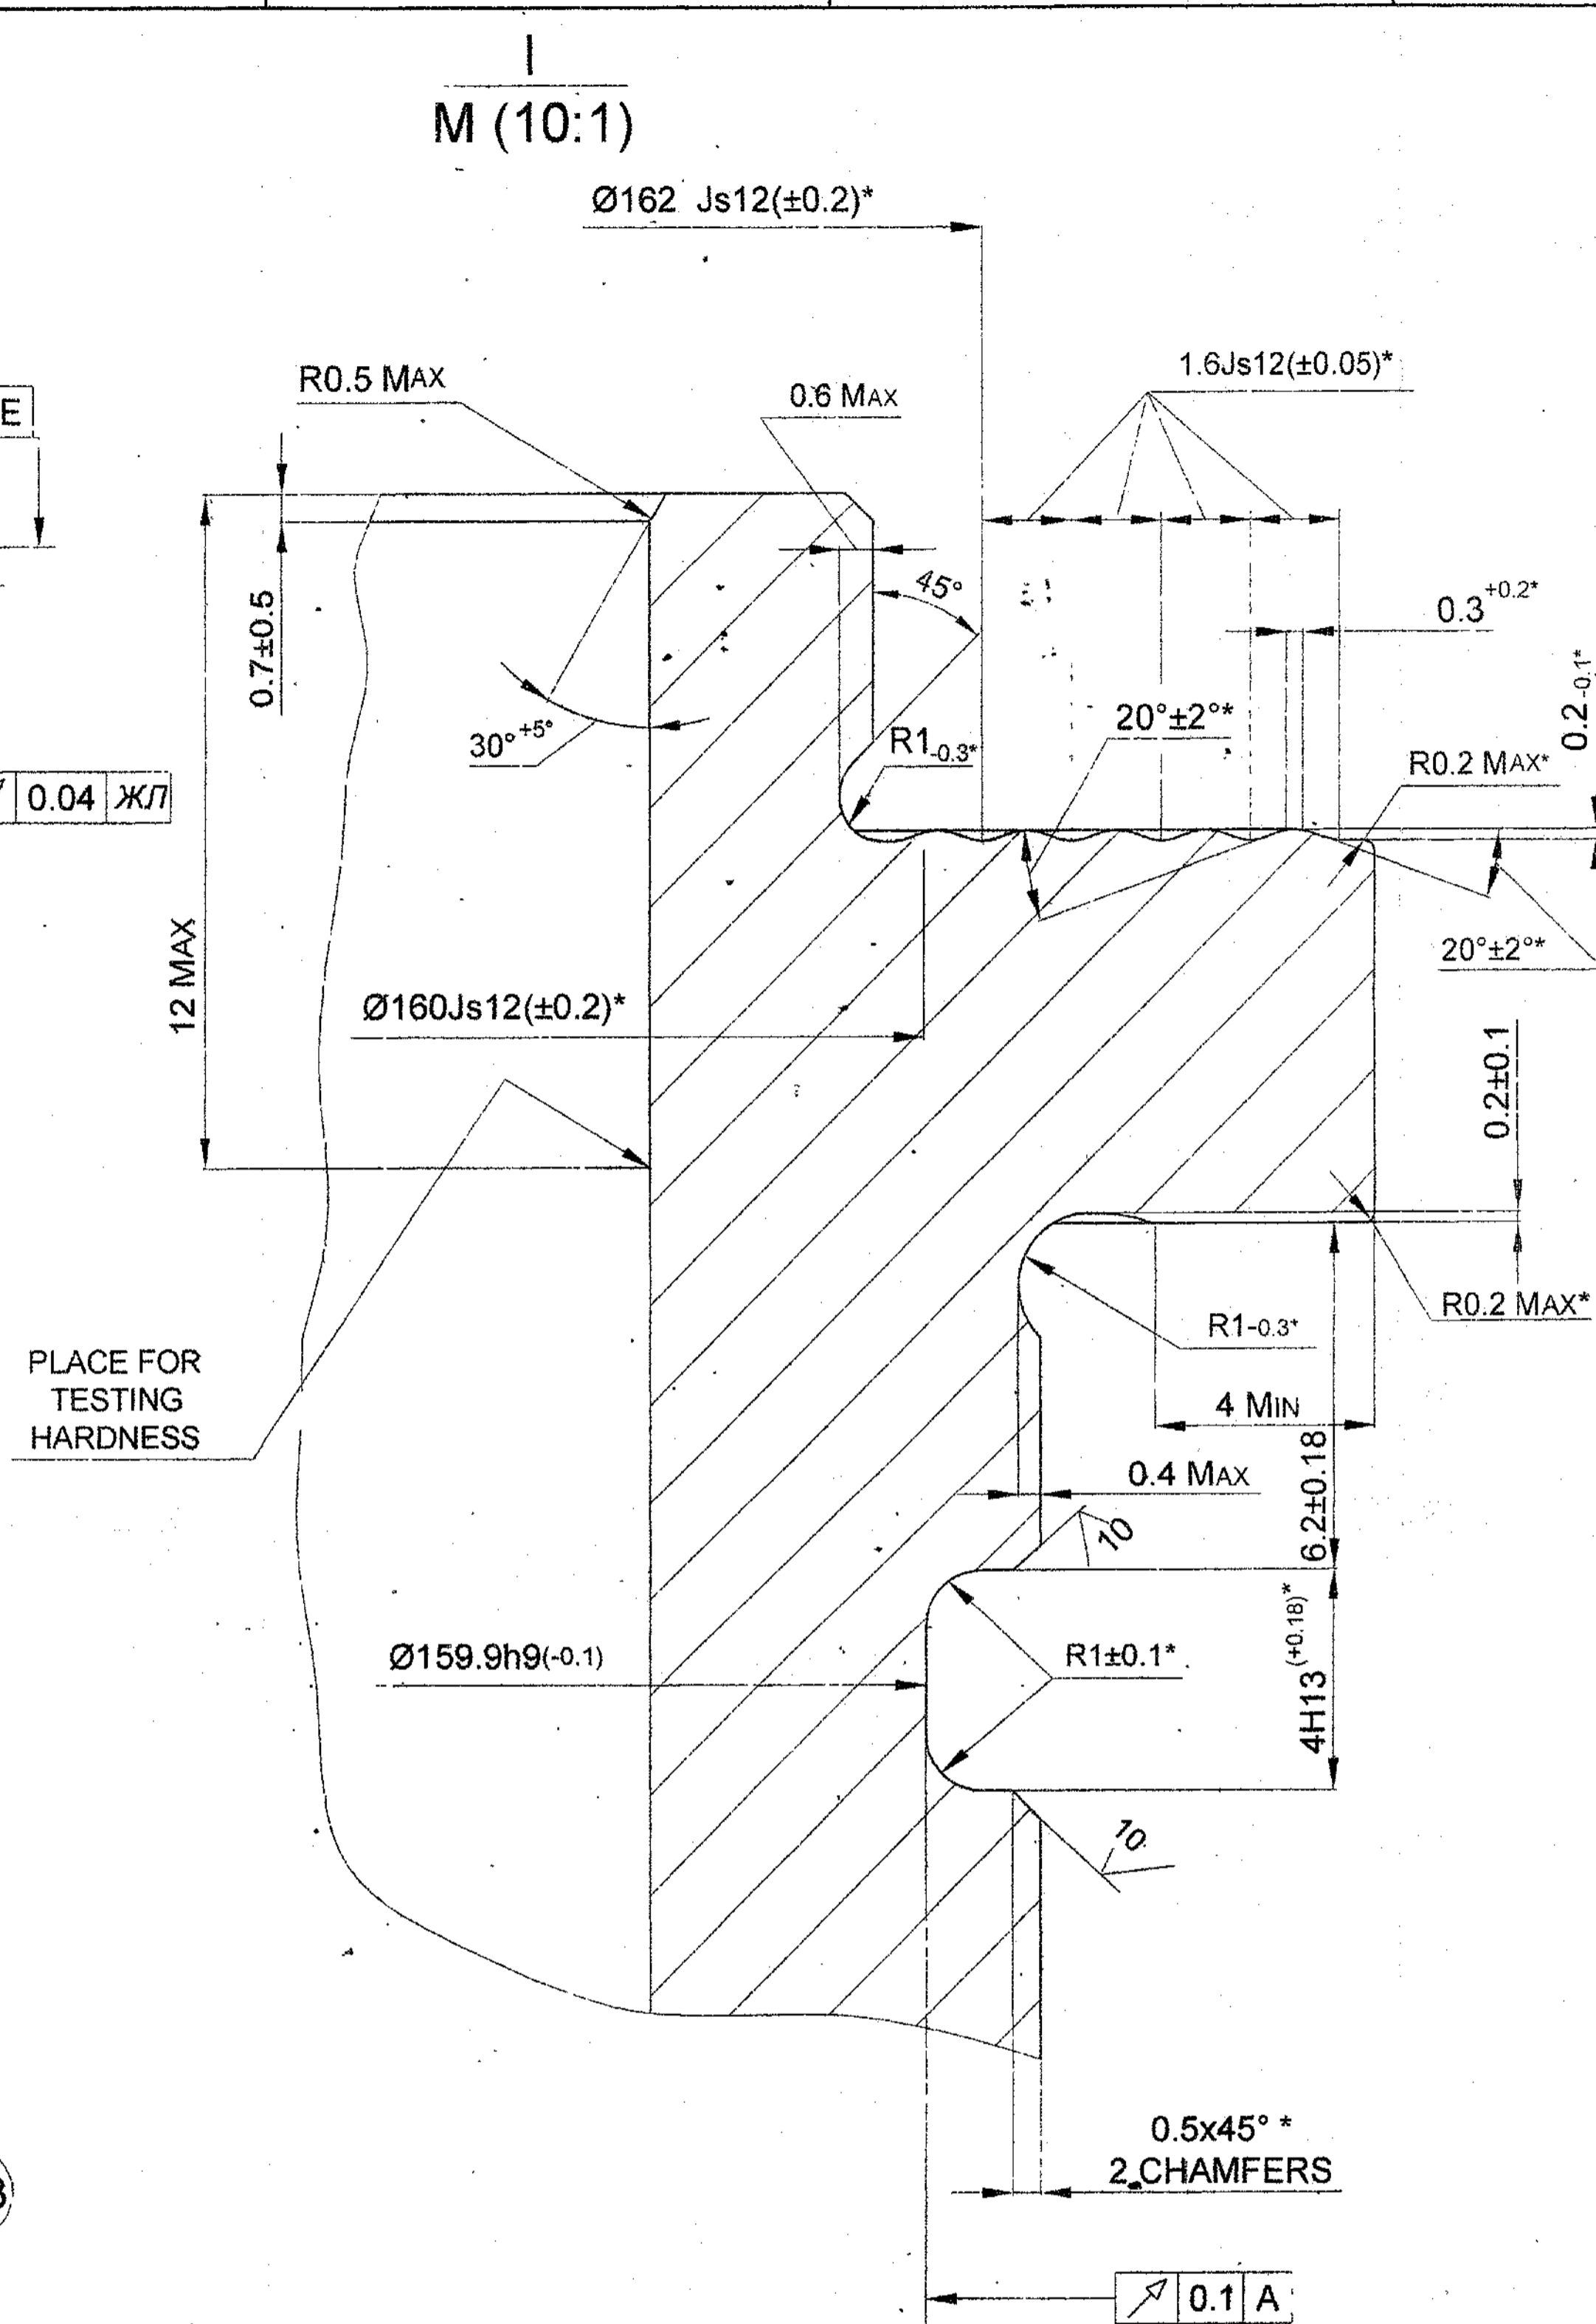


1. Поверхностные дефекты (вмятины, забоины, следы от скалывания) в зонах высадки глубиной не более 0,5 фактического припуска.
 2. Металлургические дефекты на поверхностях, не подвергавшихся высадке, согласно ТУ по поставке труб.
 3. Металлургические дефекты выточке не подлежат.
 4. Смещение по плоскости разреза штампоб не более 10 мм.
 5. Допускается заусенец по линии разреза штампа и торцовый по $\phi 142$ не более 2 мм, торцовый по $\phi 181$ - не более 7 мм.
 6. На поверхности Б допускается задаточный заусенец (контролировать 2% проточки).
 7. Внутри трубы, в местах А и Б, допускается кацезой наплыв.
 8. Поковки маркировать условным №ковки, а сдача производится не поплавокно.
 9. Поковки сдавать вместе со свидетелями в количестве: 2 свидетеля на 300 штук. В качестве свидетеля должны направляться отрезки труб длиной не менее 200 мм.
 10. Допускается поставка свидетелей в разрезе месячной программы.
1. Термообработать на твердость согласно чертежу детали.

303-07-22
~~20-01-50-1~~
 Поковки
 (Гильза)
 38X2M10A
 ТУ 14-3-579-76


1. SURFACE DEFECTS (DENTS, NICKS, SCALE MARKS) IN THE UPSETTING AREAS SHOULD BE TO A DEPTH OF NOT MORE THAN 0.5 OF ACTUAL ALLOWANCE.
2. METALLURGICAL DEFECTS ON THE SURFACES, NOT SUBJECTED TO UPSETTING, ARE IN ACCORDANCE WITH TY 14-3-579-76 FOR THE SUPPLY OF PIPES.
3. METALLURGICAL DEFECTS ARE NOT SUBJECTED FOR TURNING OPERATION.
4. SHIFT ALONG THE DIE FLASH PLANE SHOULD NOT EXCEED 10 mm.
5. FIN ALONG THE DIE FLASH LINE AND END FACE FIN ALONG $\phi 168$ NOT EXCEEDING 2 mm, END FACE FIN ALONG $\phi 181$ - 7 mm MAX. ARE ALLOWED.
6. FORGED FIN (2% WITH THE RECESS TO BE CHECKED) IS ALLOWED ON THE SURFACE B.
7. RING FLASH ROLL IS ALLOWED INSIDE THE PIPE AND AT THE PLACES OF A AND B.
8. FORGINGS ARE TO BE MARKED WITH THE CONVENTIONAL HEAT NO. & TO BE ACCEPTED IRRESPECTIVE OF HEAT NO.
9. FORGINGS ARE TO BE SUPPLIED TOGETHER WITH TEST PIECES: 2 TEST PIECES FOR 300 PIECES. PIPE CUT TO A LENGTH OF 200 mm MIN SHOULD BE DESPATCHED AS TEST PIECE.
10. TEST PIECES CAN BE SUPPLIED AS PER MONTHLY SCHEDULE.
11. TO BE HEAT TREATED FOR HARDNESS - HB 255-302 IN ACCORDANCE WITH THE COMPONENT DRAWING 303-07-22.

ISSUE	DATE	REFERENCE	LETTERS	MASS
①	8	MINIMUM IS 139-2.8 MINIMUM IS 139-2.8 MINIMUM IS 139-2.8 ADDED	APPROVED B.K.SARAI CHECKED GKM DRAWN AR.BURMAN	16.32 Kg
303-07-22			CYLINDER LINER	
			(FORGING FROM PRESS OF CAPACITY 1250T)	
			STEEL 38X2M10A	
			TY 14-3-579-76	

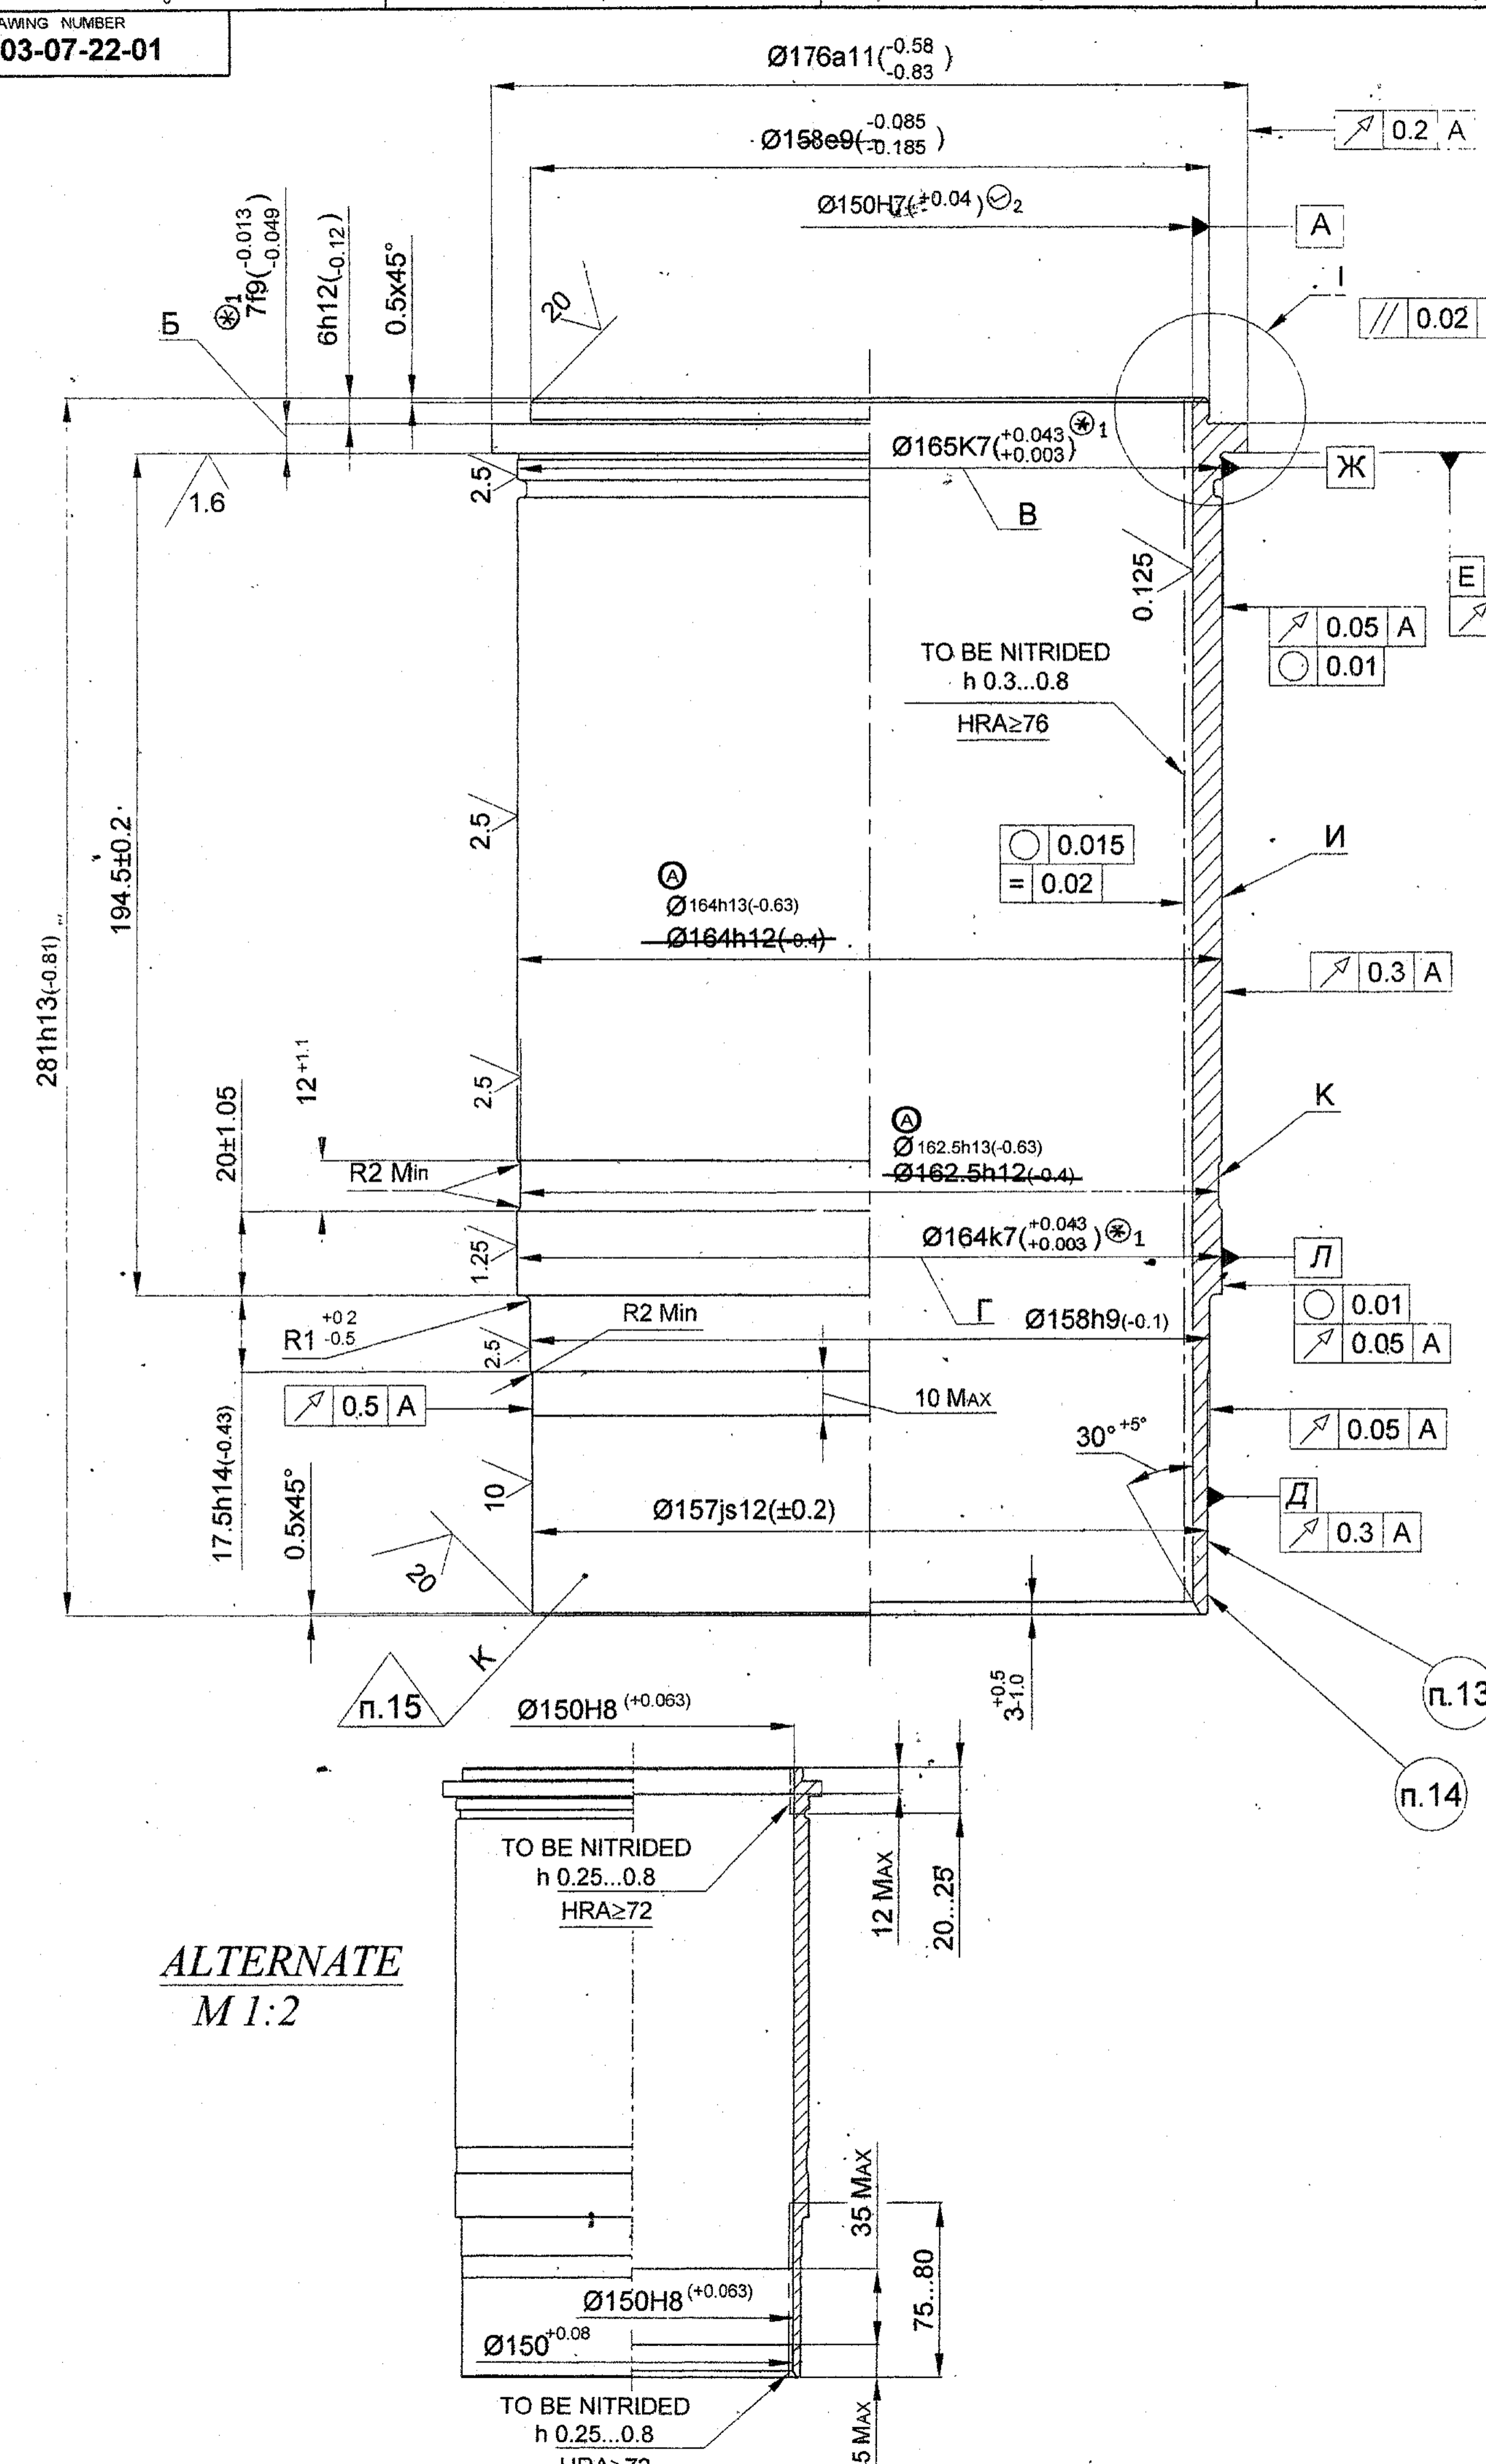

1. Inspection group II as per TT-11.
2. 255...302 HB; Minimum 10% of components to be checked at random from every heat-treated batch.
3. After final heat treatment, the components are accepted according to TTM-84-84.
4. Coating of surfaces 'I' and 'K' with Milky chromium plating 15...30 and hydrogen embrittlement to be removed.
5. Nitriding layer on upper and lower chamfers of surface 'A' is allowed.
6. Following is allowed on the surface A:
 - a). Micro flaw (Non metallic inclusions) by flushing the nitrided layer with nitrogen around them, detected on surface as thin, dark lines, visible with naked eye.
 - b). Hairlines, occurred along the fibres, to a length up to 5mm to a maximum 5 nos on liner, hairlines to a width up to 10 mm. It is allowed to have Maximum 2 nos on band among themselves for minimum 100 mm and from upper end face minimum 75mm.
7. Marks of maximum 2 numbers to a depth upto 0.3 mm are allowed on surface 'D'.
8. Forging defects, breaking of nitriding layer and corrosion marks are not allowed.
9. Cracks are not allowed.
10. Deviation of surface plane 'E' to be checked by bluing, the imprint should be uniform along the circumference, having a width of minimum 1.8 mm around the circular surface.
11. In the bottom part of surface A for a width of 8mm for an arc length of 1/3 rd of circle direction of roughness area that does not coincide with the direction of area of the remaining surface is allowed.
12. Dimension to be ensured by tool.
13. To be marked with electrograph or with die as per ИЛ-581-85 solution No3 designation 303-07-22-01 and absolute value of dimensions 'B' and 'Г', rounded up to 0.01 mm. Letter type as per ПО-6 GOST 2930-62.
14. To be marked with electrograph or with die as per ИЛ-581-85 solution No.3 the minimum value of dimension 'B' rounded to 0.01 mm. Letter type as per ПО-6 GOST 2930-62.
15. To be stamped with electrograph or die as per ИЛ-581-85 solution No.3, Letter type as per ПО-6 GOST 2930-62.
16. It is allowed to inspect the allowance for roundness and the profile of longitudinal section by measuring the ovality and conicity.
17. Variation of values of alignment of surfaces 'Ж' and 'Л' relative to the surface 'A' while measuring from one plane should not exceed 0.03 mm.
18. Surface 'I' and 'K' to be nitrided h 0.3...0.8 mm. HRA ≥ 76, instead of Milky chromium plating 15...30 is allowed. Surfaces 'Ж' and 'Л' to be nitrided h 0.2...0.55 mm is allowed.
19. Repair size dimensions are added based on letter no. 82847/0H/QAD/ED dated 26 Dec 94 Appendix -A'. Repair size dimensions to be stamped with electrograph or dye as per ИЛ-16-73 solution N3. From the bottom 25mm of outside diameter, mark repair sizes R₁, R₂, OS₁, OS₂ and OS₃ respectively.

ALTERNATE
M 1:2

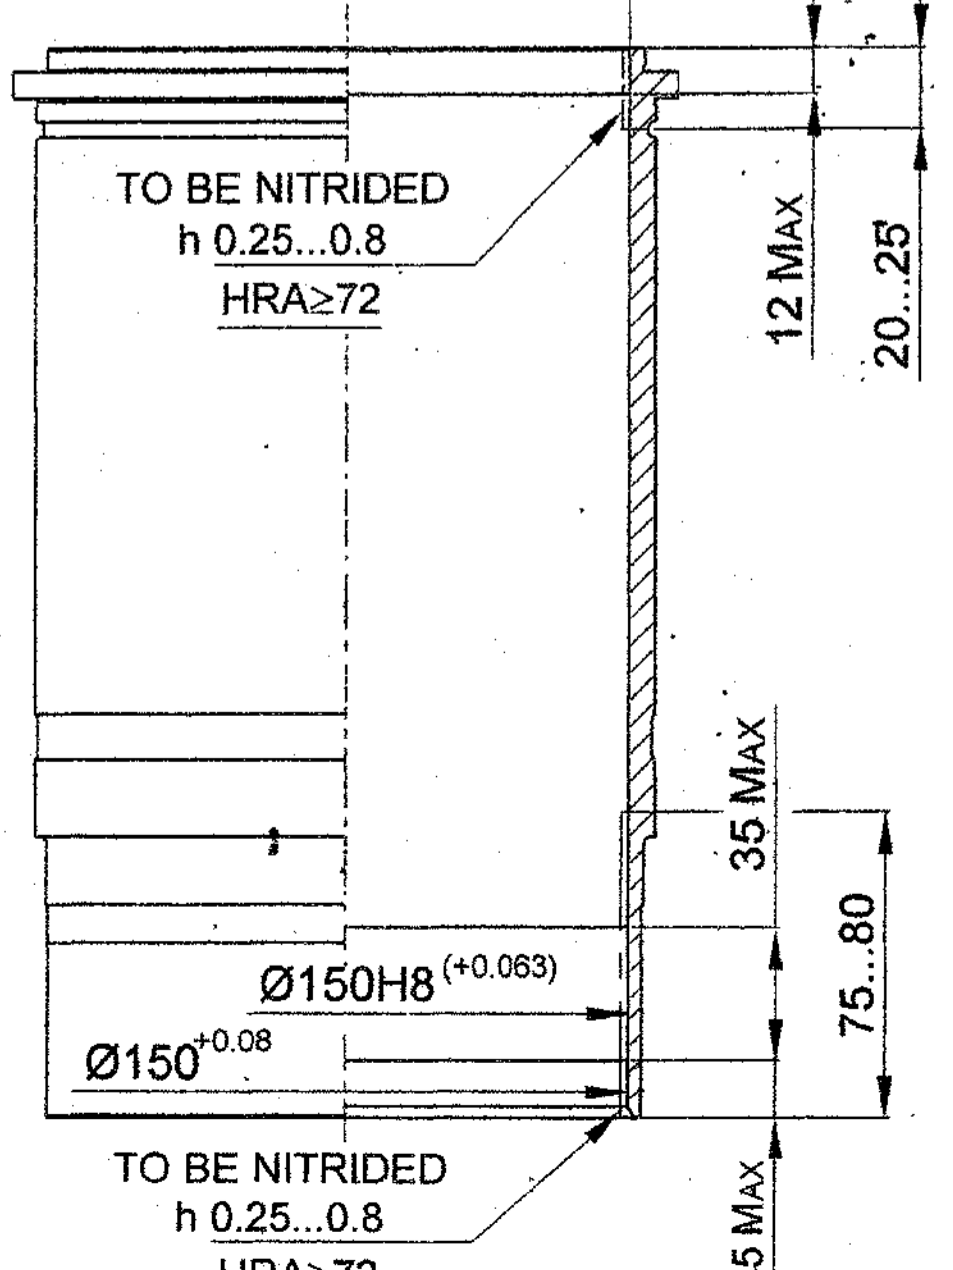

MARK REPAIR SIZE DIMENSIONS WHERE INDICATED THUS (✳) (✓)


SL.No.	REPAIR SIZES (mm)			REMARKS
	R ₁	R ₂	OS	
✳ ₁	165.5 ^{+0.043} _{+0.003} K7	165.5 ^{+0.043} _{+0.003} K7		1. ALL OTHER SIZES, SURFACE FINISH, MATERIAL AND TECHNICAL REQUIREMENTS ARE SAME. 2. FROM THE BOTTOM 25mm OF OUTSIDE DIA MARK REPAIR SIZES R ₁ , R ₂ , OS ₁ , OS ₂ AND OS ₃ .
✳ ₁	164.5 ^{+0.043} _{+0.003} K7	164.5 ^{+0.043} _{+0.003} K7		
✳ ₁	7f ₉ ^{-0.013} _{-0.042}	7.5f ₉ ^{-0.013} _{-0.042}		
✓ ₂	OS 1 150.100 ^{+0.04} _{H7}	OS 2 150.200 ^{+0.04} _{H7}	OS 3 150.250 ^{+0.04} _{H7}	

PILOT SAMPLE SHOULD BE APPROVED BY A H S P BEFORE BULK PRODUCTION.

EST. WT. (Kg) 6.528 TO BE STAMPED OR MARKED WHERE INDICATED THUS # (LETTERS)

ALL SHARP EDGES AND CORNERS TO BE REMOVED UNLESS OTHERWISE STATED MACHINED CORNERS TO HAVE R OUT-SIDE R INSIDE EQUIVALENT CHAMFERS ARE PERMISSIBLE

DRN	CHD	APPD	DATE	DIMENSIONS IN mm	TOLERANCE ON DIMNS UNLESS OTHERWISE STATED IS: 2H/2-f9	SCALE: 1:1	ALL THREADS TO CONFORM TO
MATERIAL - STEEL 38X MFOA TY 14-3-579-76	USED ON - C5 303-0D-16 C6 303-01-16	CONTROLLERATE OF QUALITY ASSURANCE (HEAVY VEHICLES) AVADI		TITLE - CYLINDER LINER		D S CAT NUMBER	DRAWING NUMBER 303-07-22-01
A 303-06 Dt.23-09-08				ISSUE DATE NATURE OF AMENDMENTS			

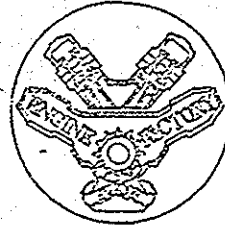

ENGINE FACTORY, AVADI

PROCESS SCHEDULE

DESCRIPTION :- **CYLINDER LINER**

COMPT. No :- **303-07-22**

MFG. SHOP :- **MPS**

REV. NO. 01


DATE :- 22.06.2K

FLOW PROCESS CHART

STORE : CYLINDER LINER

DRG. NO. : 303-07-22

END STORE: V46-6-ASSEMBLY

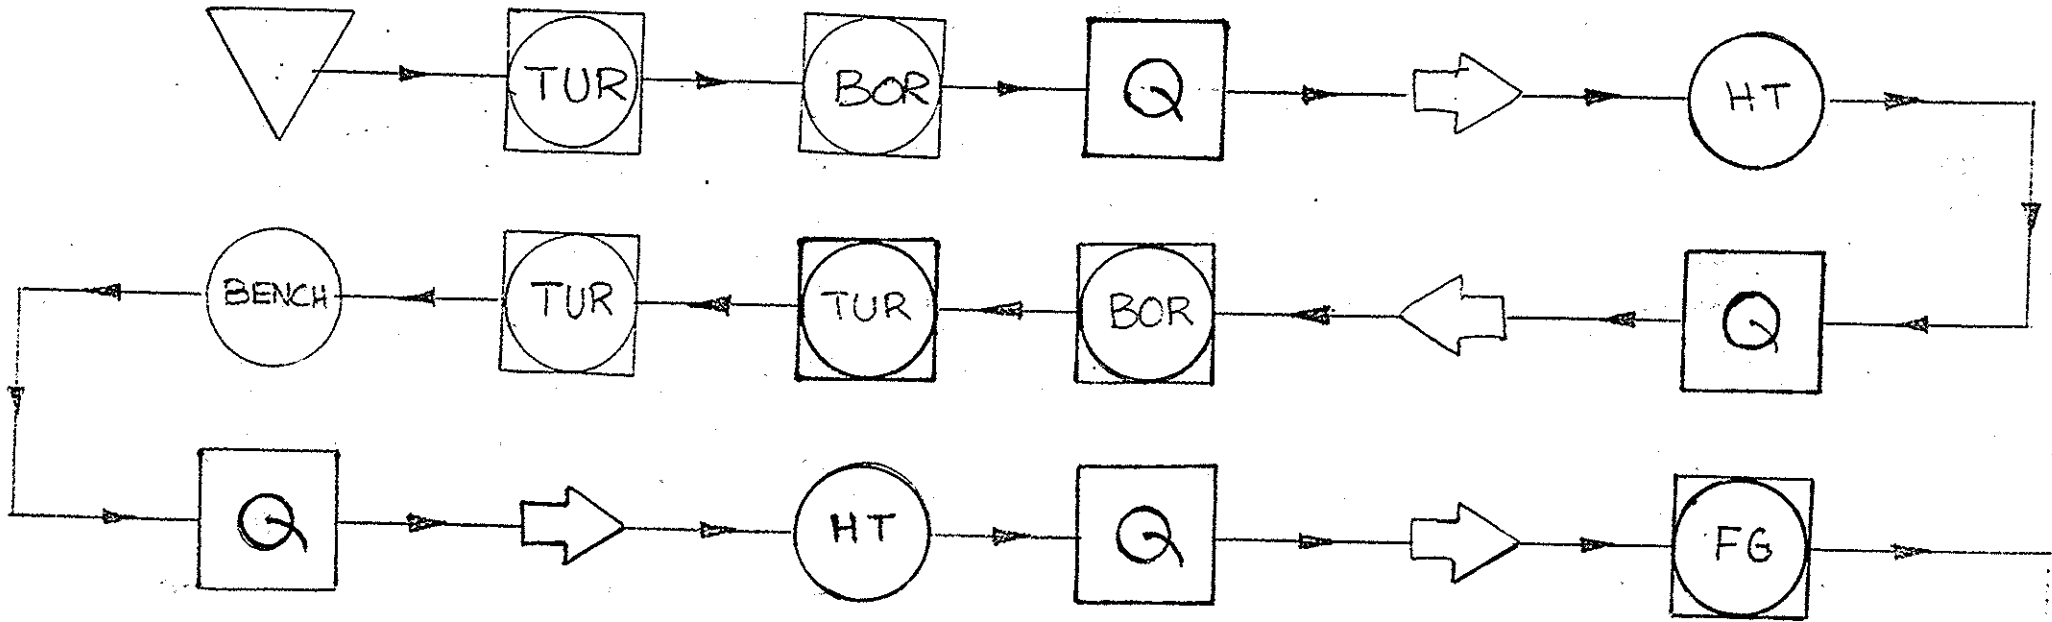

TUR = TURNING

BOR = BORING

HT = HEAT TREATMENT

FG = FACE GRINDING

LEGEND

TEMP. STORAGE



TRANSPORTATION



OPERATION



INSPECTION BY QC



OPERATION CUM INSPECTION ..



INSPECTION BY SQA/E/CQA/ME) Etc



100% INSPN. BY MFG SEC



STORAGE



APPROVAL

SIGNATURE & DATE

PREPARED BY

NICE

[Signature] QC

APPROVED BY

[Signature] 22/6/22

AUTHORISED FOR ISSUE

[Signature] 22/6/22

SECTION

MPS

NO. OF SHEETS

2

SHEET NO.

1


ENGINE FACTORY
AVADI, MADRAS-54.

FLOW PROCESS CHART

STORE :

DRG. NO. :

END STORE :

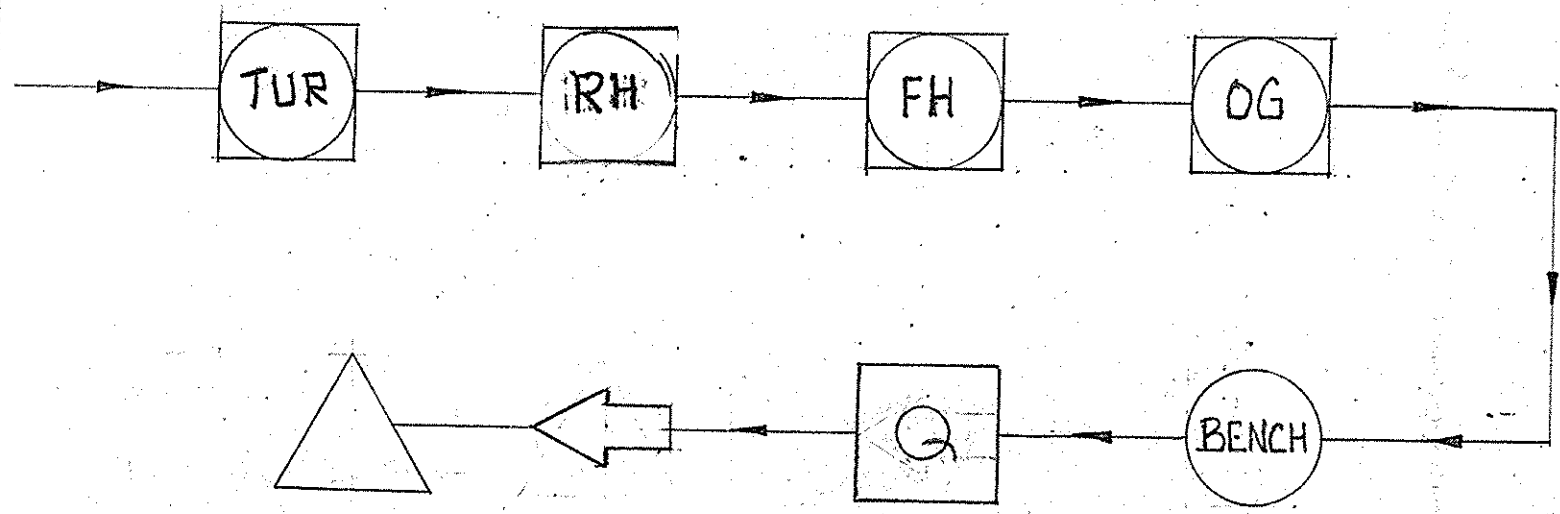

RH = ROUGH HONING | FH = FINISH HONING | OG = OD GRINDING

LEGEND		APPROVAL			SECTION	MPS	
TEMP. STORAGE	▽	TRANSPORTATION	➡	SIGNATURE & DATE		NO. OF SHEETS	2
OPERATION	○	INSPECTION BY QC	Q	PREPARED BY	MGR <i>[Signature]</i> QC	SHEET NO.	2
OPERATION CUM INSPECTION	◻	INSPECTION BY SQAE/CQA(ME) Etc	I	APPROVED BY	<i>[Signature]</i> 22/6/2k	ENGINE FACTORY AVADI, MADRAS-54	
100% INSPN. BY MFG SEC.	□	STORAGE	△	AUTHORISED FOR ISSUE	<i>[Signature]</i> 22/6/2k		



ENGINE FACTORY AVADI

FORM No :EFA/P-038

OPN No	DESCRIPTION OF OPERATION	SHT No	WORK CENTRE	SET UP TIME	OPN TIME	REMARKS
000	FORGING	4				
010	TURNING	5	CNC LATHE STC-25			
020	BORING	6	CNC LATHE STC-25			
030	INSPECTION	7	BENCH			
035	STABILIZING	8	HTP			
040	INSPECTION	9	BENCH			
050	BORING	10	CNC LATHE STC-25			
055	TURNING	11	CNC LATHE STC-25			

PREPARED BY		CHECKED BY		APPROVED BY		AUTHORISED BY						
SIGN	<i>[Signature]</i>	SIGN	<i>[Signature]</i>	SIGN	<i>[Signature]</i>	<i>[Signature]</i>						SHT. No 1 OF 25
DATE	16/16/22	DATE	22/6/22	DATE	22/6/22							
CH/M - II (CT)/PDO		HOS/PDO		HOS/PDO		DO/PDO		PDO REF	ISSUE	DATE	SIGN	



ENGINE FACTORY AVADI

FORM No :EFA/P-038

PROCESS SCHEDULE	NOMENCLATURE : <u>CYLINDER LINER</u>
	DRAWING No : <u>303-07-22</u>
	MATL SPECIFICATION : <u>STEEL 38X2M10A FORGING</u>

OPN No	DESCRIPTION OF OPERATION	SHT No	WORK CENTRE	SET UP TIME	OPN TIME	REMARKS
057	TURNING	12	CNC LATHE STC-25			
058	DEBURRING	-	BENCH			
060	INSPECTION	13 & 14	BENCH			
070	NITRIDING	15	HTP			
080	INSPECTION	16	BENCH			
090	FACE GRINDING & OD SKIMMING	17	CNC-CYL GRINDER GNC 18			
100 095	ROUGH HONING	18	HONING M/C			OPN NO 100 Rough honing was OPN 095 R-honing.
100 95	TURNING	19	CNC LATHE STC-25			OPN 095 Turning was OPN 100 Turning M ODA NO 178 dt 17.06.11

PREPARED BY		CHECKED BY		APPROVED BY		AUTHORISED BY						SHT. No
SIGN	<i>[Signature]</i>	SIGN	<i>[Signature]</i>	SIGN	<i>[Signature]</i>	<i>[Signature]</i>						2
DATE	16/6/22	DATE	22/6/22	DATE	22/6/22	22/6/22						OF
CM/II	/PDO		/PDO	HOS/PDC		DO/PDC		PDO REF	ISSUE	DATE	SIGN	25

CYLINDER LINE


D. W. IG No
303.0 22

ISSUE C. R. No. OPERATION
000 FORGING.

MATERIAL: STEEL 38X2MFOA

HARDNESS: BHN 255...302

MACHINE:

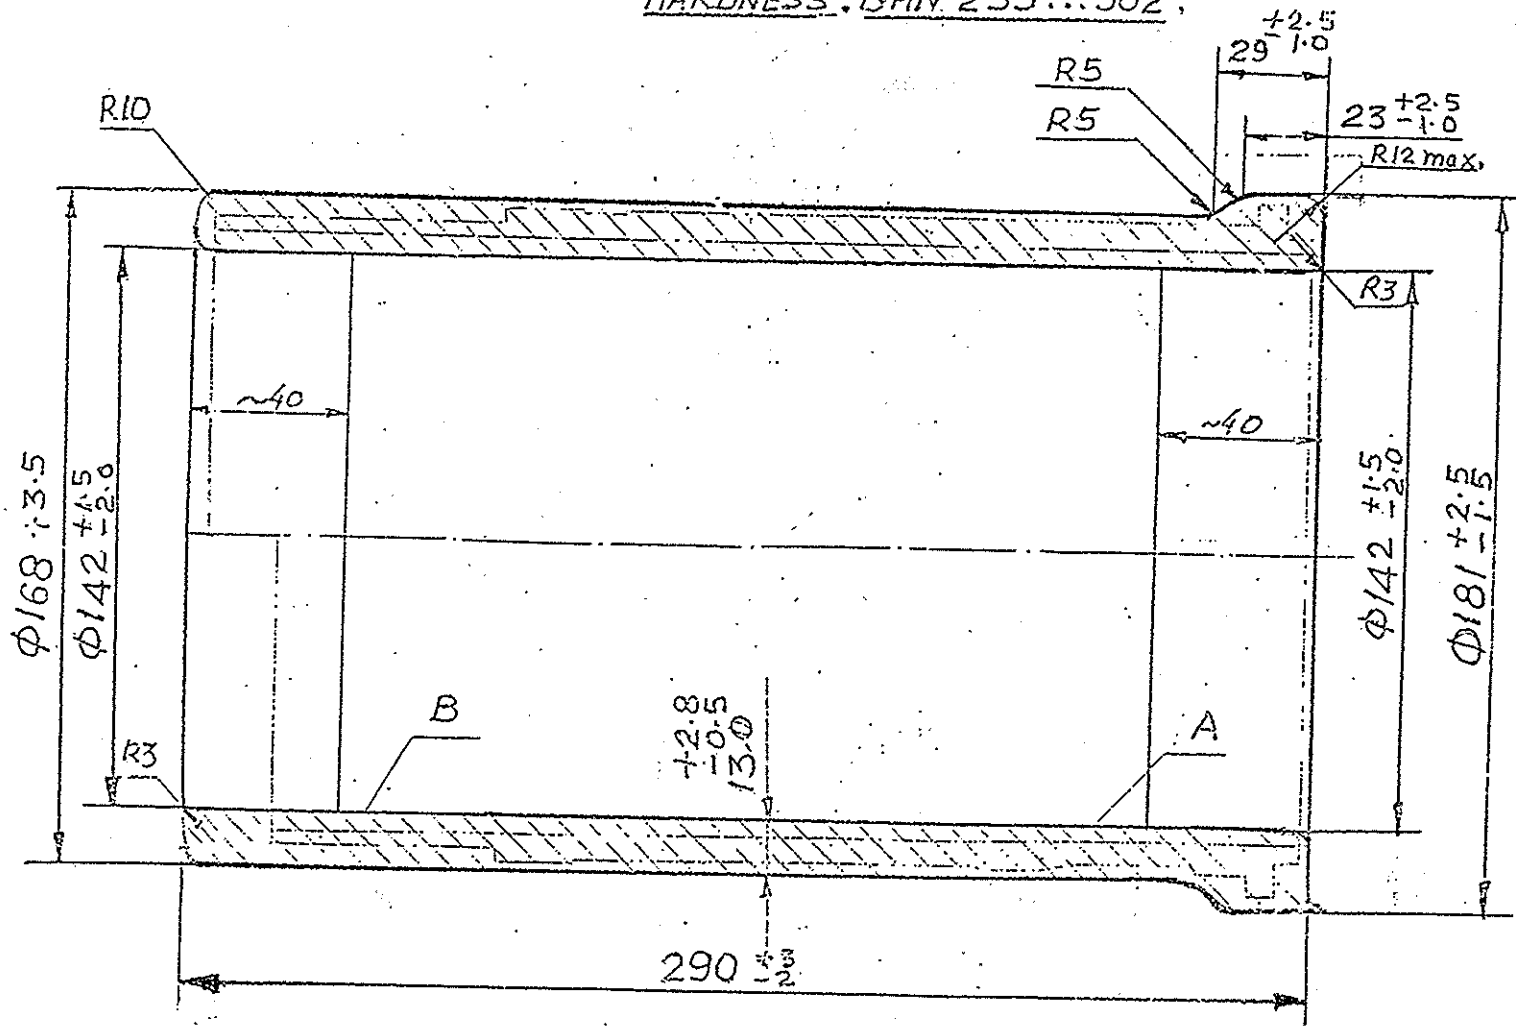

TECHNICAL REQUIREMENTS

1. Surface defects (Dents, nicks, scales) upon upsetting areas should not exceed to a depth of 0.5 of actual allowance.
2. Shift along the die parting line should not exceed 10mm.
3. Fin along the die flashline and end face, along $\phi 168$ should not exceed 2mm, end face fin along $\phi 181$ should not exceed 7mm.
4. Ring flash roll is allowed inside the pipe and at the places on 'A' and 'B'.

PRED.	CHD.	APPD.

PLANNING SHEET-PDO / EFA FORM No: EF 8 / P 01

CYLINDER LINER

303-1722

ISSUE

UPN. No.
020

OPERATION
TURNING AND BORING


MACHINE: CND LATHE
STC-25.

STD. TOOLS & GAUGES

- HVT SPECIAL BORING BAR T-415005622
- BAR (INTEGRAL SHANK)
- INSERT. CNMG120408
- SPECIAL TUNED BORING BAR 5691-010-03 (SANDVIK)
- (INTEGRAL SHANK)
- INSERT DNMG150604
- TURNING TOOL HOLDER PCLNL252512
- INSERT-CNMG120408

SPECIAL TOOLS & GAUGES

- HYDRAULIC COLLET FIXTURE 401292

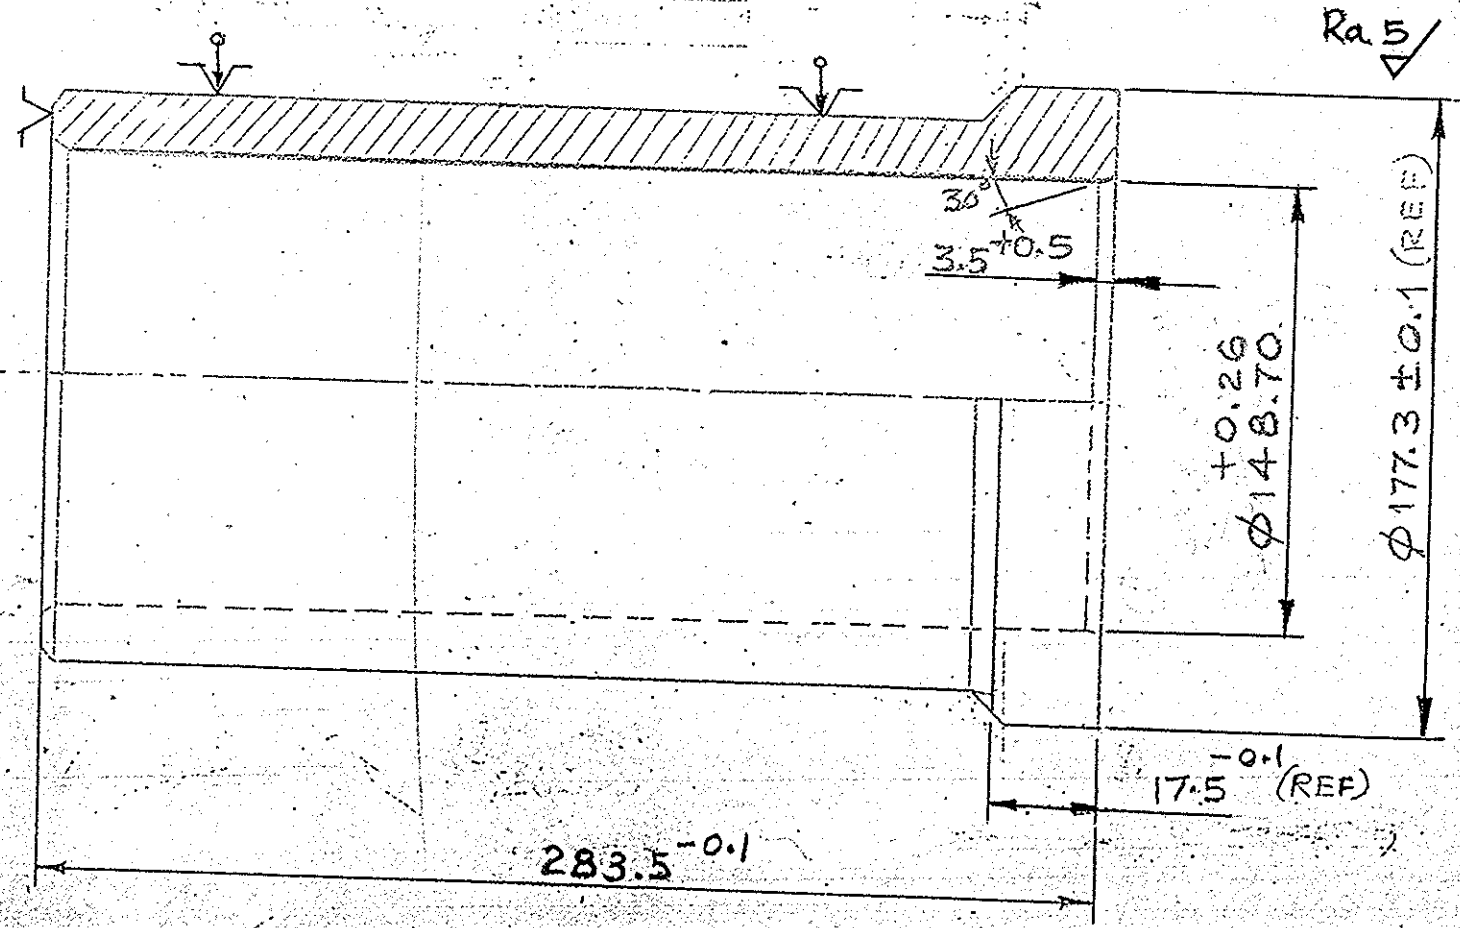


TECHNICAL REQUIREMENTS

1. VARIATION IN WALL THICKNESS SHOULD NOT EXCEED 0.15 MM.
2. OVALITY AND CONICITY OF BORE SHOULD NOT EXCEED 0.15 MM.

PRPD	CHD	APPD
PRPD	CHD	APPD

FORM No: EFA/P.C. / PLANNING SHEET-P.D.O. / EFA

DESCRIPTION <h2 style="text-align: center;">CYLINDER LINER</h2>	DRAWING No. 303-07-22	ISSUE	OPN. No. 030	OPERATION INSPECTION
--	---------------------------------	-------	------------------------	--------------------------------

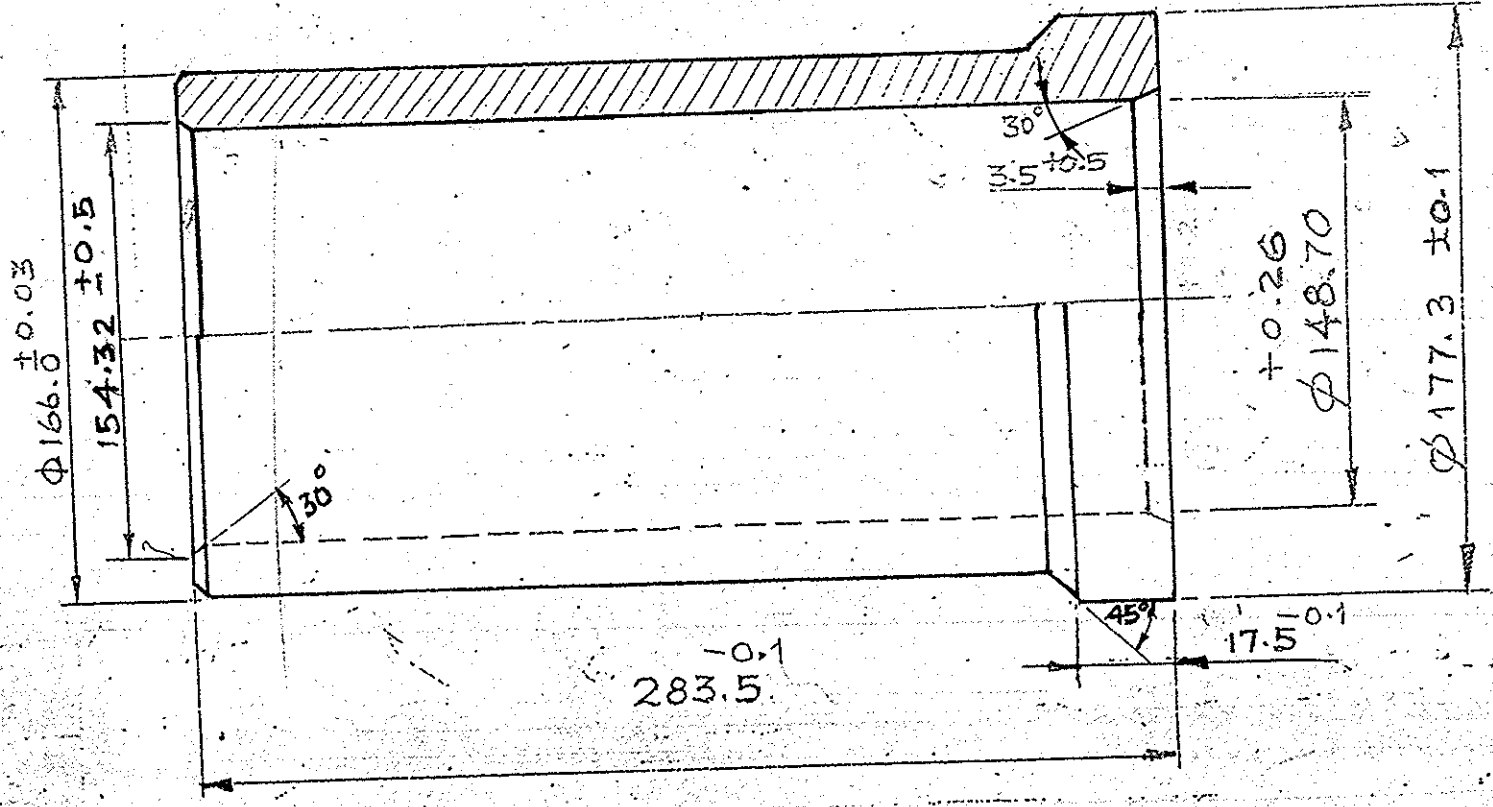

MACHINE: (BEFORE STARTING)

STD. TOOLS & GAUGES

SPECIAL TOOLS & GAUGES

TECHNICAL REQUIREMENTS

1. VARIATION IN WALL THICKNESS SHOULD NOT EXCEED 0.15MM.
2. OVALITY AND CONICITY OF BORE SHOULD NOT EXCEED 0.15MM.

NOTE

MEASURE AND RECORD ALL DIMENSIONS & ACTUALS OF TECH. REQTS.

PRP	CHK	APP
PRPD	CHD	APPD

PLANNING SHEET P-DO/EA FORM No: EFA/P-030

DESCRIPTION

CYLINDER LINER

DRAWING No. 303-07-22

ISSUE

OPN. No. 035

OPERATION STABILIZING


FINISHING: HEAT TREATMENT

STD. TOOLS & GAUGES

SPECIAL TOOLS & GAUGES

THE COMPONENTS ARE TO BE STABILIZED BY HOLDING IN FURNACE WITH $450^{\circ}\text{C} \pm 20^{\circ}\text{C}$ FOR 2 HOURS AND COOLED IN FURNACE ONLY.

COMPT. FIGURE AT THIS STAGE

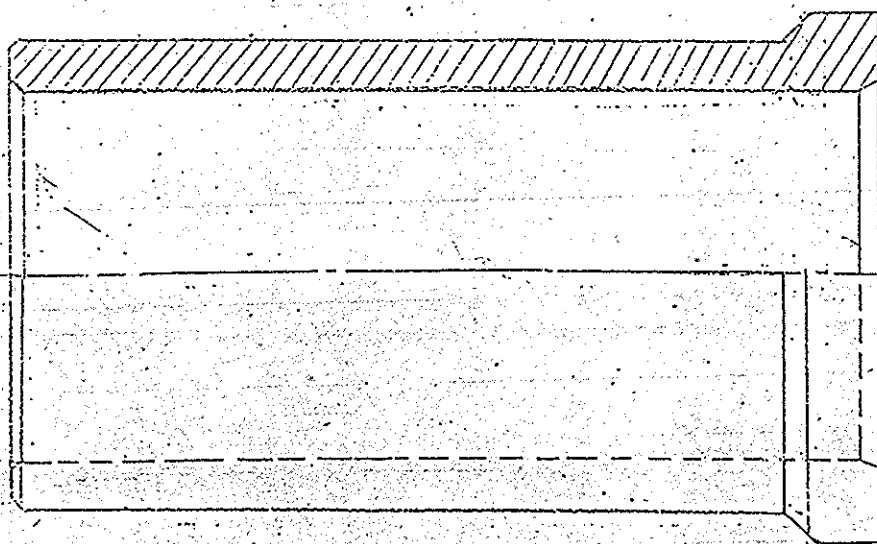

PRPD	CHD	APPD

PLANNING SHEET - P.D.O. / EFA FORM No. 57 2/1/03

SIGNATURE

CYLINDER LINER

DRAWING No.
303-1-22

ISSUE


OPN. No.
040

OPERATION
INSPECTION

MACHINE: (AFTER STABILIZING)

STD. TOOLS & GAUGES

SPECIAL TOOLS & GAUGES

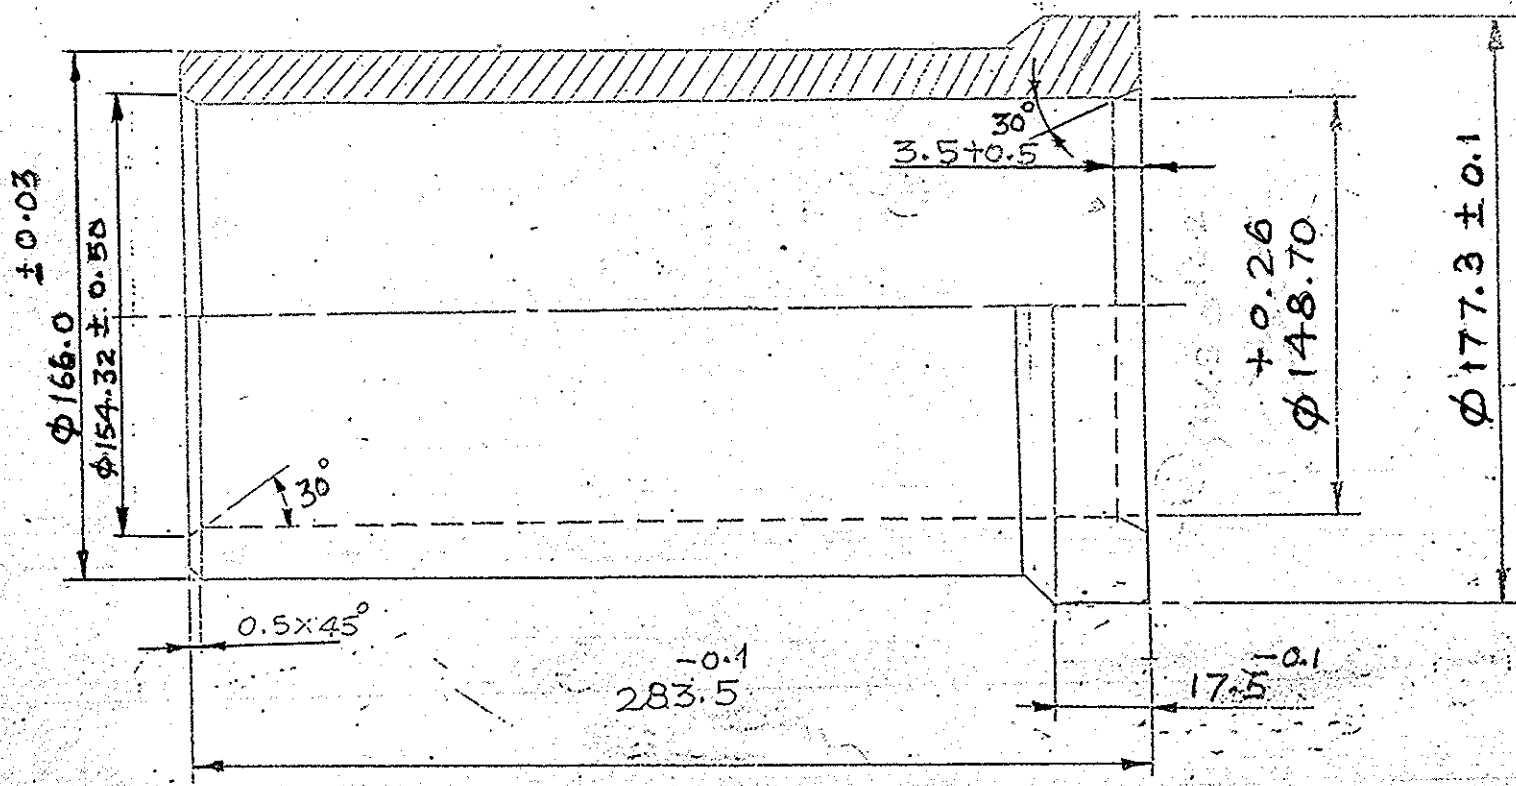

TECHNICAL REQUIREMENTS

1. VARIATION IN WALL THICKNESS SHOULD NOT EXCEED 0.15 MM.
2. OVALITY AND CONICITY OF HOLE SHOULD NOT EXCEED 0.15 MM.

NOTE

MEASURE AND RECORD ALL THE DIMENSIONS AND ACTUALS OF TECH. REQTS.

PRD	CHD	APPD

PLANNING SHEET-PDD / EFA FORM No: EFA/P-039

NOMENCLATURE

CYLINDER LINDER

DRAWING No. 303-7-22

ISSUE

Dr. No. 050 Dr. R. IC BORING


MACHINE: CNC LATHE
STC-25

STD. TOOLS & GAUGES

HMT SPECIAL BORING BAR (INTEGRAL SHANK) INSERT-CNM6120408 TK35	T-41500562
SPECIAL TUNED BORING BAR (INTEGRAL SHANK) INSERT-DNMG150604	5691-010 -03 (SANDVIK)
TURNING TOOL HOLDER INSERT-CNM6120408 TK35	PLNL 252512

SPECIAL TOOLS & GAUGES

HYDRAULIC COLLET FIXTURE	401292
-----------------------------	--------

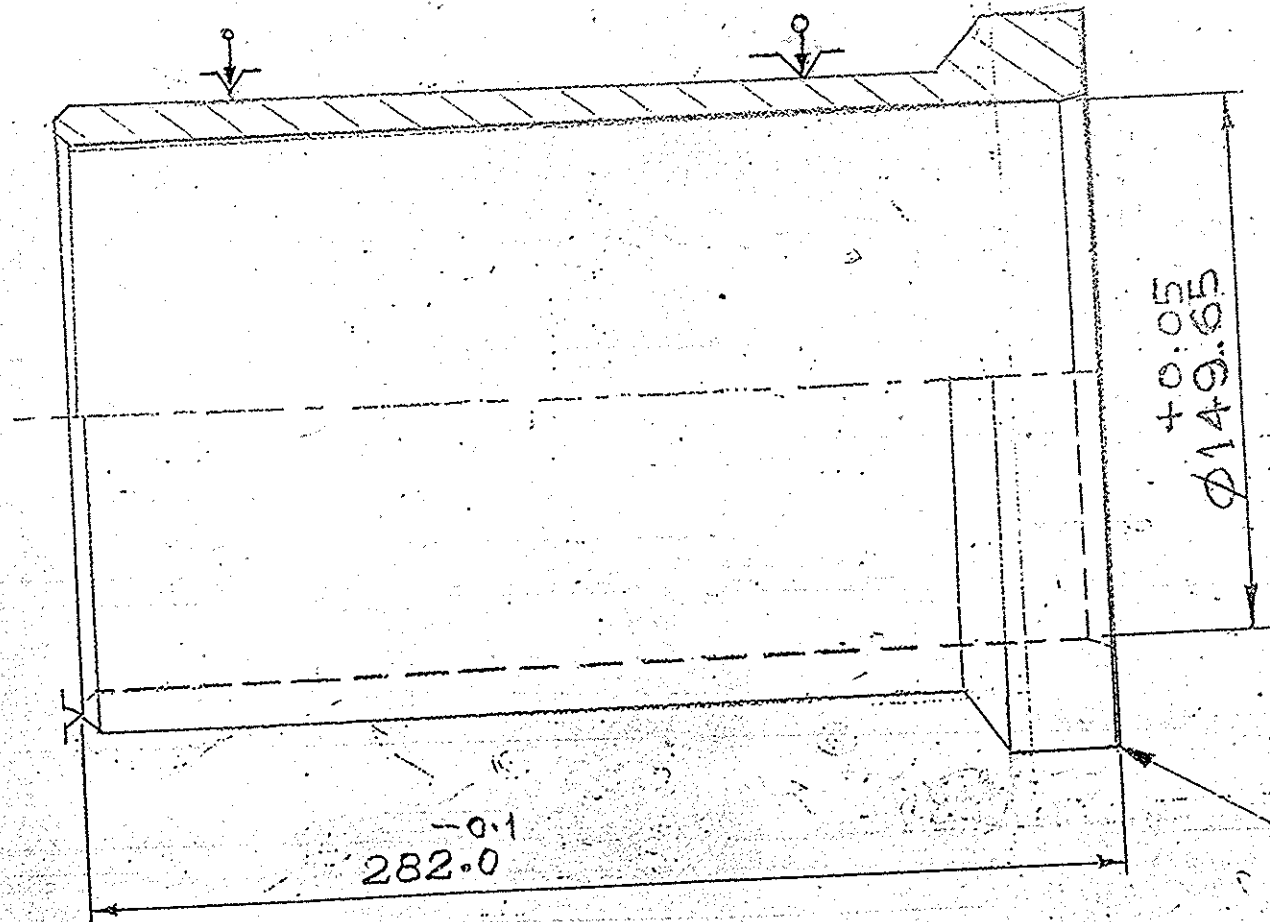

Ra5 ✓

BLUNT SHARP EDGE



TECHNICAL REQUIREMENT

CONICITY AND OVALITY OF BORE
SHOULD NOT EXCEED 0.06 MM.

PRED	CHD	APPD	PDDREF	ISSUE	DATE

FORM No: EFA/P-03
PLANNING SHEET - PDO / EFA

Ra5/ (✓)

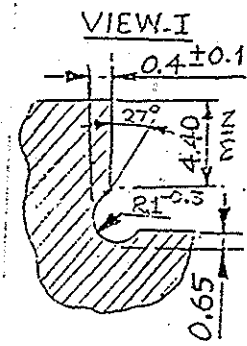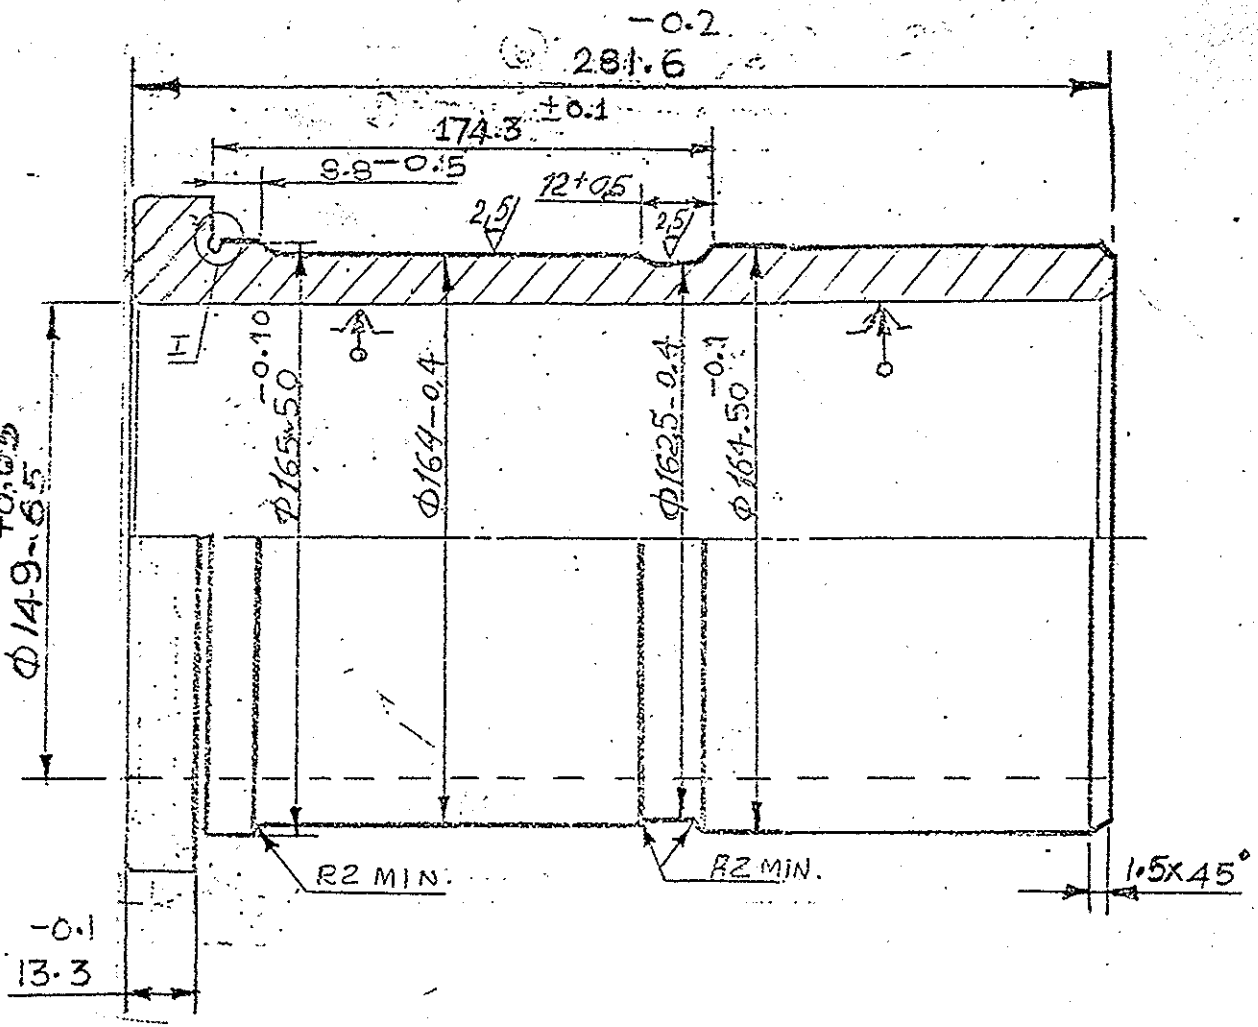

MACHINE: CNC-LATHE
HMT STC-25/1500

STD. TOOLS & GAUGES

TURNING TOOL HOLDER P02NL-252515
 INSERT-DNM6-450608
 TURNING TOOL HOLDER SP-6/16011+
 (CORNER RELIEF) (SANDVIK)
~~INSERT-VCMM1604-08~~

GROOVING TOOL HOLDER 202267
 GROOVING INSERT 202268

SPECIAL TOOLS & GAUGES

HYDRAULIC EXPANDING MANDREL 201569
 SNAP GAUGE φ16.5 ± 0.5 026/04/17
 SNAP GAUGE φ16.4 ± 0.1 026/04/16
 OUTSIDE MICROMETER 150-175 MM.

			169	2	29/05/04
			150	1	12/01/2001
PRED	CHD	APPD	PDO REF	ISSUE	DATE

PLANNING SHEET-PDO/EFA FORM No: EFA/P-03

NUMERICALATURE


CYLINDER BORE

DRAWING No.
303 7.22

ISSUE

OPN. No.
060

OPERATION
INSPECTION

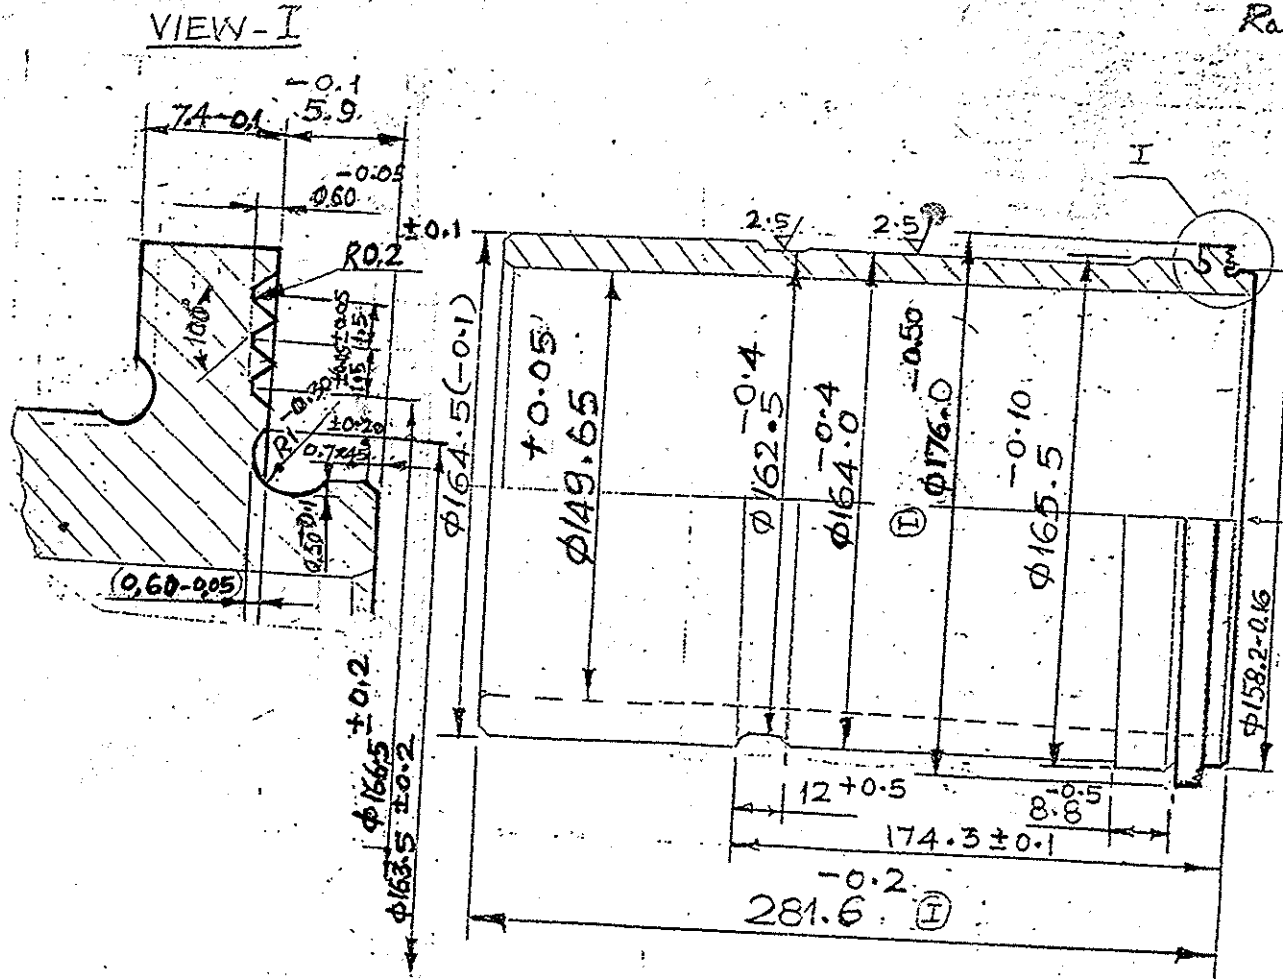

Ra 5 (A)

MACHINE:
BEFORE NITRIDING

STD. TOOLS & GAUGES

SPECIAL TOOLS & GAUGES

SNAP GAUGE	
$\phi 158.2^{+0.16}$	026/04/15
$\phi 165.5^{+0.1}$	026/04/17
$\phi 164.5^{+0.1}$	026/04/16

① OUTSIDE MICROMETER
150-175 MM.

TECH. REQT: CONICITY AND OVALITY OF BORE
SHOULD NOT EXCEED 0.06 mm.

			169	1	29/06/02
PRED	CHD	APPD	PDO.REF	ISSUE	DATE

CYLINDER LINER

DRAWING No. 303.4.22

ISSUE

OPN. No. 060

OPERATION INSPECTION

BEFORE NITRIDING

(I)
DELETED

1. LINERS HAVING BORE $\phi 149.65^{+0.10}$ (ELLIPTICITY AND CONICITY) SHOULD NOT EXCEED $\Delta 0.06$ MM) ARE TO BE DELIVERED FOR NITRIDING. LINERS HAVING BORES WITH $\phi 149.82$ AND ELLIPTICITY AND CONICITY OF BORE UP TO 0.08 MM ARE TO BE DELIVERED FOR NITRIDING AS A SEPARATE BATCH ACCOMPANIED BY CORRESPONDING DOCUMENT. SPECIAL MARK SHOULD BE MADE ON SUCH COMPONENTS ON THE SIDE OF CENTERING COLLAR.

2. ONE NUMBER OF CUT OUT RING HAVING WIDTH 10 ± 1 MM FROM A REJECTED COMPONENT SHOULD BE SENT ALONG WITH A BATCH OF COMPONENTS FOR CHECKING HARDNESS.

MACHINE: (BEFORE NITRIDING)

STD. TOOLS & GAUGES

SPECIAL TOOLS & GAUGES

PRED.	CHD.	APPD.	ISSUE	DATE

FORM No: EFA/P-030

PLANNING SHEET - PDO / EFA


NOMENCLATURE CYLINDER LINER

DRAWING 303.07.22.

ISSUE

UPN. No. 070

OPERATION HEAT TREATMENT

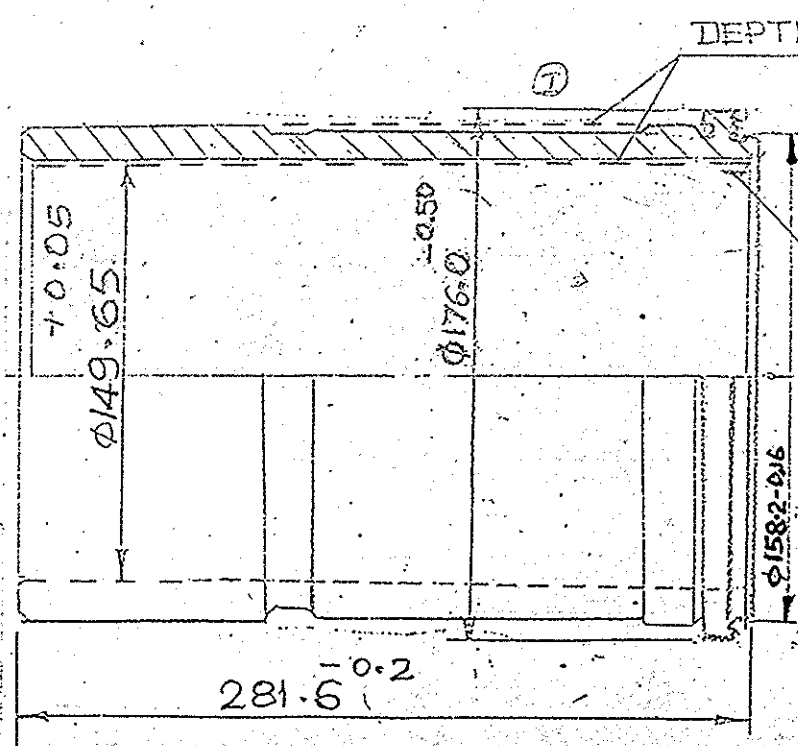

DEPTH OF NITRIDED LAYER 0.5 TO 0.8mm

PLACE FOR CHECKING
HARDNESS AT A DISTANCE
OF 10 TO 20 mm FROM
END FACE.

MACHINE: NITRIDING

STD. TOOLS & GAUGES

SPECIAL TOOLS & GAUGES

HARDNESS OF NITRIDED LAYER & HR A ≥ 76.

NOTE: (1) ONE NO OF CUT OUT RING HAVING WIDTH 10 ± 1 mm FROM A REJECTED COMPONENT SHOULD BE SENT ALONG WITH A BATCH OF COMPONENTS FOR CHECKING HARDNESS.

(2) NITRIDED PLACES ARE INDICATED AS DOTTED LINE. OTHER PLACES ARE TO BE PROTECTED FROM NITRIDED.


PRED	CHD	APPD

PLANNING SHEET-PDO/EEA FORM No: EFA/P-03

CYLINDER LINE P

DRAWING NO.
303.07.22

ISSUE OPM. No OPERATION
080 INSPECTION

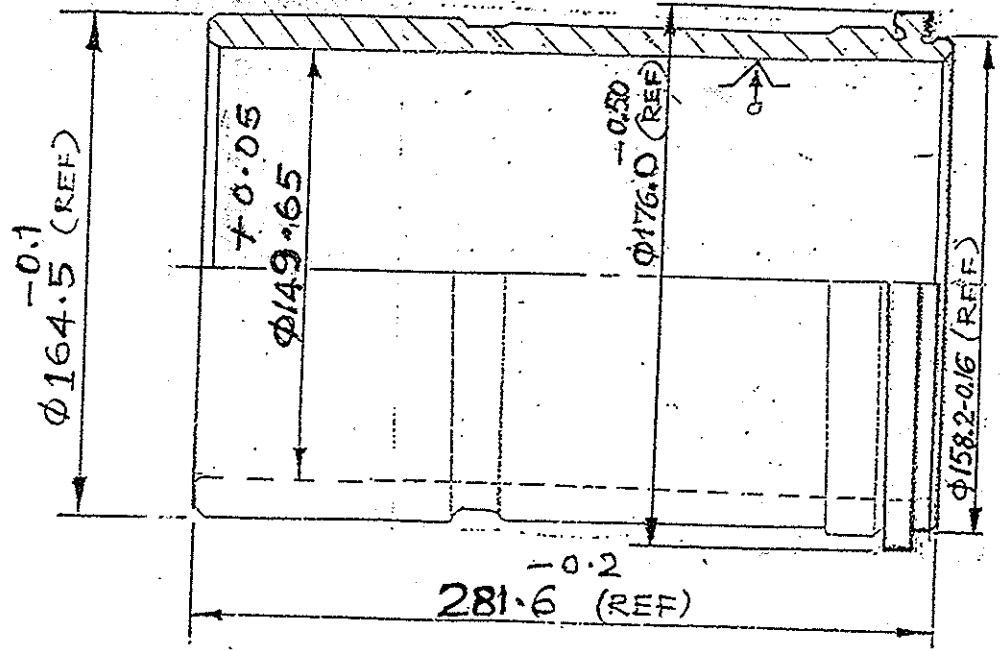

MACHINE:
AFTER NITRIDING

STD. TOOLS & GAUGES

SPECIAL TOOLS & GAUGES

- ① ~~SNAP GAUGE~~ ~~026/04/15~~
~~Φ158.2^{+0.16}~~
~~Φ165.5^{+0.1}~~ ~~026/04/17~~
~~Φ164.5^{+0.1}~~ ~~026/04/16~~
- ① OUTSIDE MICRO METER
150-175 MM.

TECH. REQTS:-

1. CONICITY AND OVALITY OF BORE SHOULD NOT EXCEED 0.15 mm.
2. HARDNESS OF NITRIDED LAYER HRA ≥ 76.
3. DEPTH OF NITRIDED LAYER 0.5 TO 0.8 mm.

			169	1	29/5/4
PRED	CHKD	APPE	PDO REF	ISSUE	DATE

PLANNING SHEET - PDDO / EFA FORM No: EFA/P-032

HOME IND. ATURE


CYLINDER LINER

DRAWING No.
303 07.22

ISSUE

OPIL No.
090

OPERATION FACE
GRINDING & OD SKIMMING

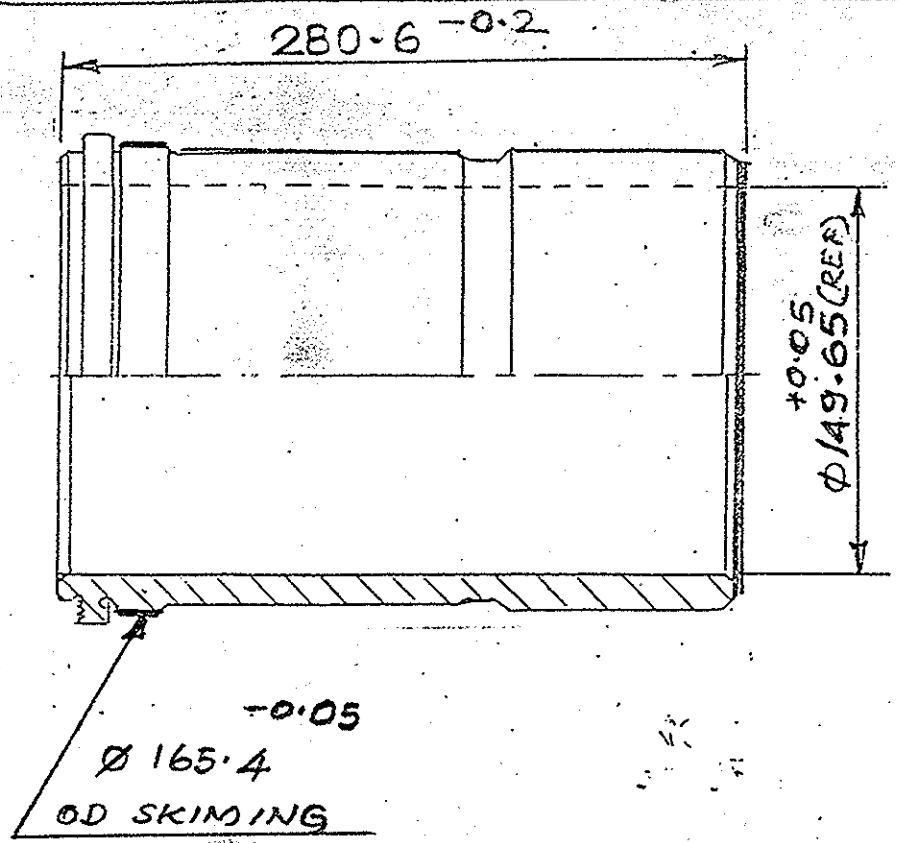

Ra 5

MACHINE: CNC-EXT. GRINDER
HMT - GNC-18.

STD. TOOLS & GAUGES

GRINDING WHEEL
Φ450 X 60 W X Φ254
(R051-Φ325-10W)
A463K5V10
DIAMOND DRESSER
070/000/079
070/00/012
070/00/013
[FOR G17 CYLINDRICAL
GRINDING M/C]

SPECIAL TOOLS & GAUGES


EXPANSION MANDREL	201522 201568
SPECIAL CENTER	400573

PRED	CHD	APPD	PL. REC.	ISSUE DATE

PLANNING SHEET - PDO / EFA FORM No: EFA

303-07-22

CNC TURNING

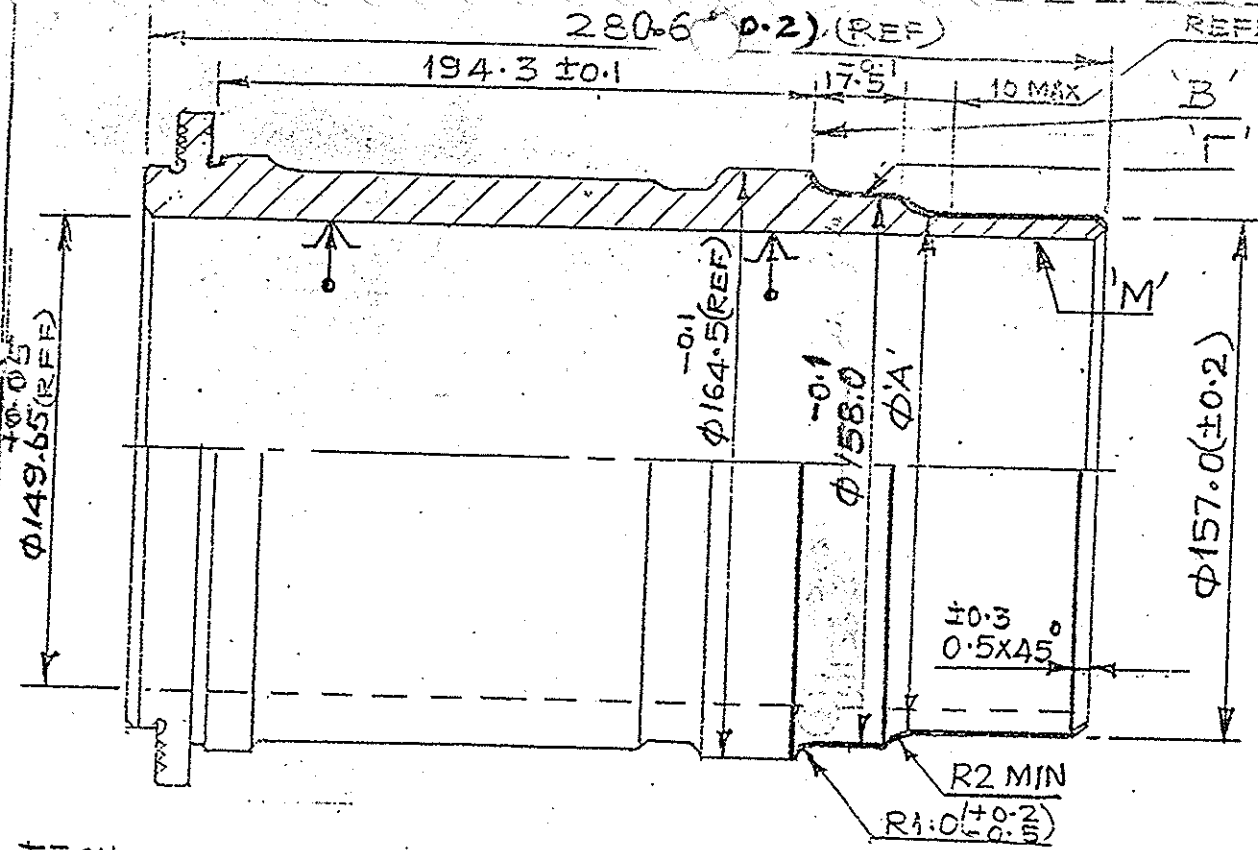

REFER R.2.

OPN 095
Ra 5/0

MACHINE: CNC - LATHE
HMT STC 25/1500.
OPN ~~120~~ TURNING ①

STD. TOOLS & GAUGES

TURNING TOOL HOLDER	PDJNL25251
INSERT-DNMG 150608	

SPECIAL TOOLS & GAUGES

HYDRAULIC EXPANSION MANDREL	201569
SNAP GAUGE	026/04/15
φ158 ± 0.1	

TECH. REQTS:-

1. VARIATION IN MEASUREMENTS OF WALL THICKNESS OF SURFACE 'M' AND 'B' SHOULD NOT EXCEED 0.05mm.
2. ECCENTRICITY OF φ'A' UPTO A LENGTH OF 10mm RELATIVE TO φ157(±0.2) SHOULD NOT EXCEED 0.2mm.
3. BURRS ARE NOT ALLOWED ON FACE 'B'.

PRED	CHD	APPD	PDO REF	ISSUE	DATE


ENCLOSURE

CYLINDER LINER

RA III I
303-07-22

SS E OF R 16
OPN-100 0951 ROUGH HONING

Ra0.16

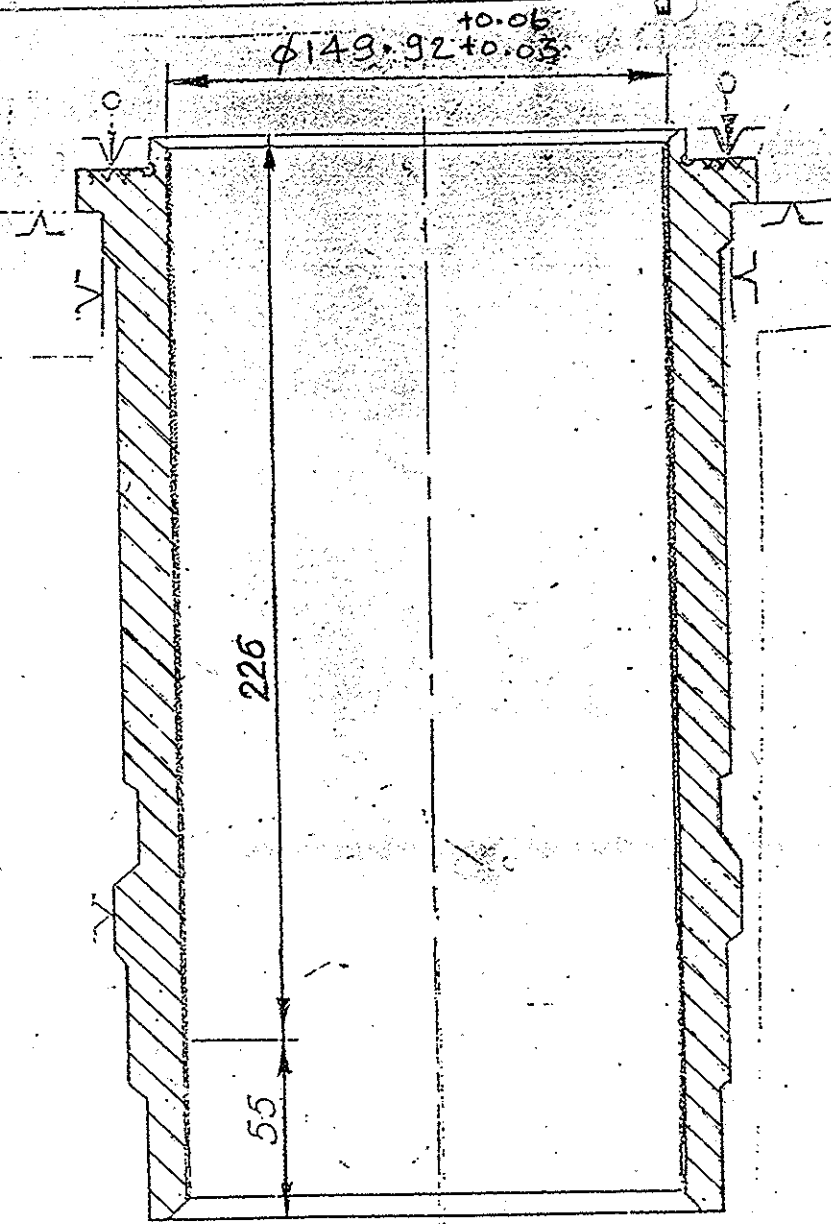

ROUGH HONING

TECHNICAL REQUIREMENTS

1. ELLIPTICITY OF THE BORE ON A LENGTH OF 226 MM SHOULD NOT EXCEED 0.03 MM.
OVALITY OF THE BORE ON A LENGTH OF 55 MM FROM THE BOTTOM SHOULD NOT EXCEED 0.04 MM.
2. CONICITY OF BORE MEASURED ON A LENGTH OF THE LINER SHOULD NOT EXCEED 0.04 MM.
3. CONCAVITY AND CONVEXITY OF THE BORE SHOULD NOT EXCEED 0.03 MM.

MACHINE: HONING MACHINE
"GEHRING"

STD. TOOLS&GAUGES	
HONING STICK DIAMOND FINE (D251-55-M2-75) GRADE	402254/3 402254/4
HONING STICK DIAMOND COARSE (D301-50-M0-100) GRADE	402254/1 402254/2
BORE DIAL	

SPECIAL TOOLS&GAUGES	
FIXTURE	201412
HONING SHOE HOLDER	400545
LIFTING UNIT	200722
SETTING RING	094/00/072

<i>[Signature]</i>	<i>[Signature]</i>	<i>[Signature]</i>			
PRED	CHD	APRD	PDO REF	ISSUE	DATE

PLANNING SHEET-PDO / EFA FORM No: EFA/P-03

OK NC AT RE


CYLINDER LINER

DRAWING No. 303-7-22

ISSUE

OPN. No. 110 OPERATION FINISH HONING

Ra 0.125

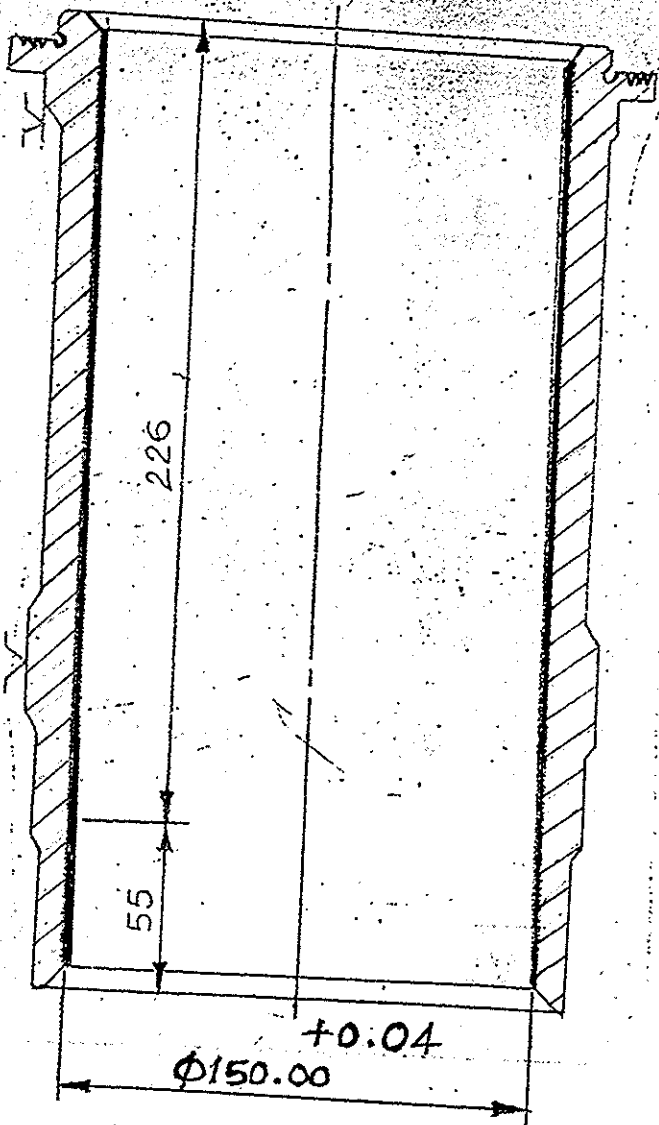

FINISH HONING

TECHNICAL REQUIREMENTS

1. ELLIPTICITY OF THE BORE ON A LENGTH OF 226 MM SHOULD NOT EXCEED 0.03 MM. OVALITY OF THE BORE ON A LENGTH OF 55 MM SHOULD NOT EXCEED 0.04 MM.
2. CONICITY OF BORE MEASURED ON A LENGTH OF LINER SHOULD NOT EXCEED 0.04 MM.
3. CONCAVITY AND CONVEXITY OF THE BORE SHOULD NOT EXCEED 0.03 MM.

MACHINE: HONING MACHINE "GEHRING"

STD. TOOLS & GAUGES

HONING STICK
 ABRASIVE FINE
 GC400-G-VG-1
 13X13 SQUARE X 150MM
 13X13 SQUARE 100MM.
 BORE DIAL

SPECIAL TOOLS & GAUGES

FIXTURE	20142
HONING SHOE HOLDER	400546
LIFTING UNIT	200722
SETTING RING	094/00/005

PRED	CHD	APPD	PDO REF	ISSUE	DATE

FORM No: EFA/F-039
PLANNING SHEET-PDO/EFA


RELATURE

CYLINDER LINER

DR. W. J. G.
303.07-2

15 JE

120 OPERATION
W. K. INDI. JG

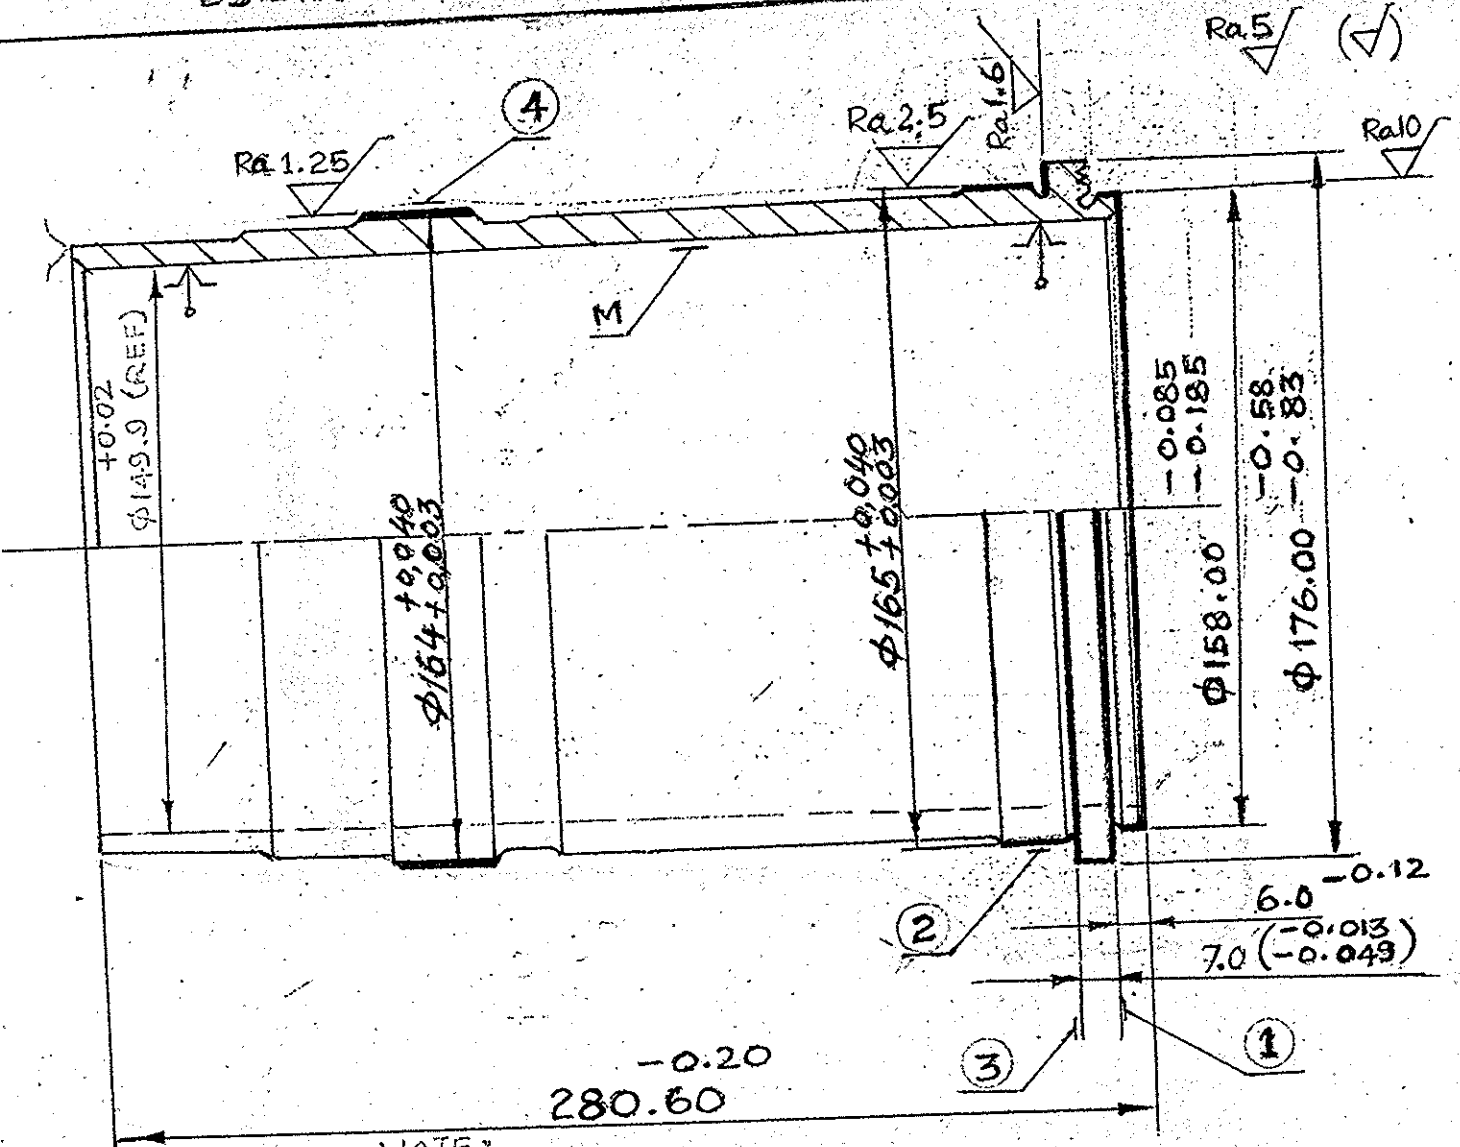

MACHINE: CNC
CNC CYLINDRICAL
GRINDER HMT GNC-18

STD. TOOLS & GAUGES

GRINDING WHEEL
Φ450 X 60 X 1254
(RCS-1-Φ32 X 10W)
A463 K5 V10
DIAMOND DRESSER K 070/00/012
070/00/013

SPECIAL TOOLS & GAUGES

EXPANDING MANDREL 201568
SPECIAL CENTER 400573
ANALOG GAUGE
Φ158 (+0.003 / +0.003) 026/04/15
Φ164 (+0.003 / +0.003) 026/04/22
Φ165 (+0.043 / +0.003) 026/04/21
Φ158 -0.085 / -0.185 026/04/22
DEPTH GAUGE 6-12 030/50
GAP GAUGE 7-0.013 / -0.049 023/01/31

NOTE: FOR TECHNICAL REQUIREMENTS REFER SHT: 22

PRED	CHD	APPD	PDO REF	ISSUE	DATE

FORM No: EFA/P/1
PLANNING SHEET - PDO / EFA

CYLINDER LINER

303-03-22

120 OD GRINDING

TECHNICAL REQUIREMENTS

MACHINE: CNC CYLINDRICAL GRINDER - HMT CNC 12

STD. TOOLS & GAUGES


SPECIAL TOOLS & GAUGES

1. ~~OVARIETY TOLERANCE OF SURFACE "E" & "E" SHOULD NOT EXCEED 0.02 MM.~~
2. WHEN SURFACE ③ IS USED AS A BASE, RUN OUT OF SURFACE ② RELATIVE TO SURFACE ④ SHOULD NOT EXCEED 0.04 MM.
3. VARIATION IN WALL THICKNESS OF SURFACES ① & ② AND ③ & ④ SHOULD NOT EXCEED 0.05 MM.
4. IMPRINT OF BLUEING ALONG THE CIRCUMFERENCE OF FACE ③ SHOULD BE CONTINUOUS AND NOT LESS THAN 1.8 MM IN WIDTH
5. VARIATION IN MEASUREMENTS OF THICKNESS OF FACES ① AND ③ OF LINER FLANGE SHOULD NOT EXCEED 0.02 MM.

<input checked="" type="checkbox"/>	<input checked="" type="checkbox"/>	<input checked="" type="checkbox"/>
PRED.	CHD.	APPD.

PLANNING SHEET-PDO / EFA FORM No: EFA/P-030

GENERAL TITLE <h2 style="text-align: center;">CYLINDER LINER</h2>	DRAWING No. <h3 style="text-align: center;">303-07-22</h3>	ISSUE 	OPN. No. <h3 style="text-align: center;">140</h3>	OPERATION FINAL INSPECTION
--	---	-----------	--	-------------------------------

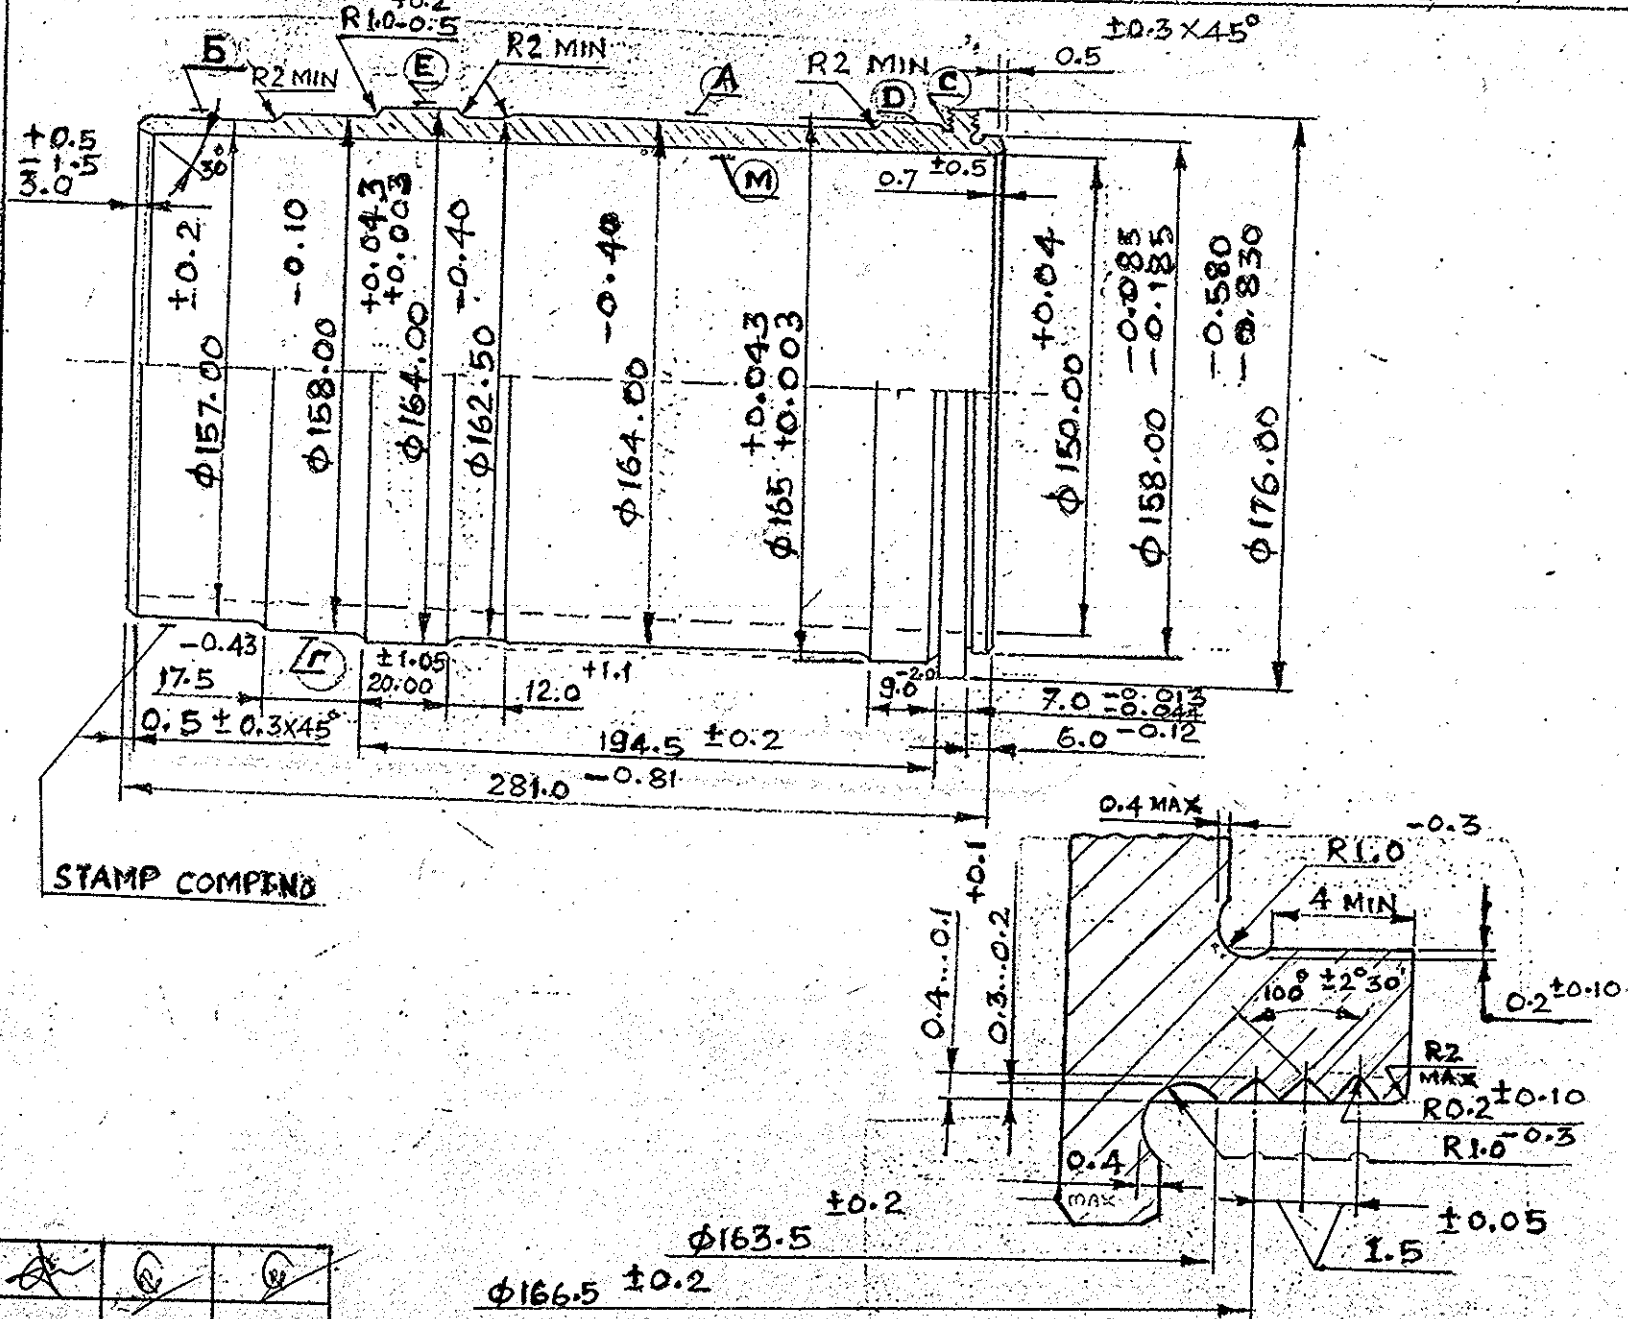

DATE:

STD. TOOLS & GAUGES

SPECIAL TOOLS & GAUGES

PRED	CHD	APPD
------	-----	------

PLANNING SHEET-PDO/EFAPFORM No: EFA/P-030

CYLINDER LINER

JK W. Co. 303 7-22

ISSUE No. 140

INSPECTION

TECHNICAL REQUIREMENTS

① CHECK DIMENSION OF BORE, OVALITY OF SURFACE "M" ON A LENGTH OF 221 MM, SHOULD NOT EXCEED 0.03 MM. AND ON A LENGTH OF 55 MM FROM THE END OF LINER LOWER PORTION SHOULD NOT EXCEED 0.04 MM. CONICITY OF SURFACE "M" SHOULD NOT EXCEED 0.04 MM. CONCAVITY AND CONVEXITY OF SURFACE "M" SHOULD NOT EXCEED 0.03 MM.

② CHECK FACE "C" BY BLUEING

③ THE OVALITY OF SURFACES "B" AND "E" SHOULD NOT EXCEED 0.02 MM

④ THOROUGHLY CHECK INTERNAL AND EXTERNAL SURFACES OF THE COMPONENT. MARKS UP TO 0.3 MM DEEP LEFT BY CUTTING TOOLS ARE ALLOWED ON SURFACE "B"

REFERENCE:

STD. TOOLS & GAUGES

SPECIAL TOOLS & GAUGES

- ① SNAP GAUGE $\phi 158^{+0.015}_{-0.015}$ 026/01/15
- ~~$\phi 164^{+0.002}_{-0.015}$ 026/04/20~~
- ~~$\phi 165^{+0.043}_{-0.003}$ 026/04/21~~
- ~~$\phi 158^{-0.065}_{-0.155}$ 026/04/22~~
- ~~DEPTH GAUGE 6⁻¹² 030/58~~
- ~~GAP GAUGE 0.013 0.049 025/01/51~~
- ① OUTSIDE MICROMETER
- 0-25 mm
- 0-150 mm
- 150-175 mm

			169	1	29/05/24
PRED	CHD	APPD	PDO REF	ISSUE	DATE

CYLINDER LINER		DRAWING 303-07-22	ISSUE	OPN. No. 140	OPERATION INSPECTION
<p>5) MINIMUM DEVIATION FROM $\phi 165$ AND $\phi 164$ IN HUNDREDTH MM ON LOWER PORTION OF THE LINER USING ELECTROGRAPH METHOD</p>				STD. TOOLS & GAUGES	
<p>6) CHECK VARIATION IN MEASUREMENTS OF WALL THICKNESS OF SURFACES "M" AND "D", "M" AND "E", "M" AND "F". IT SHOULD NOT EXCEED 0.05 MM.</p>					
<p>7) BUBBLES AND BARE SPOTS ARE NOT ALLOWED ON SURFACE "A" COATED WITH ANTI-CORROSIVE LAYER.</p>				SPECIAL TOOLS & GAUGES	
<p>8) FINISHED COMPONENTS SHOULD NOT HAVE ANY FORGING DEFECTS, CHIPPINGS, OFF NITRIDED LAYER, DENTS ON GROUND SURFACES.</p>					
<p>9) EXTERNAL SURFACE, SHOWN WITH DOTTED LINE, SHOULD BE PROVIDED WITH CHROMIUM PLATING, MILKY.</p>					
PRED	CHD	APPD			