


w34e3wqwe

DRG. NO.  
ARM 1172A17

FOR EXPLANATION OF DIMENSIONING ETC. SEE IS 1070

No part of these drawings may be reproduced in any form without prior permission in writing of OFM.

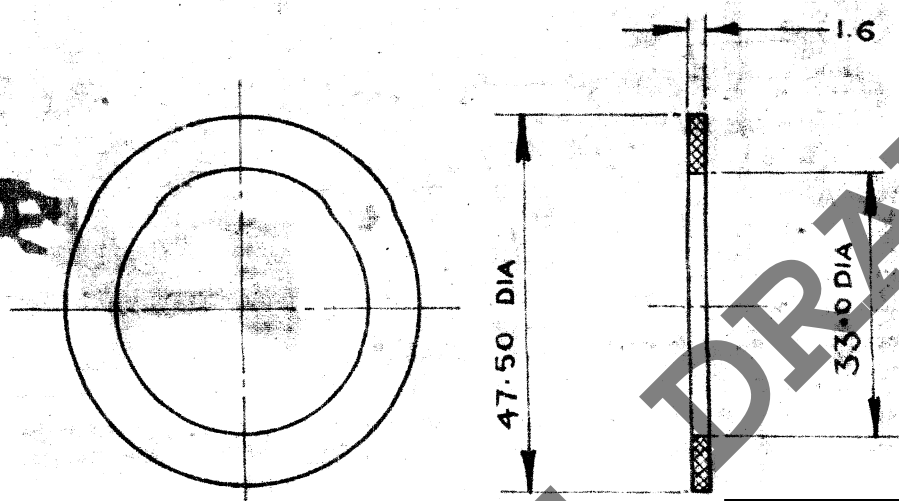

Note:-These Drawings are only for reference. Actual drawings may be different and shall be issued at the time of procurement.

~~MATL:- SUBBAGLEX SHEETING QUALITY TMT~~  
~~OR APPROVED ALTERNATIVE~~  
**NEOPRENE RUBBER TO SPECN. IND/ME/884 (PROV.) C-3**

3	24-11-79	-	AMENDED VIDE AL NO 367						
2	15-73	-	RETRACED AND AMENDED VIDE AL NO 186	RAW					
1	11/69	-	ORIGINAL ISSUE.		4	25-8-95	AL. NO 23/95		
R.NO	DATE	ZONE	BRIEF RECORD	INITIAL	R.NO	DATE	ZONE	BRIEF RECORD	INITIAL

	DATE	INITIAL	DIMNS. IN MM	D.T.D.&P.(AIR) MINISTRY OF DEFENCE
DGN			MATL. SPEC. AS STATED	
DRN		G.LAL		
CHD		P.N.C.	I.A.F. SEC. REF. NO.	
TCO		W.M.	ASSY. DRG. NO. ARM 1172A15	APPROVED <i>R. V. V. V.</i>
COMP			DRG. SCHD. NO. ARM 1172 / ARM 1302	
SCALE:- 1:1		TITLE:-		DRG. NO. ARM 1172A17
TOL:- TOL. EXCEPT WHERE OTHERWISE STATED ± .25		WASHER		

TOT