


Ritningsändring	-								
Produktförändring	F								

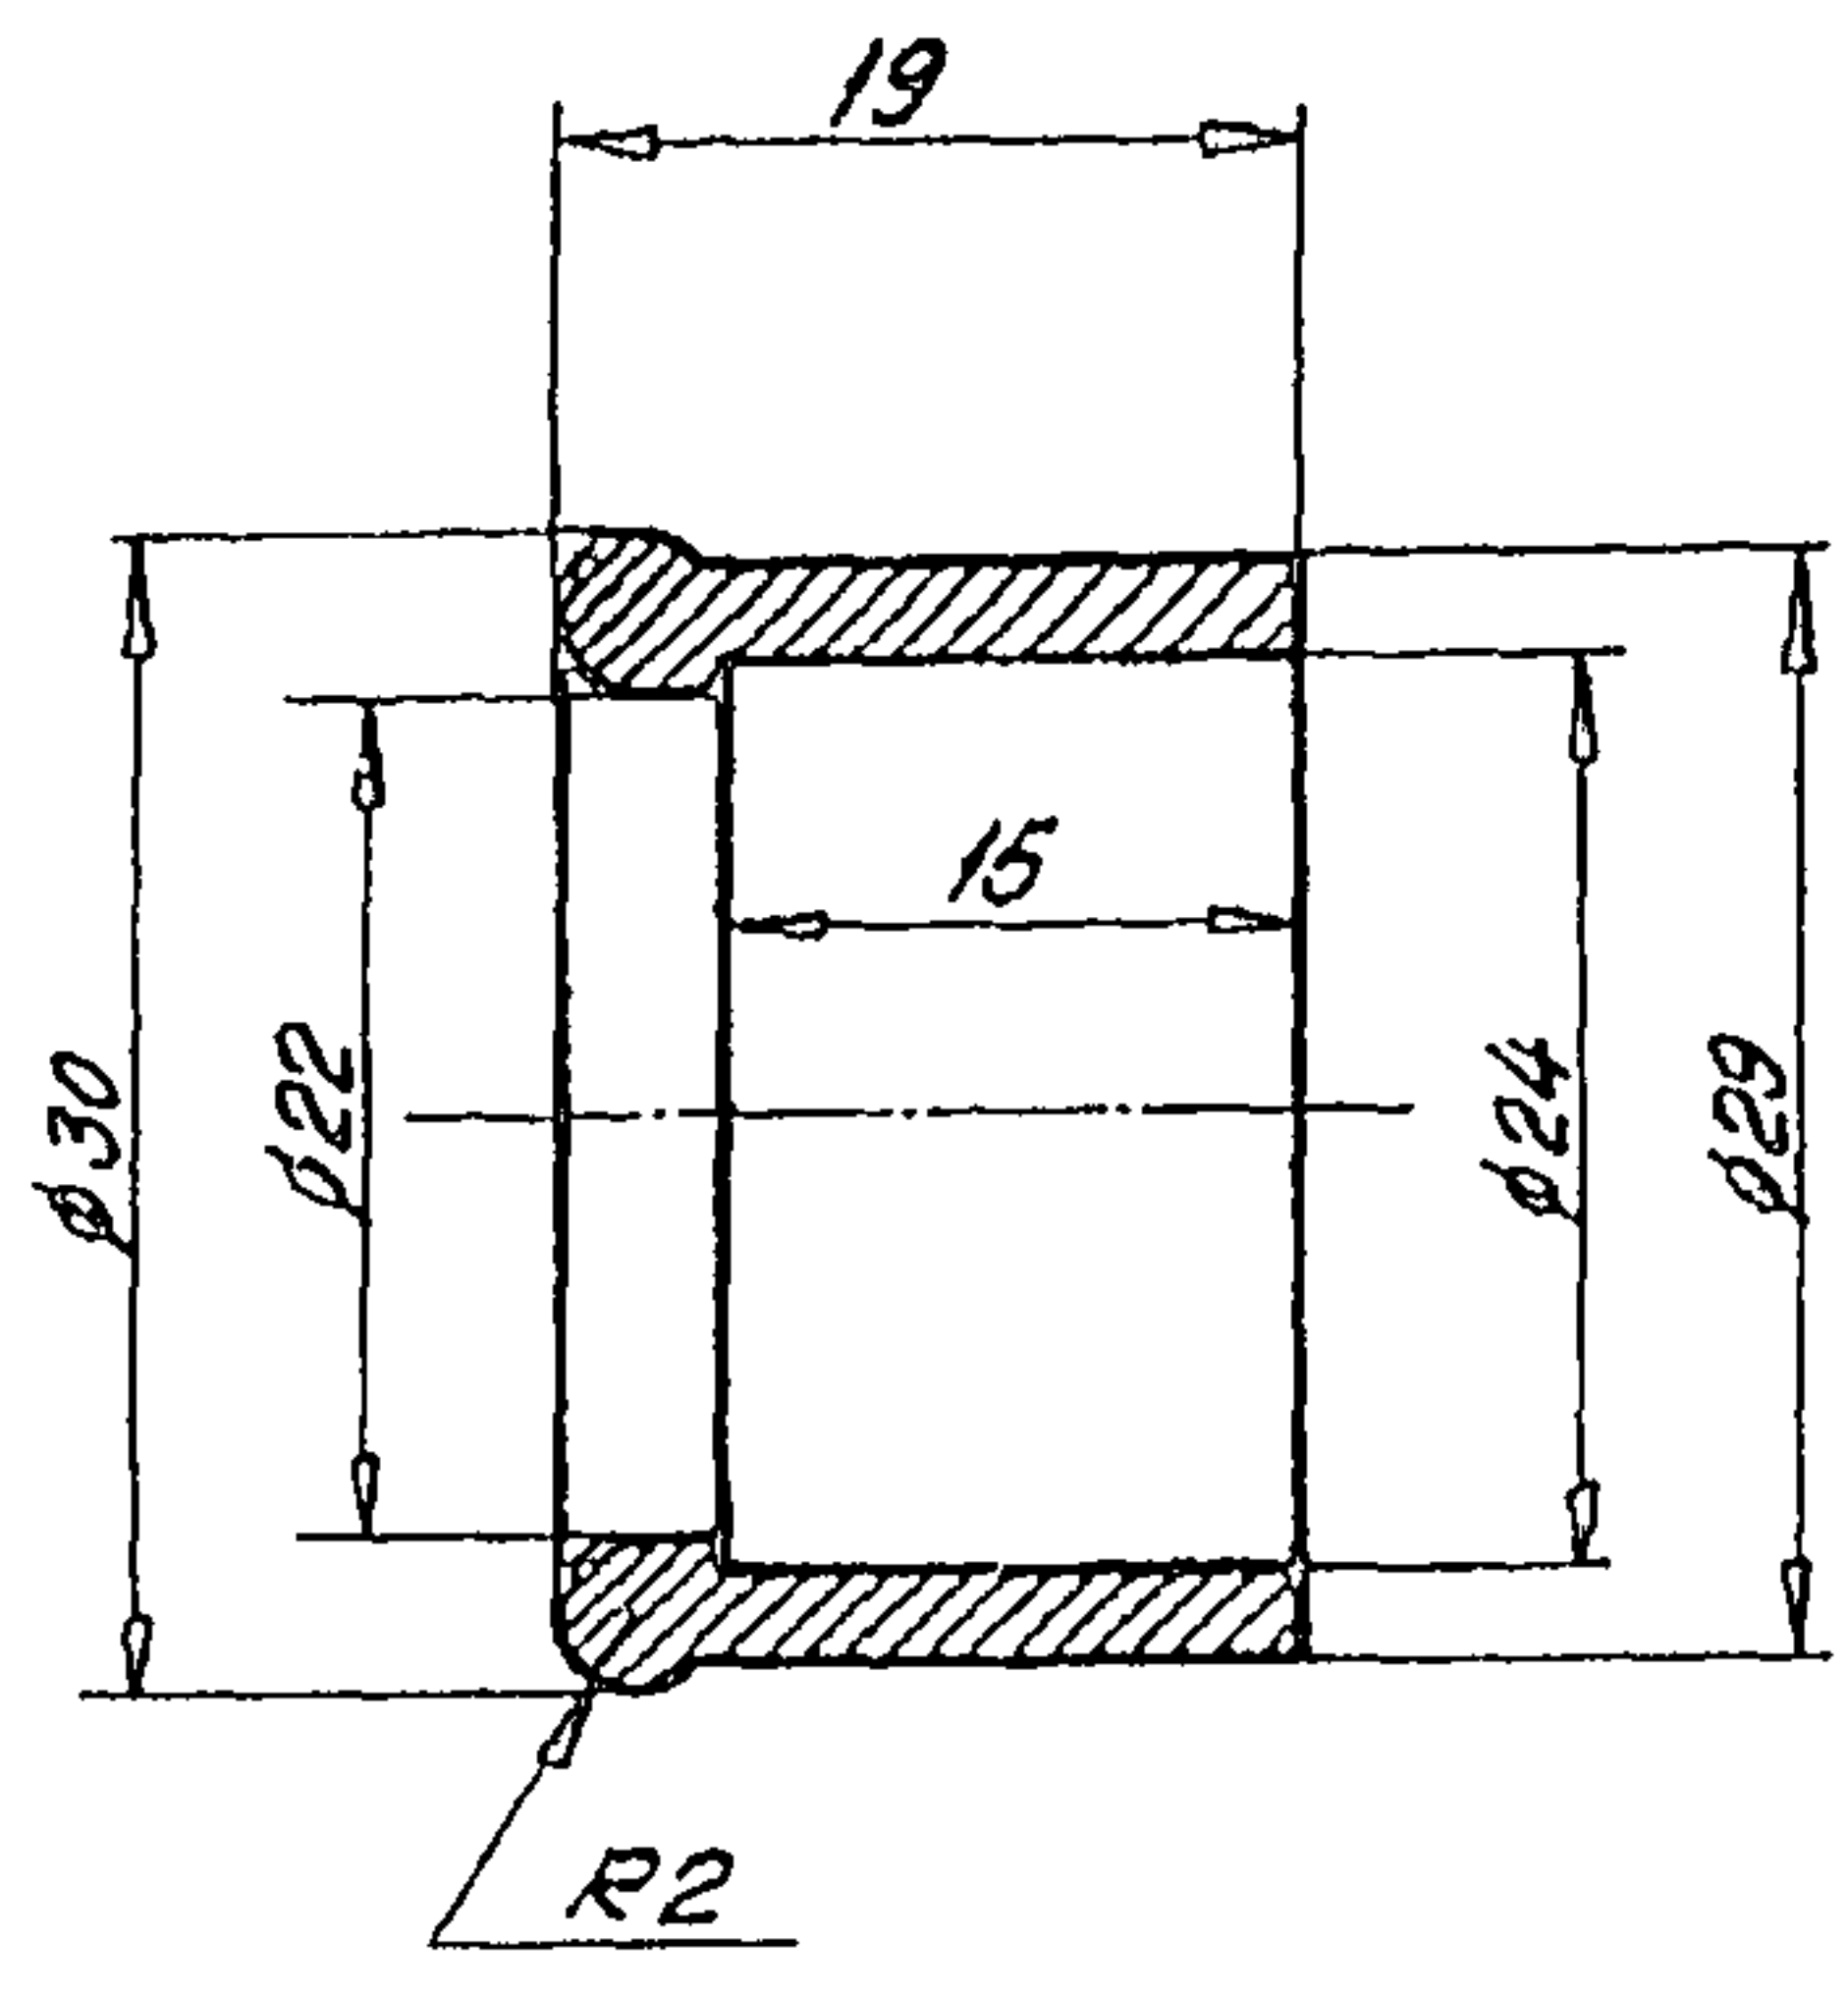

(a) D. C. - 2750-ICP) - DRG. NO. AMENDED.	<i>[Signature]</i>	<i>[Signature]</i>	6.12.11
D. C. - 2423-I (P) DRG. PROV. SEALED	<i>[Signature]</i>	<i>[Signature]</i>	18.7.07
AMENDMENTS	2HD	SIG.	DATE

ANTALE PRODUKT: /
 MATERIALKVALITÉ: *D: ok rubber, parturen, shore 60-70*
 VÄRMEBEHANDLING: —
 YTBEKÄFFENHET: —
 YTBEHANDLING: —
 GRÄDNING: ENL. ~~FFV 66~~ *Part shall be free from flash, burrs, dents and similar faults*
 LÄGSMÄTT: ENL. ~~FFV 212~~
 MÄRKNING: —
 TEKN. BESTÄMMELSER: —

Ritad <i>OL</i>	Gransk.	Kop. <i>OL</i>	Godk. <i>[Signature]</i>	Konstr.	Vyplöcningsmetod europaisk	Skala <i>2:1</i>
Datum <i>27-10-63</i>	Stand. gr.	Kop. gr. <i>KL</i>	Datum	Erstatter		

PRODUKT *Acc. f. 84 mm RCLM, Telescopic Sight 230141*
 NAMN *Edge cover*

FORSVARETS FABRIKSVVERK
 CARL GUSTAFS STADS GEVÄRSFAKTORI
 DRG. NO. *CQ A(1)-793/1*

Conforms to CBS 4193
 D.C. - 2423-I (P) - 2750-ICP)
 DRG. VETTED BY RM: *A2*