

DIMENSIONS ARE IN mm.

UNTOLERATED DIMNS. AS PER IS : 2102 (MED)

ALL SHARP EDGES TO BE REMOVED

A


B

C

D

E

F

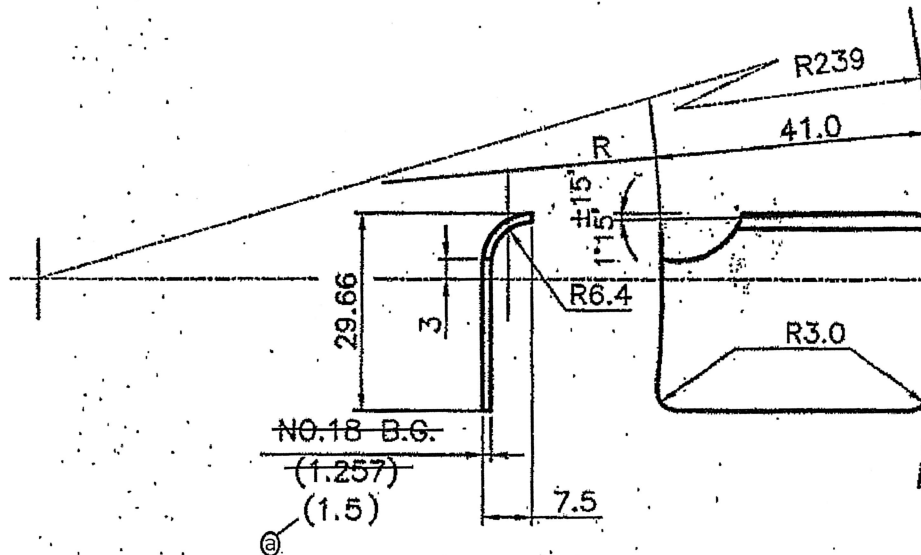

MATERIAL:-

6061/6063

ALUMINIUM ALLOY SHEET ~~5086-1132~~

~~PER AMS QQ-A-250/7~~

1.5 mm THICK SHEET

(NODAL OFFICER
FOR TAR)

DA.No.50/19
Dt.:09/12/19

AMENDMENTS
SIG. & DATE

LH LUG		AS ABOVE			
PART NO.	DESCRIPTIONS	NO OFF	MATERIAL	TREATMENT	REMARKS
	SIGNATURE & DATE	SUB: LH LUG			SCALE NTS
TRACED		FOR: Aluminium MAGAZINE			STORE DRG.NO. K-7013
DRAWN		OF: TRICHY ASSAULT RIFLE			OPERATION NO.
CHECKED		DES.REF.NO.			
HOS/D&DO	P. T. K.	DRG. No.: TAR-K-7113 *			
OFFICER/PRODN.		ORDNANCE FACTORY TIRUCHIRAPPALLI-16.			SHEETS: 1
OFFICER/D&DO	C. K. A.				SHEET No.: 1
APPROVED ON. 11/11/2019					