



SCALE 1:1

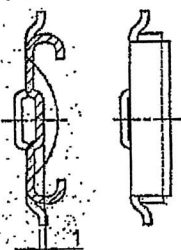


SECTION "A-A"

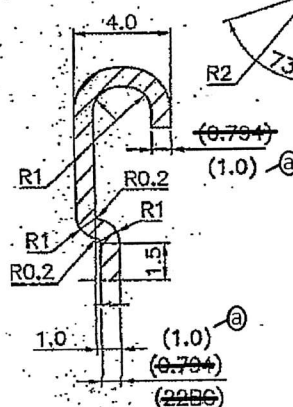


ENLARGED VIEW OF SEC 'A-A'

SCALE 10:1


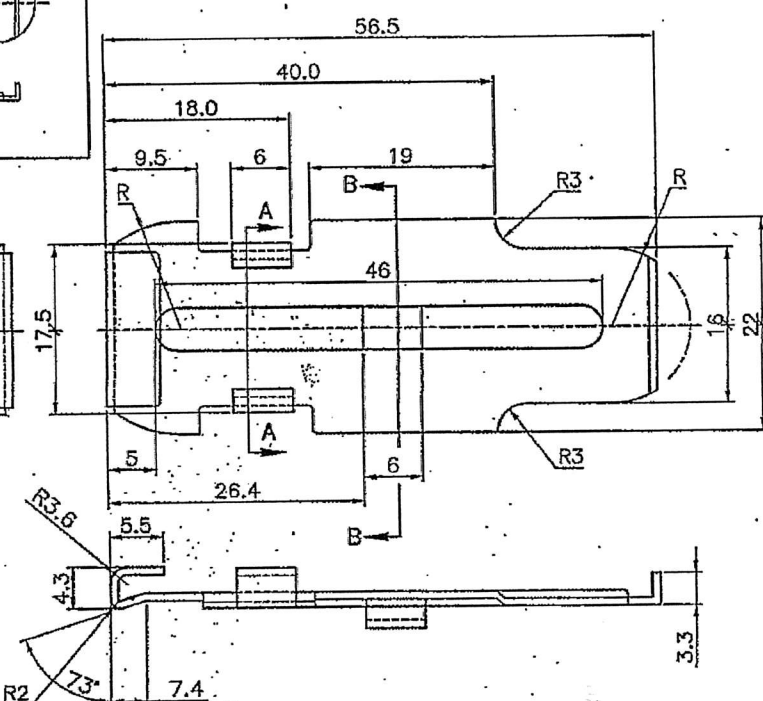


FINISH:-ON ASSY

DIMENSIONS ARE IN mm.
UNTOLERATED DIMNS. AS PER IS : 2102 (MED)
MARK DRAWING No.

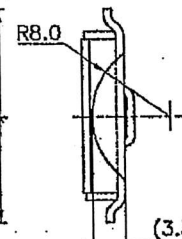

SECTION 'B-B'

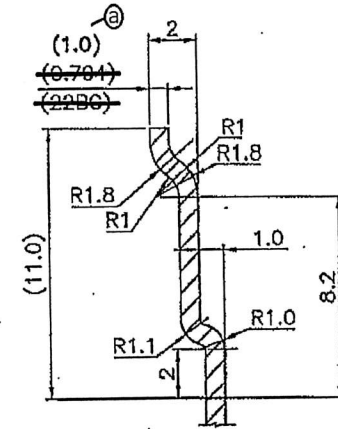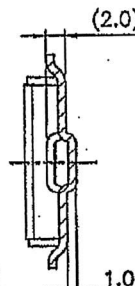

ENLARGED VIEW OF SEC 'B-B'
SCALE 10:1

ALL SHARP CRNERS TO BE REMOVED

MATERIAL:- 6061/6063
ALUMINIUM ALLOY SHEET ~~5088-152~~
~~PER AMS QQ-A 250/7~~
1 mm THICK SHEET

		. PLATE GUIDE SPRING					
(NODAL OFFICER FOR TAR)		PART NO.	DESCRIPTIONS	NO OFF	MATERIAL	TREATMENT	REMARKS
DA.No.50/19 Dt.:09/12/19 (a)			SIGNATURE & DATE.	SUB: PLATE GUIDE SPRING			SCALE
		TRACED		FOR: Aluminium MAGAZINE			
		DRAWN		OF: TRICHY ASSAULT RIFLE			STORE DRG.NO. K-7032
		CHECKED:		DES.REF.NO.			OPERATION NO. -
		HOS/D&DO	P-Tark	DRG. No.: TAR-K-7132 *			
		OFFICER/ PRODNL		ORDNANCE FACTORY TIRUCHIRAPPALLI-16.			SHEETS: 01
		OFFICER/ D&DO	C-K	(FT)			SHEET No.: 01
AMENDMENTS		SIG.	APPROVED ON, 11/11/2019				