


TOLERANCE ALL OVER - J13.

AMENDMENTS.			
REV.	DATE.	DESCRIPTION.	SIGN.
	21.11.74.	D.A. NO. 53/74.	
B			
C	4.6.87	D.A. NO. 226/87	EY

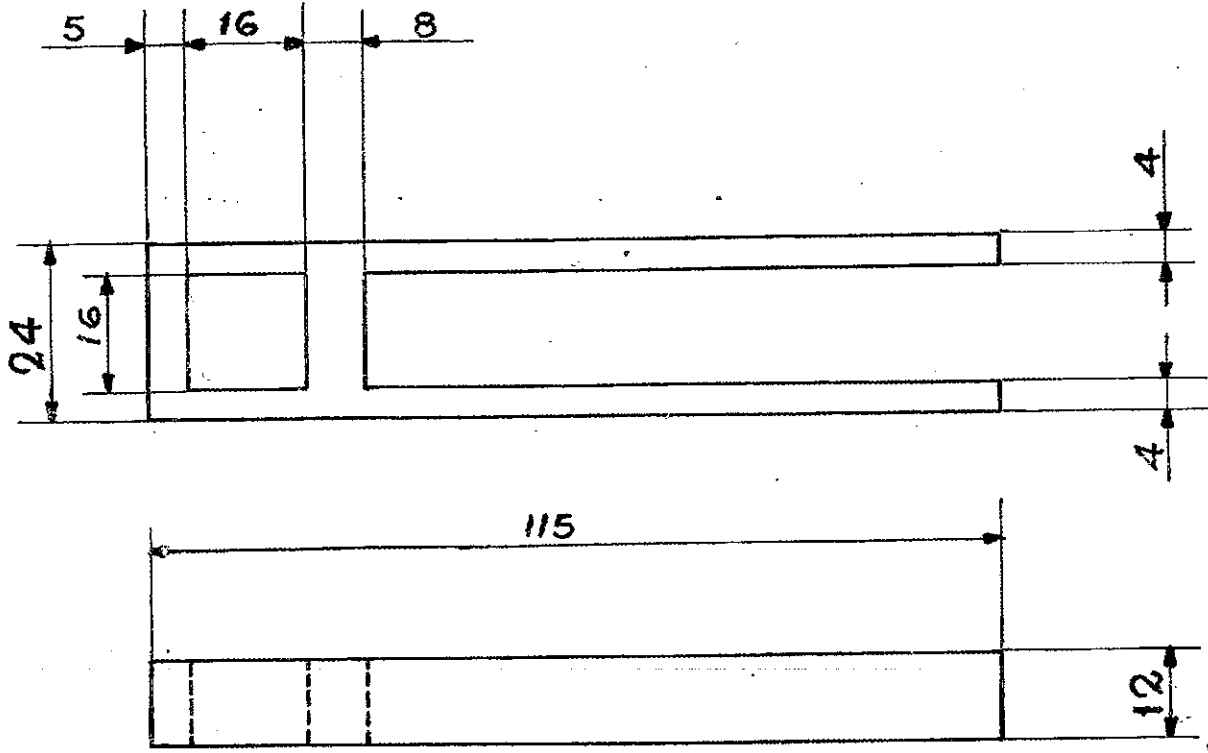

**CHEMICAL COMPOSITION**  
Al. 98.5% Min.  
Mg. 0.7% Max.  
OTHER IMPURITIES 0.8% Max.

**MATERIAL:**  
PURE ALUMINIUM,  
EXTRUDED SECTION  
~~TO SPECIFICATION~~  
~~BS 1474 E1B OR E1C~~

DIMNS: ARE IN 'MM':		MATERIAL: AS STATED.		ORDNANCE FY,	
SCALE: 1:1.				AMBAJHARI.	
DRN.	NAME	DATE	PROJECTION:	DRG. NO:	
TRCD.	RAKISWAL	4-8-72	3RD. ANGLE.	F.S. 338 'C'	
CHKD.			COMPONENT HOLDER		NO. OF SHEETS: 1.
I/C.D.O.			FOR ANODISING		SHEET NO: 1.
APPROVED:			TREATMENT.		
for G.M.			STORE:		
			VARIOUS		