




SCALE :1:1

DIMENSIONS ARE IN mm,
UNTOLERATED DIMS. AS PER IS : 2102 (MED)
IMPORTANT DIMS. MARKED THUS 'T'.

MARKING ON TAG :
YEAR OF MANUFACTURING,
MANUFACTURER'S CODE &
DRG. NO.

WIRE DIA: 0.4
WOUND : R.H. 11.5
NO. OF EFF.COILS : 4
NO OF COILS - 13.0^{+0.5}
MEAN DIA - 4.4 ± 0.2
SOLID LENGTH - 5.2
STRESS RELIEVED

ONE COIL AT EACH END TO BE
CLOSED IN AND GROUND SQUARE
TO THE AXIS OF THE COIL LEAVING
3/4 OF THE COIL AT EACH END
NON-EFFECTIVE

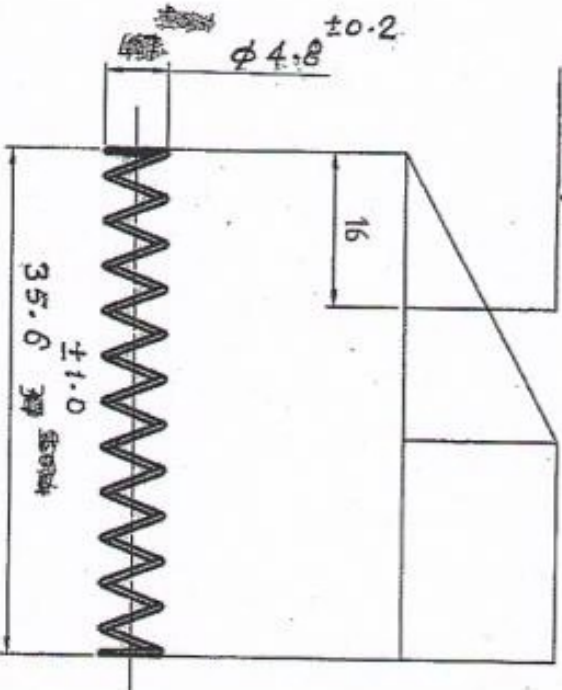

THE SPRING TO WORK FREELY IN ITS LOADED AND UNLOADED
CONDITION OVER A ROD OF DIA.3.85
CRAMP TEST: THE SPRING TO BE COMPRESSED TO A LENGTH
OF 16mm FOR A PERIOD OF 12 HOURS BEFORE GAUGING.

MATL:- STEEL IS:4454 PART 1-2091 GR. ¹DM

DRG. PROVISIONAL.

PART NO.	DESCRIPTIONS	NO OFF	MATERIAL	TREATMENT	REMARKS
	SUB: FIRING PIN SPRING				SCALE NTS
	FOR: 14.5mm BOLT ASSY.				STORE DRG.NO.
	OF: 14.5mm/20mm AMR.				OPERATION NO.
	CHECKED: <i>[Signature]</i>				SHEETS: 1
	DRAWN: R. Ringe				SHEET No.: 1
	TRACED:				
	SIGNATURE & DATE:				
	DESIGNER/PRODN. OFFICER/ D&DO				
	OIC/D&DO				
	OFFICER/PRODN. OFFICER/ D&DO				
	APPROVED ON: 03/2005				
	SIG.				
	AMENDMENTS & DATE				



ORDNANCE FACTORY
TRICHIRAPPALLI-16.


DRG. No.: 44P 14005 * 2

DA.No - 084/19
DA: 8/7/19
DA.No: 001/19


CERTIFIED CORRECT COPY
OF APPROVED DRAWINGS
OF THIS DRAWING
92019
Design & Drawing Office
Ordnance Factory,
Trichirappalli-621016.

*90041 PHF. ON. NO.

DIMENSIONS ARE IN mm,
 UNTOLERATED DIMS. AS PER IS : 2102 (MED)
 MARK DRAWING No.
 SHARP CORNERS TO BE BLUNT TO RO.2.

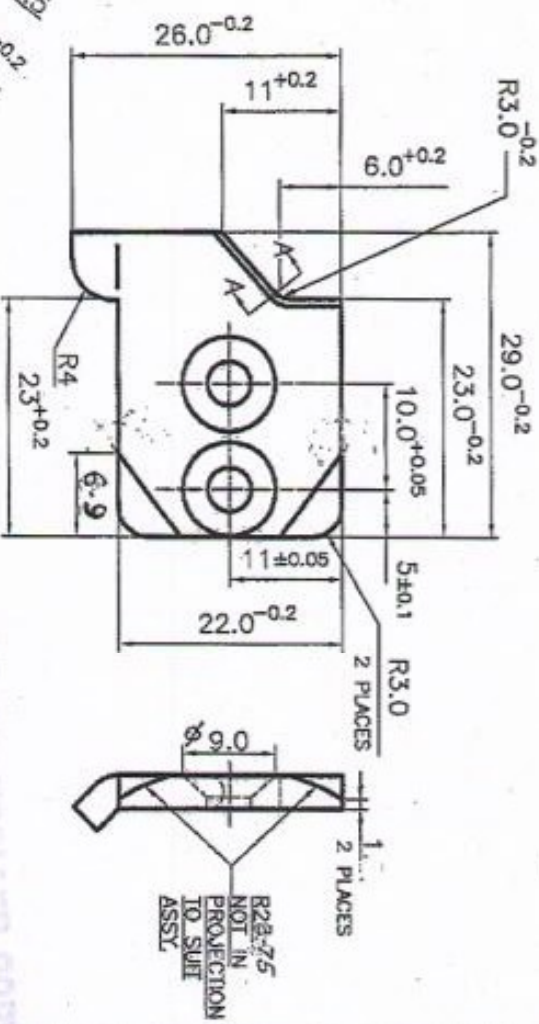

SECTION 'A-A'

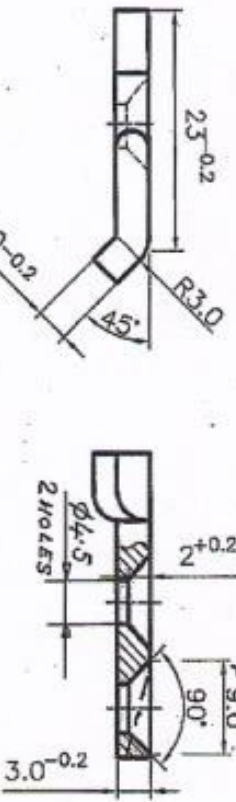

MATERIAL: 30X H2M ΦA, HARDNESS: 260-300 HB.
 ALT. MATL: BS. 970 PT. 1-1983 GR. 826 M31 (OR) EN 25
 (OR) IS: 5517-1993, DESIGN. 31 Nf 10 Cr3 Mo6

PART NO.	DESCRIPTIONS	SIGNATURE & DATE	NO OFF	MATERIAL	TREATMENT	REMARKS
	TRACED					SCALE NTS
	DRAWN	<i>B. Sankar</i>				STORE DRG. NO.
	CHECKED	<i>Libon S. Jeyaraj</i>				OPERATION NO.
	OIC/D&DO					
	OFFICER/PRODN.					
	OFFICER/D&DO					
	APPROVED ON: 3/05/2007					

DR. NO. 006/07

4/10/07

Sl. No. 20
 DA. No. 02/19
 30.3.19

AMENDMENTS & DATE

sub: HAMMER CAM PLATE
 FOR: 14.5MM BOLT ASSY.
 OF: 14.5MM/20MM AMR.
 DES. REF. NO.
 DRG. No.: 44P 14006*
 ORDNANCE FACTORY
 TRUCHIRAPPALLI-16.
 SHEETS: 1
 SHEET No.: 1


DM CONTROLLED COPY

CERTIFIED CORRECT COPY
 OF APPROVED DRAWINGS
 AT TRUCHIRAPPALLI

Design & Production
 Ordnance Factory,
 Truchirappalli-160016

*Z0071 P4P ON GRD

DIMENSIONS ARE IN mm.
 UNTOLERATED DIMNS. AS PER IS : 2102 (MED)
 MARK DRAWING No.

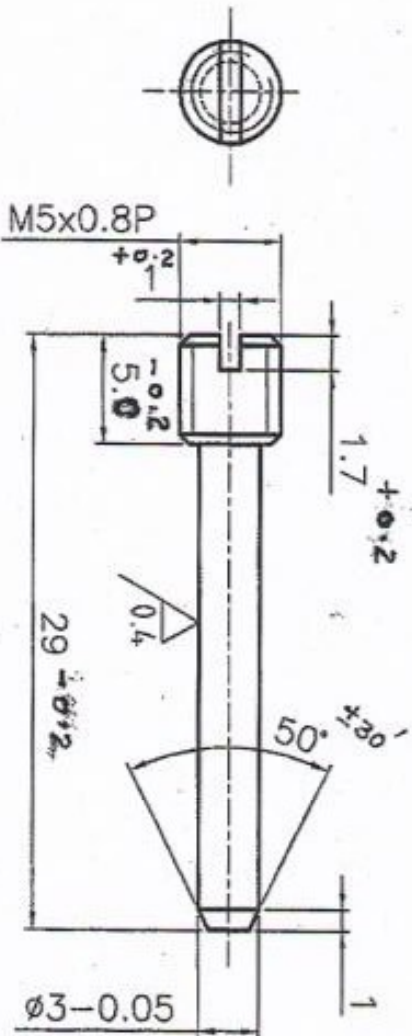

65 C2 BA.W, OCT-3-98-80

MATERIAL: ~~65 C2 BA.W, OCT-3-98-80~~ HARDNESS: 280-320HB
 HARDNESS: 51-61 HRC3

NOTE: STRESS RELIEVING AT 180°C FOR 45 MIN.

PROTECTIVE FINISH: PHOSPHATED TO SPECIFICATION

JSS : 0465-01-1988 CLASS II (ACCELERATED) OIL FINISH.

16 / [0.4]

DRG. PROVISIONAL

PART NO.	DESCRIPTIONS	SIGNATURE & DATE	NO OFF	MATERIAL	TREATMENT	REMARKS
	TRACED					
	DRAWN	<i>R. Gupta</i>				
	CHECKED	<i>V. Srinivas</i>				
	OIC/D&DO					
	OFFICER/PRODN.					
	OFFICER/D&DO					
FOR: 14.5mm BOLT ASSY. OF: 14mm/20mm AMR.		SUB: FIRING PIN RETAINING PIN		SCALE NTS		STORE DRG.NO.
DES. REF. NO.		DRG. No.: 44P 14007*		ORDNANCE FACTORY TRUCHIRAPPALLI-16.		OPERATION NO.
AMENDMENTS & DATE		APPROVED ON: 07/05		SHEETS: 1		SHEET No.: 1

DR. NO. 006/07

4/10/07

DRAWN: 28-5-19










28-5-19

AMENDMENTS & DATE

APPROVED ON: 07/05



ORDNANCE FACTORY TRUCHIRAPPALLI-16.

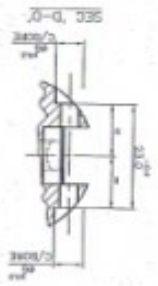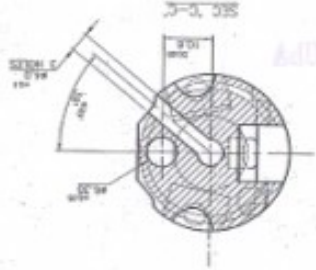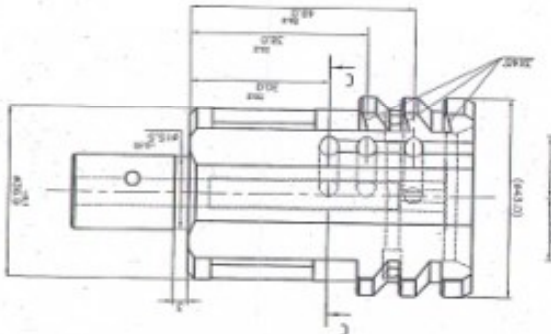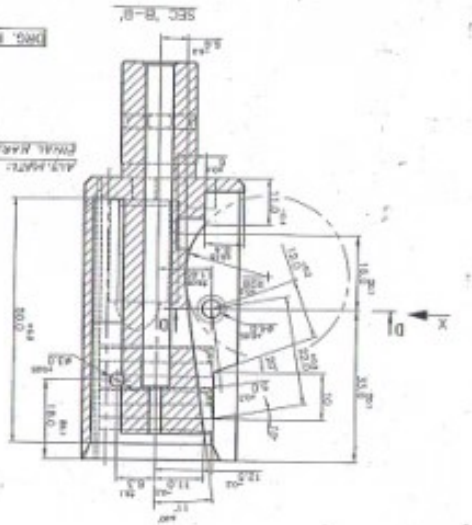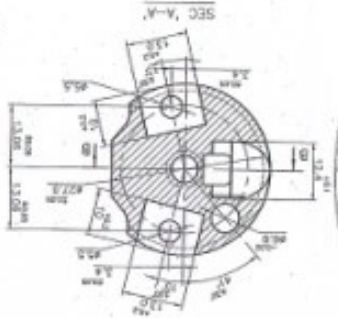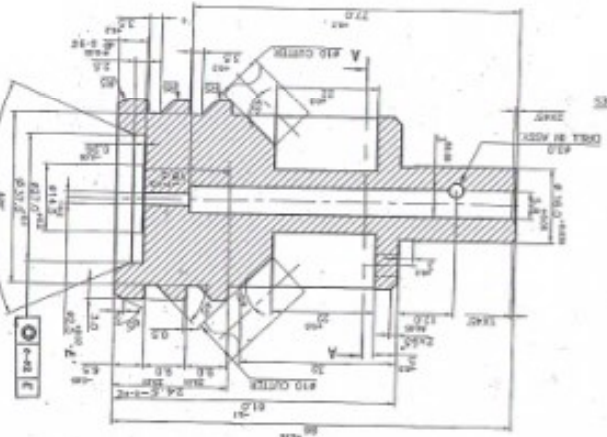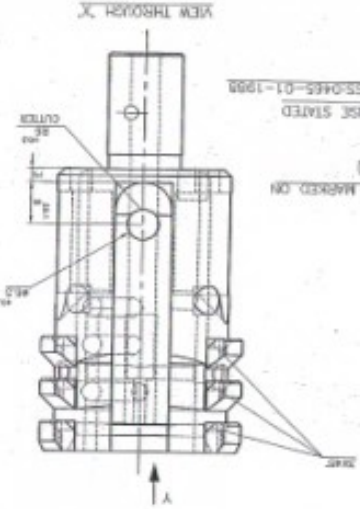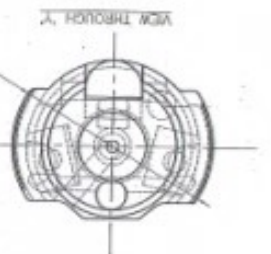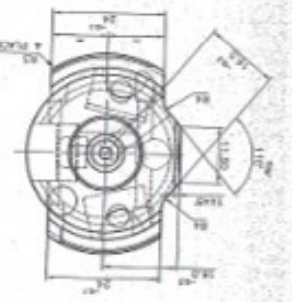

REV.	DATE	BY	CHKD.	DESCRIPTION
1				ISSUED FOR FABRICATION
2				REVISION
3				REVISION
INDICATED DIMENSIONS MARKED THIS WAY TO BE MARKED ON
DIMENSIONS ARE IN INCHES
SURF CORNERS SHOULD BE BLUNT TO R0.5
ANGULAR TOLERANCE ± 0.005 UNLESS OTHERWISE STATED
CLASS 1 (ACCELERATED) OIL FINISH
MATERIAL SPECIFICATION: 303-304 SS
HARDNESS: 280-320 HB

PROVISIONAL

ALUMINUM: 6061-T6 PER MIL-1793 OR 6061 M40 (C0) PER MIL-8838

DATE: 10/27/19
BY: [Signature]
CHKD: [Signature]



CONTROL CENTER OF AIR FORCE RESEARCH AND DEVELOPMENT

*6001 44P DRG.NO.

ALY. MATL :-
BS-970 Pt-2, 1983 GR. 925 A 60 WITH C% 0.60 TO 0.63, S% & P% 0.015 MAX.
EACH (ESR QUALITY STEEL)

DIMENSIONS ARE IN mm.
 UNTOLERATED DIMNS. AS PER IS : 2102 (MED)
 MARK DRAWING NO.

NOTE: ALL SHARP CORNER TO BE BLUND TO R0.2

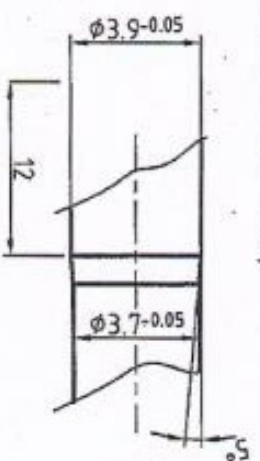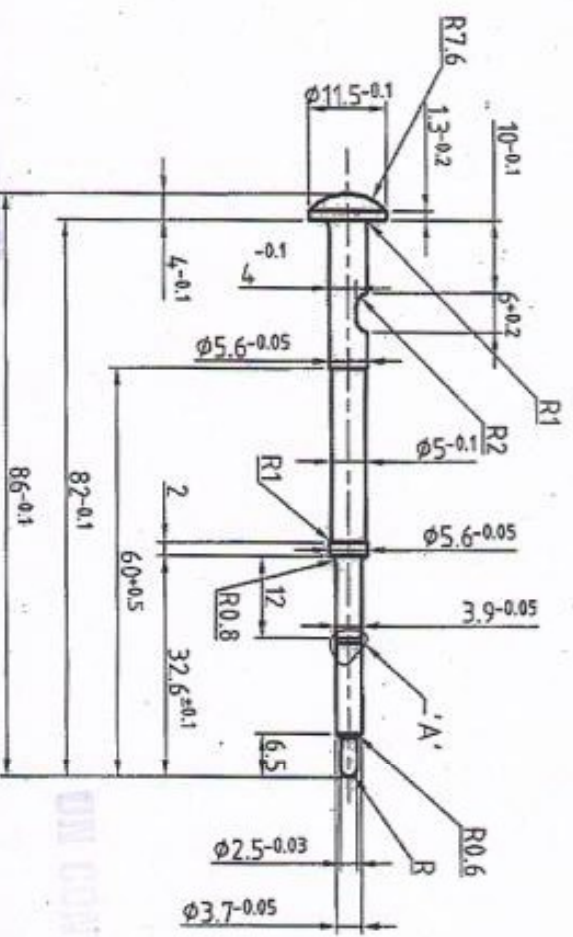

65 C2 BA-W, OCT-3-98-80 D ENLARGED VIEW AT 'A'
 MATERIAL: ~~65C2BA-H-XH-60SE-14963-79~~
 HARDNESS: 51-61 HRC3
 SURFACE FINISH:-PHOSPAIED TO SPECIFICATION. JSS:0465-01-1988
 CLASS-1 (ACCELERATED) OIL FINISH.

0.4

CERTIFIED CORRECT COPY
 OF APPROVED DRAWINGS
 AT THIS DATE
 Design & Development
 Ordnance Factory,
 Tiruchirappalli.

PART NO.	DESCRIPTIONS	SIGNATURE & DATE	NO OFF	MATERIAL	TREATMENT	REMARKS
	TRACED					SCALE NTS
	DRAWN	R. Narasimha				STORE DRG.NO.
	CHECKED	Johny S.				OPERATION NO.
	OIC/D&DO	Jandam.				
	OFFICER/PRODN.					
	OFFICER/D&DO					
	AMENDMENTS & DATE					

Cad 2/Prakash/cd/14009