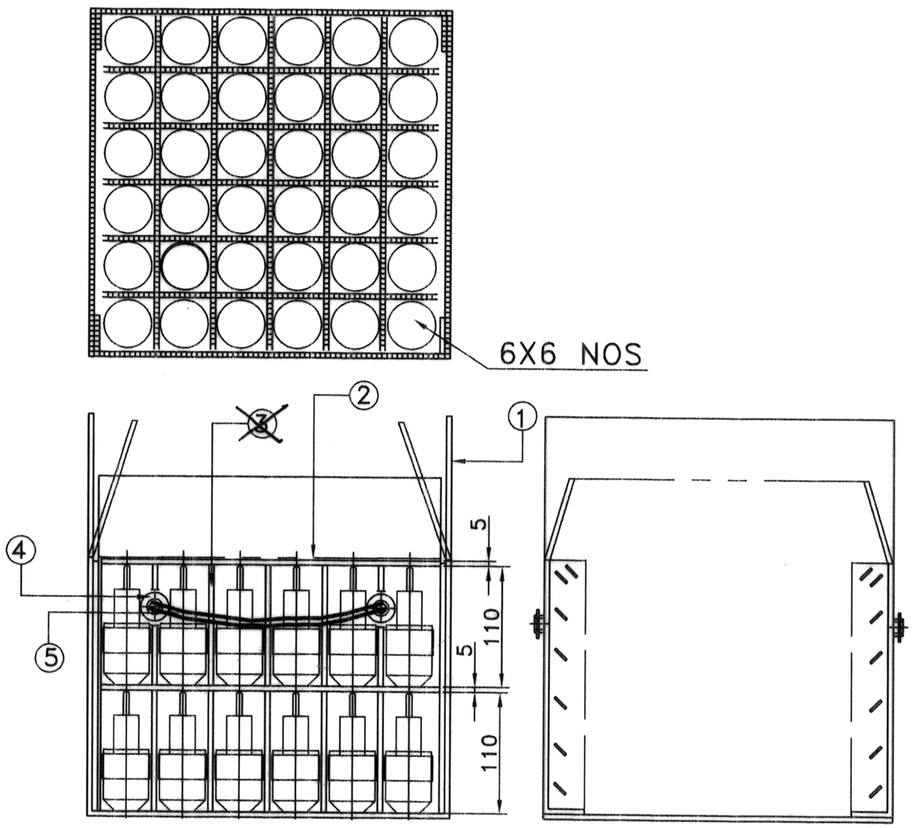

GENERAL ARRANGEMENT

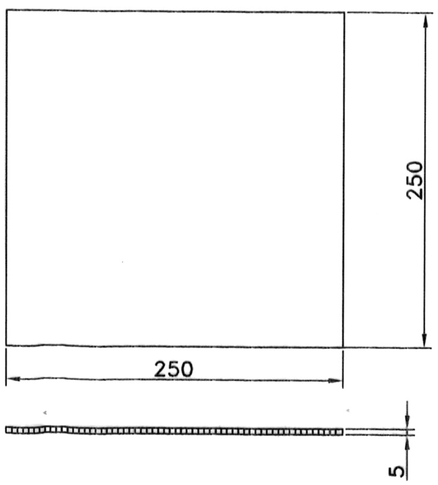

② SEPERATOR COVER

MATERIAL–
HIGH IMPACT CO–POLYMER
OF POLYPROPYLENE CORRUGATED
SHEET OF 5 mm THICK.&
DENSITY OF 900–1100GSM
IN BLUE COLOUR.
NO.OFF– 2

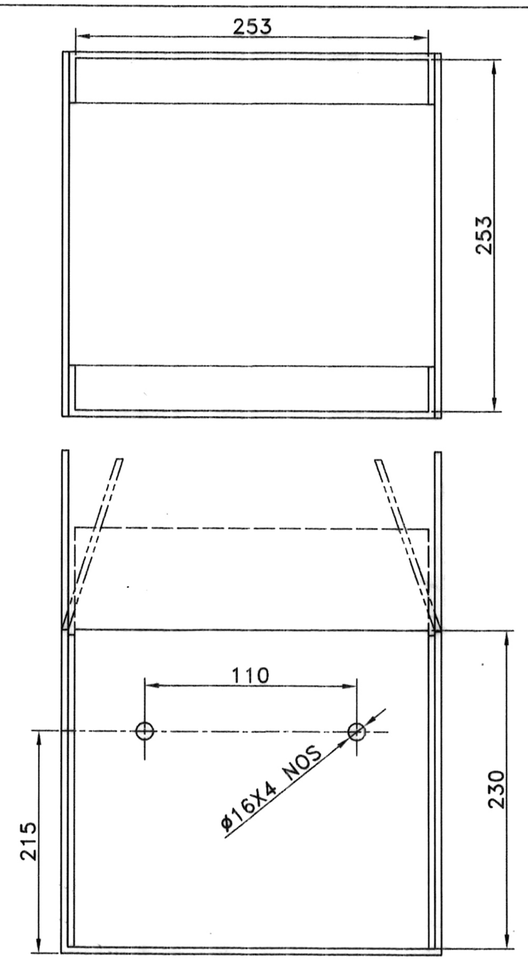

① BOX

MATERIAL–
HIGH IMPACT CO–POLYMER
OF POLYPROPYLENE CORRUGATED
SHEET OF 5 mm THICK.&
DENSITY OF 900–1100GSM
IN BLUE COLOUR.
NO.OFF– 1

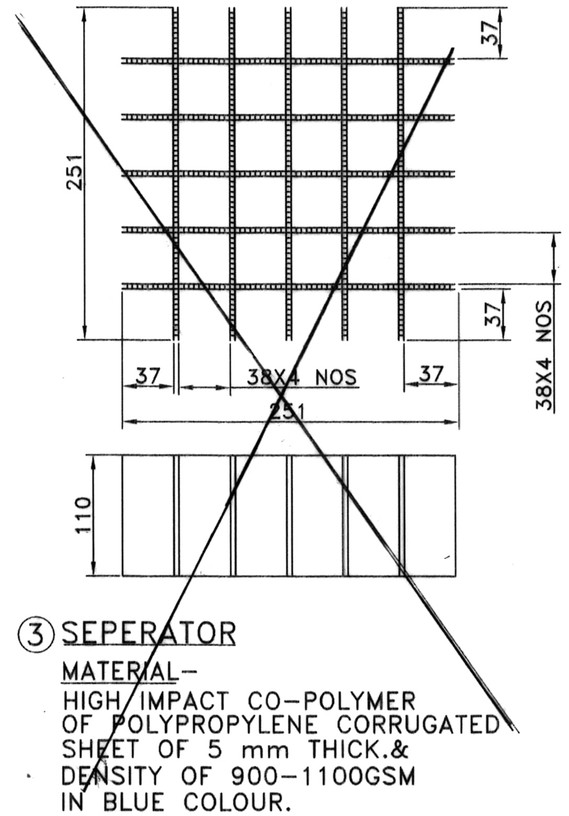

③ SEPERATOR

MATERIAL–
HIGH IMPACT CO–POLYMER
OF POLYPROPYLENE CORRUGATED
SHEET OF 5 mm THICK.&
DENSITY OF 900–1100GSM
IN BLUE COLOUR.
NO.OFF– 2

ITEM NO.	NO. OFF	MATERIAL	DESCRIPTION
5	2	NYLON	NYLON ROPE ø8X250 L
4	4	PBC	EYE LATE ø16
~~3~~	~~2~~	~~AS STATED~~	~~SEPERATOR~~
2	2	AS STATED	SEPERATOR COVER
1	1	AS STATED	BOX

LIST OF PARTS

DT.&SG.	DESCRIPTION
14/12/17 37/17 DA. NO.	*ITEM NO.3 DELETED & DRG. NO ADVISED TO 'A'
AMENDMENTS	

SCHEDULE NO :-
SCALE:–NTS | PROJECTION THIRD ANGLE
DRAWN BY : 25/07/08
TRACED BY :
CHECKED BY : 25/07/08
APPROVED BY : 25/07/08
CONCURRED BY: AWM/FUZE M / C :
SIGN DATE : 25/7/08

COMPT.:–B–15 PG. ASSY. | STORE DRG NO.

PACKING BOX FOR
B–15 PG ASSY.

DRG.NO– CO–485A

NO. OF SHTS.:–1
SHT. NO. :– 1
G. & S. FY. COSSIPORE.