CRAMP TEST FOR 14 HOURS.

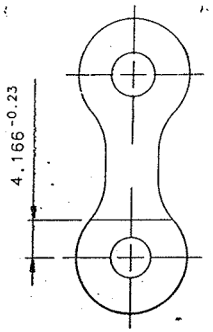

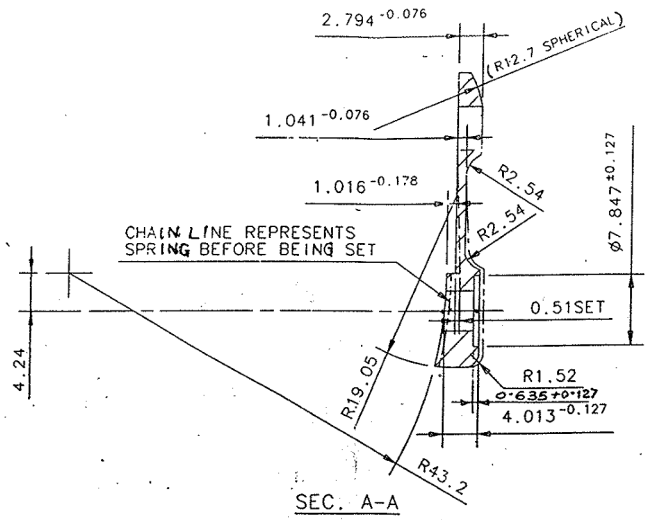

SEC. A-A

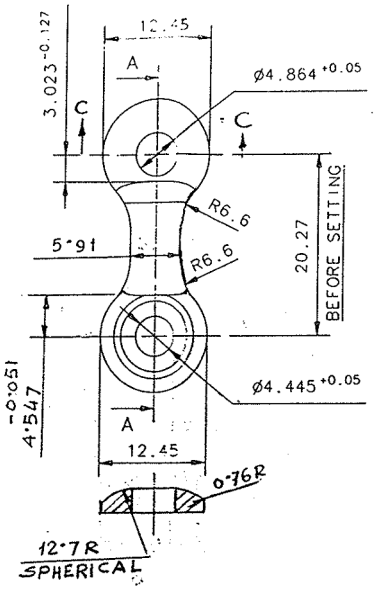

SECTION -C-C

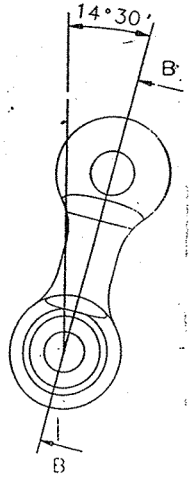

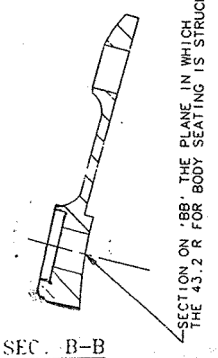

SEC. B-B

MATL: STEEL B.S.970 Pt.5:1972 GR.250 A-58

HRD. & TEMP. (480 –520 VPN REF.)

FINISH:–PHOSPHATE TO SPECN.
JSS:0465: 01–1988 CLASS 1. ~~PAINT RFU~~
~~STOVING BLACK TO SPECN. JSS 8010 37 MATT FINISH.~~

DIMENSIONS ARE IN mm.
IMPORTANT DIMENSIONS MARKED THUS ⊕
INFORMATION MARKED THUS † TO BE MARKED ON
UNTOLERATED DIMNS. AS PER IS : 2102 (MED)
MARK DRAWING No.

D.A.NO. 8996/14/DD(Q) dt. 29.5.09

AMENDMENTS	SIG. & DATE

PART NO.	DESCRIPTIONS	NO OFF	MATERIAL	TREATMENT	REMARKS
	SIGNATURE & DATE.				
	TRACED				
	DRAWN				
	CHECKED				
	OIC/D&DO				
	OFFICER/ PRODN.				
	OFFICER/ D&DO				
	APPROVED ON. 10/2004				

SUB: SPRING BOLT LOCKING
FOR: 0.315" SPORTING RIFLE
DES.REF.NO. SP-62
DRG. No.: 29P0062

ORDNANCE FACTORY TIRUCHIRAPPALLI–16.

SCALE 2:1
STORE DRG.NO.
OPERATION NO.
SHEETS: 01
SHEET No.: 01

4