DRAWING NUMBER
155 02 481

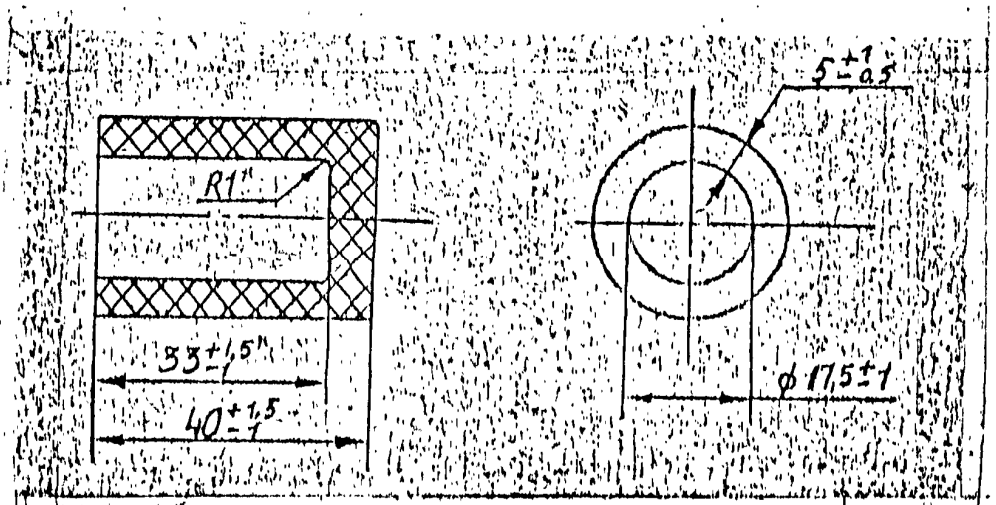

1. ALTERNATE MATERIAL : RUBBER 3311 TY ~~005216 - 75~~ 38-0051166-73.
2. * DIMENSIONS ARE TO BE ENSURED BY TOOL.
3. TO BE MARKED ON TAG.
4. THE REST OF THE REQUIREMENTS SHOULD BE AS PER TY 005216 - 75 ON ARTICLE OF CODE 253151.
5. THICKNESS VARIATION SHOULD BE WITHIN TOLERANCE.

INDIANISED DRG. PREPARED BASED ON ISSUE - NIL

F-16
49

PILOT SAMPLE SHOULD BE APPROVED BY A H S P BEFORE BULK PRODUCTION.

ISSUE	DATE	NATURE OF AMENDMENTS
A	1.12.88	SCT.L.No.0848726/139.Dt:25.8.88

DRN
CHD
TCD
APPD
DATE 03-03-88
SIZE A4

SCALE:- 1 : 1
DIMENSIONS IN mm

TOLERANCE ON DIMENSIONS UNLESS OTHERWISE STATED IS 2102 -69

ALL THREADS CONFORM TO

EST. WT. 0.04 Kg

TO BE STAMPED OR MARKED WHERE INDICATED THUS ⫩ (LETTERS)

ALL SHARP EDGES AND CORNERS TO BE REMOVED UNLESS OTHERWISE STATED MACHINED CORNERS TO HAVE R OUTSIDE R INSIDE EQUIVALENT CHAMFERS ARE PERMISSIBLE.

MATERIAL:- (A)
RUBBER 98-1 TY ~~005 216-75~~ 38-0051166-73.

USED ON
172 45 060 Cb Cb
175 41 008 Cb-1

CONTROLLERATE OF QUALITY ASSURANCE (HEAVY VEHICLES) AVADI.

TITLE END CAP

D S CAT NUMBER

DRAWING NUMBER
155 02 481