FOR EXPLANATION OF DIMENSIONING ETC. SEE CHARM NOTE SHEET No. 1
FIRST ANGLE PROJECTION. DIMENSIONS ARE IN mm

Tolerances	Allowances
76H9	0,005 / 0,074
85s7	0,05 / 0,071

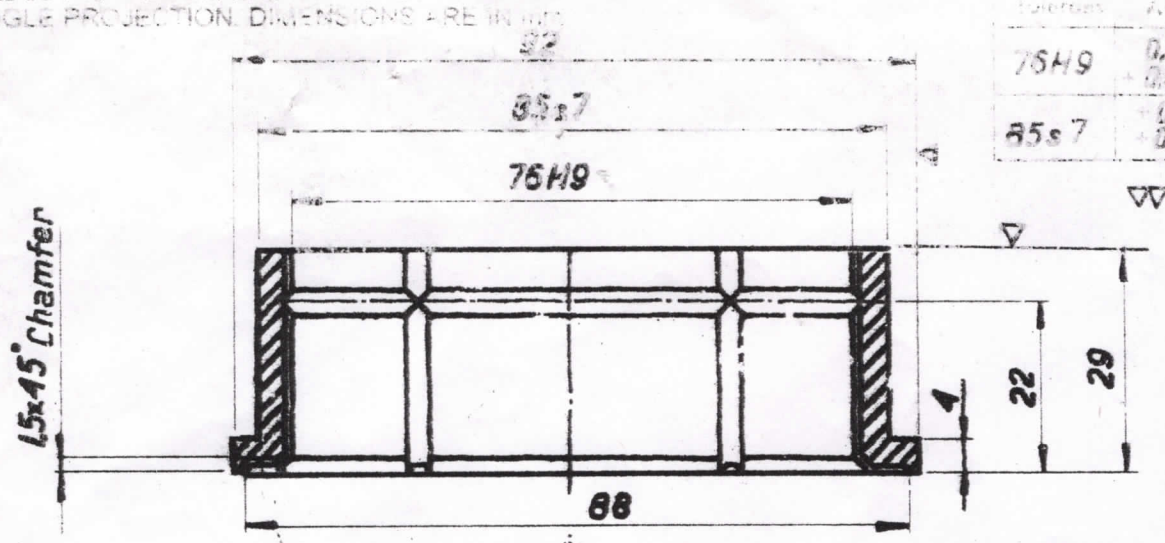

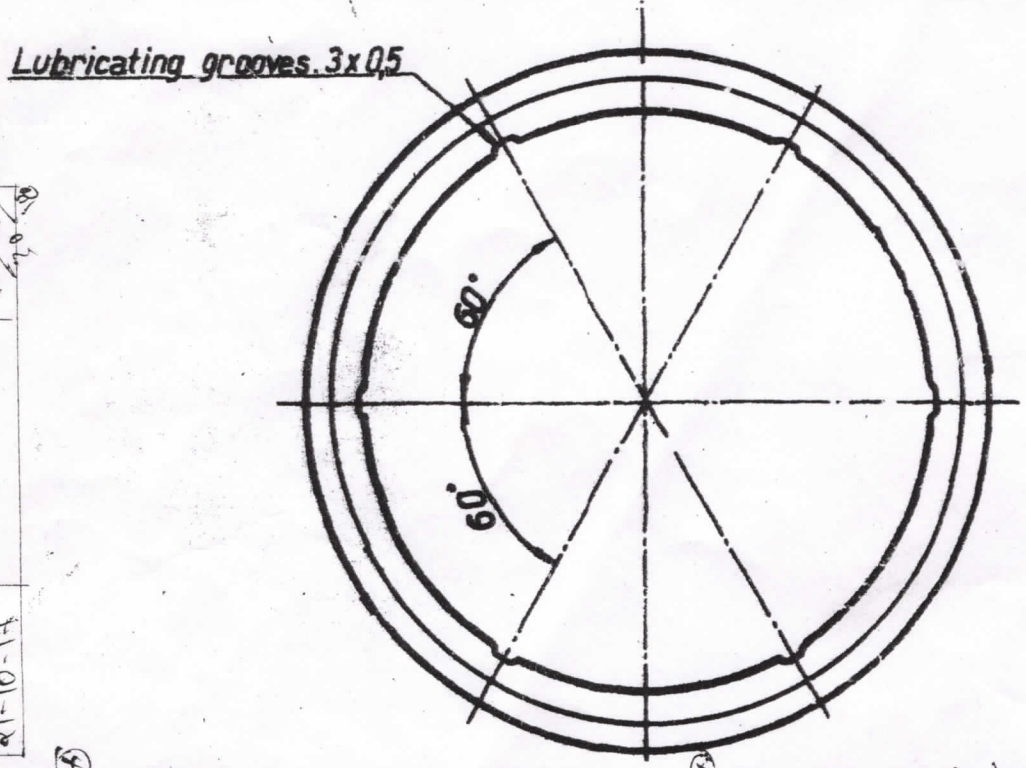

MATL. AMENDED 19619 W1 21-10-17

ALTERNATE MATERIAL :- ~~BS: 1400 PB - 1C~~ BS:1400 PB1 (OR) CASTING EN 1982: 1998-CC483K

METHOD OF CASTING:- ~~CENTRIFUGAL CASTING~~ (OR) IS: 28-1985 GRADE 2, SAND CAST

DATE	AUTHORITY	AMENDMENTS	SIG AHSP	SIG DO
22-02-16		SCANNED & PRINTED WITHOUT CHANGE		

PREV DCs :- 7814-W, 14447-W, 18883-W & 18954-W DATED 20-04-06

DRG SEALED PROV :-	SCANNED - MK	CHECKED :- JLC	C'D/MAN
7814-W DATED 09-02-61			

CQA(W) JABALPUR

						Bush बुश		BML13	-	Verkt.-nr 0,31
			5-938 IC/5		40 MM AA GUN L/70 Centre platform	Benämning			Material	Behandl.	Ser. vikt kg
						Ritad	Kontr.	Datum	Skala	6105892	
						Gön	Leg	28.10.48	1:1		
DF-	Nr	Grupp	DF-	Nr	Grupp	Förs. ritn.				Tillk. ritn.	

AB Bofors äganderätt till denna ritning är skyddad genom lagen av den 30 maj 1919. Konstruktionen eller ritningen får ej utan bolagets medgivande bekantgöras, kopieras eller mångfaldigas, bringas till utförande eller i övrigt obehörigen utnyttjas.

AKTIEBOLAGET BOFORS