~~K-6/4520-000087~~ PIPE BURNER HEATER SPACE-OIL BURNING (7)

MATERIAL - M S PIPE 13·5 O/D X 5 0 I/D
1-PER SET
SCALE - 1 2

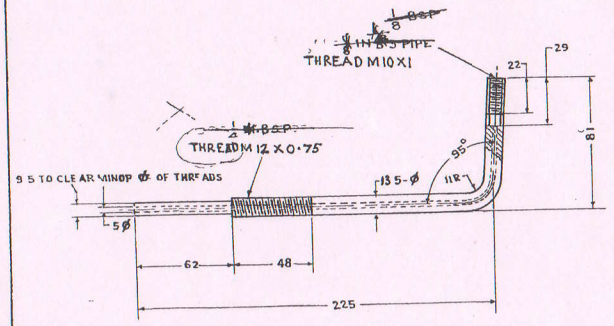

LOCK NUT (7A)

MATERIAL - MILD STEEL
1-PER BURNER PIPE
SCALE - 1·1

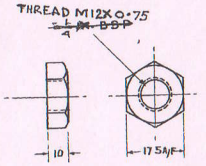

~~K-6/4520-000088~~ PIPE CENTRAL HEATER SPACE OIL BURNING (SUB-ASSEMBLY) (8)

1-PER SET
SCALE - 1 2

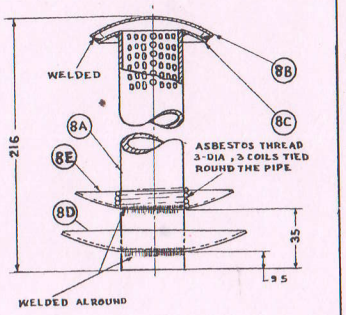

PIPE CENTERAL, BODY (8A)

MATERIAL - SEAMLESS PIPE
38 O/D X 35 I/D
1 PER CENTRAL PIPE

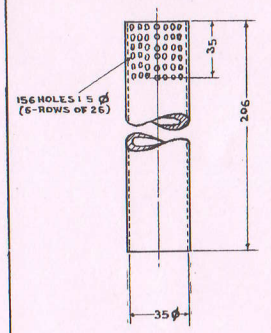

PIPE CENTRAL, CROWN PLATE UPPER (8B)

MATERIAL - MILD STEEL SHEET
=1 60 m·m
1-PER CENTRAL PIPE

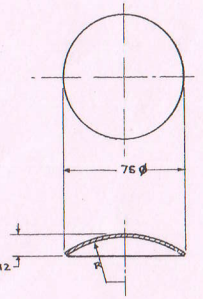

PIPE CENTRAL, CROWN PLATE LOWER (8C)

MATERIAL - MILD STEEL SHEET
-1 60 m·m
1-PER CENTRAL PIPE

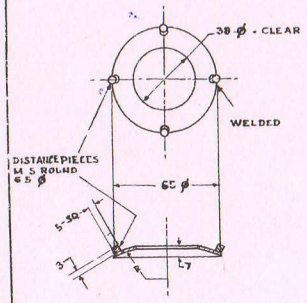

PIPE CENTRAL, DISH, LOWER (8D)

MATERIAL - MILD STEEL SHEET
=1 60 m·m
1-PER CENTRAL PIPE

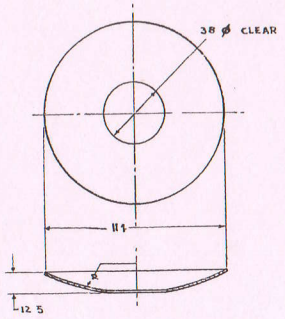

PIPE CENTRAL, DISH, UPPER (8E)

MATERIAL - MILD STEEL SHEET
=1 60 m·m
1-PER CENTRAL PIPE

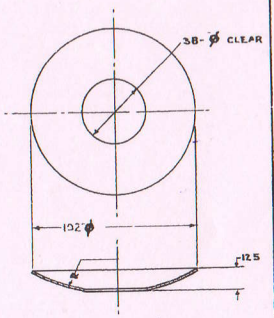

UNION NUT (9A)

MATERIAL - FREE CUTTING BROSS ROD
(REFER IS-319-)
1-PER ADAPTER

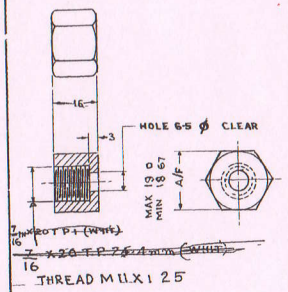

PIPE (9B)

MATERIAL - BRASS TUBE 60/40 TO IS 407
1-PER ADAPTER
SCALE - 1/1

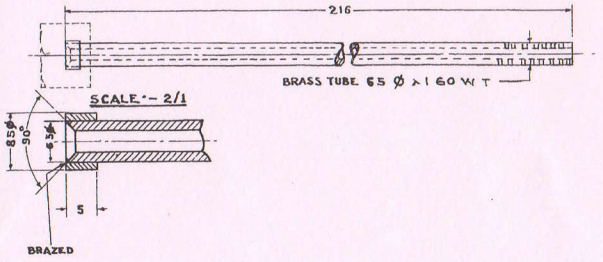

STORAGE No 56			
	CHIEF D/MAN 11/2/85	DGM	DATE / NAME
	PASSED BY I. C. Arora (12/4/85) GO/G-II	BRM	
		CHD	
		TRD	
		COMR	
	APPROVED DC (B)	SCALE - 1:1 & 1:2	

GO/G-II

C. Q. A (GS) KANPUR

HEATER SPACE OIL BURNING

~~K-6/4520-000083~~ STOVE TENT HEATING

DIMENSIONS IN MILLIMETRES

~~UNSEALED DRG NO GIGS/HH/103~~ (A) L-1

PLATE ATTACHED TO SPECN NO IND/GS/1691(A)