

RUSSIAN ORIGINAL ISSUE - NIL

~~Допускается изготовление из паронита ПМБ ГОСТ 481-80~~

① Заменитель материала паронит ПМБ ГОСТ 481-80

Резин

1. Alternate material: Rubberized asbestos Fabric ПМБ Т. GOST 481-80. [** RUBBERIZED ASBESTOS
2. IN TROPICAL DESIGN, TO BE MANUFACTURED FROM RUBBERIZED ASBESTOS FABRIC ПМБ Т. ГМБТ, GOST 481-80 AND LETTER 'T' IS TO BE MARKED WITH YELLOW PAINT.


(A) PILOT SAMPLE SHOULD BE APPROVED BY A H S P BEFORE BULK PRODUCTION

		EST. MASS 0.0009 Kg	TO BE STAMPED OR MARKED WHERE INDICATED THUS # (LETTERS)
		ALL SHARP EDGES AND CORNERS TO BE REMOVED UNLESS OTHERWISE STATED MACHINED CORNERS TO HAVE R OUTSIDE R INSIDE EQUIVALENT CHAMFERS ARE PERMISSIBLE	
A	26.10.89	Authy. No. BK 86-195.	
ISSUE	DATE	NATURE OF AMENDMENTS	MATERIAL:- **SEE ABOVE USED ON:- СБ 3301-00-37 СБ 3342-00-8
DHN	<i>Ornifol</i>	SCALE: 1 : 1	CONTROLLERATE OF QUALITY ASSURANCE (HEAVY VEHICLES) AVADI
CHD	<i>Ornifol</i>	DIMENSIONS IN mm	
TCD	<i>Ornifol</i>	TOLERANCE ON DIMNS UNLESS OTHERWISE STATED	TITLE :- GASKET
APPD	<i>Ornifol</i>		
DATE 7-4-88	ALL THREADS TO CONFORM TO		D S CAT NUMBER
			DRAWING NUMBER 301-97-1

COMMON TO V-9252 & UTB-20 ENGINES
 DRG. INDIANISED BASED ON RUSSIAN ORIGINAL ISSUE -NIL
 (B. JAYAVELU)
 JTO (D)

DRAWING NUMBER
351 - 02

Rz40 (✓)

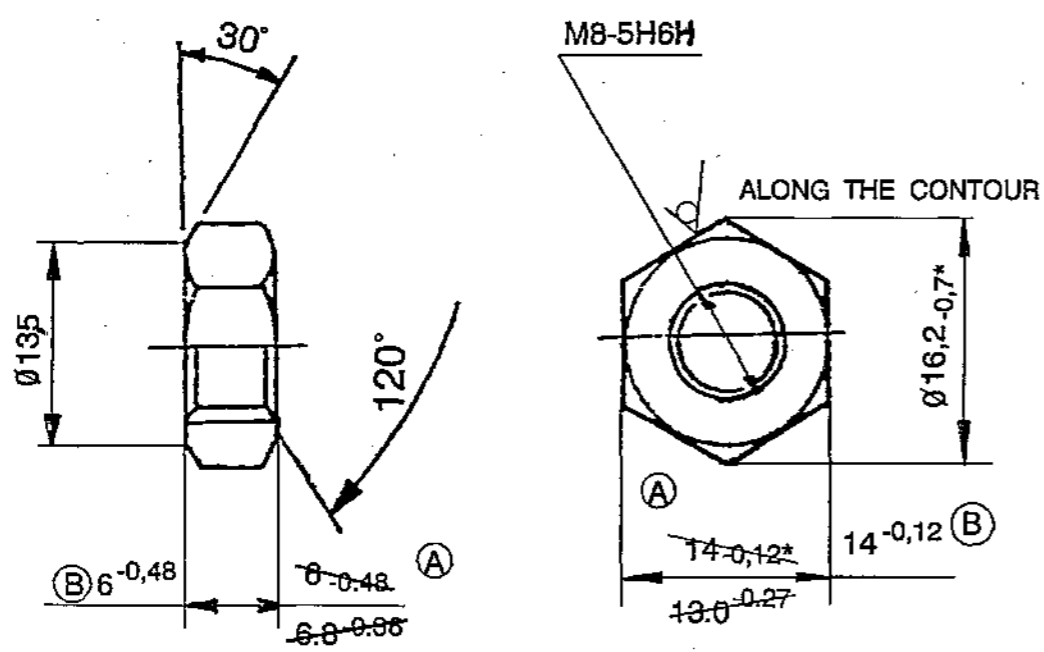

EXPLANATORY NOTE :

7. MATERIAL QUOTED :- HEXAGON BAR 14-4 GOST 8560-78
45-5 GOST 1051-73

BRIGHT STEEL OF HEXAGONAL CROSS SECTION 14mm ACROSS FLAT, ACCURACY CLASS - 4 TO GOST 8560-78. AND MANUFACTURED FROM COLD DRAWN SIZED STEEL OF GROUP 5 SURFACE QUALITY TO GOST 1051-73.
ALTERNATE MATERIAL QUOTED :- STEEL GRADE 40 & 50 TO GOST 1050-74.

CHEMICAL COMPOSITION :

STEEL GRADE	C O N T E N T O F E L E M E N T S %							
	C	Si	Mn	Cr(max)	S	P	Ni	Cu
40	0.37-0.45	0.17-0.37	0.50-0.80	0.25	0.040	0.035	0.10	0.15
45	0.42-0.50	0.17-0.37	0.50-0.80	0.25	0.040	0.035	0.10	0.15
50	0.47-0.55	0.17-0.37	0.50-0.80	0.25	0.040	0.035	0.10	0.15

MECHANICAL PROPERTIES :

STEEL GRADE	YIELD POINT Kgf/mm ² (min)	ULTIMATE TENSILE STRENGTH Kgf/mm ² (min)	PERCENTAGE ELONGATION (min)	REDUCTION OF AREA % (min)	IMPACT STRENGTH Kgf/m ² (min)
40	34	58	19	45	6
45	36	61	16	40	5
50	38	64	14	40	4

- ROLLED STOCK OF GROUP B CLASS 4 GOST 1051-73 MAY BE USED TO ENSURE HIGH QUALITY OF COATING, IT IS ALLOWED TO ELIMINATE SURFACE DEFECTS OF ROLLED STOCK WITH DECREASE OF DIMENSIONS AS PER ACCURACY CLASS 5.
- ~~ALTERNATE MATERIAL - STEEL GRADES 40 AND 50 GOST 1050-74~~
- THE REST OF THE TECHNICAL REQUIREMENTS AS PER STANDARD 82052 - 00.
- COATING :- Cd3, CHROMATIZING AS PER UUL-104 WITH ELIMINATION OF HYDROGEN EMBRITTEMENT.
- *DIMENSIONS FOR REFERENCE.

Material: STEEL 709M40 (EN-19) TO BS-970 Pt-I-1983

USED ON:-
 Eb 20-01-00-8, Cb 20-06-12-6, Cb 20-06-13-6, Cb 20-09-07,
 Cb 20-19-00-1, Cb 20-11-00-6, Cb 20-12-00-13, Cb 20-13-01-8,
 Cb 20-20-00-10, Cb 20-22-00-7, Cb 20-08-00-7, Cb 3301-00-37,
 Cb 306-01-20, Cb 306-02-20, Cb 306-03-3, Cb 306-04-2, Cb 321-04-4, Cb 447-01-1,
 Cb 421-04-3, Cb 421-18-1, Cb 3301-00-44, Cb 3301-15-44, Cb 306-01-36,
 Cb 306-02-36, Cb 3308-15-2, Cb 3312-90-14, Cb 419-00-20, Cb 3320-00-43,
 Cb 315-663-33, Cb 3334-02-10, Cb 3336-00-11, Cb 337-100, Cb 3342-00-21.

PILOT SAMPLE SHOULD BE APPROVED BY A H S P BEFORE BULK PRODUCTION.

EST. WT. 0,0055 Kg TO BE STAMPED OR MARKED WHERE INDICATED THUS # (LETTERS)

ALL SHARP EDGES AND CORNERS TO BE REMOVED UNLESS OTHERWISE STATED MACHINED CORNERS TO HAVE R OUTSIDE R INSIDE EQUIVALENT CHAMFERS ARE PERMISSIBLE.


ISSUE	DATE	NATURE OF AMENDMENTS
D	18.5.09	Authy: Third Alt. Comm. Minutes Point: 5 Dated 27-02-2009.
C	25.8.08	USED ON NUMBER ADDED
B	24-12-07	ALT. COMMITTEE MEETING MINUTES. POINT No. 2.18 Dt. 18-12-2007.
A	15-03-04	AUTHY. Lt. No.110094/IND-III /577, Dt. 19-02-04.

DRN Sd/= CHD Sd/= TCD Sd/= APPD Sd/= DATE 08-05-86 SCALE:- 2 : 1 DIMENSIONS IN mm TOLERANCE ON DIMNS UNLESS OTHERWISE STATED IS : 2102 - 69 MATERIAL :- 14-4 GOST 8560-78 45-5 GOST 1051-73 CONTROLLERATE OF QUALITY ASSURANCE (HEAVY VEHICLES) AVADI

TITLE:- NUT M8 D S CAT NUMBER DRAWING NUMBER 351 - 02

DRAWING NUMBER

351-50

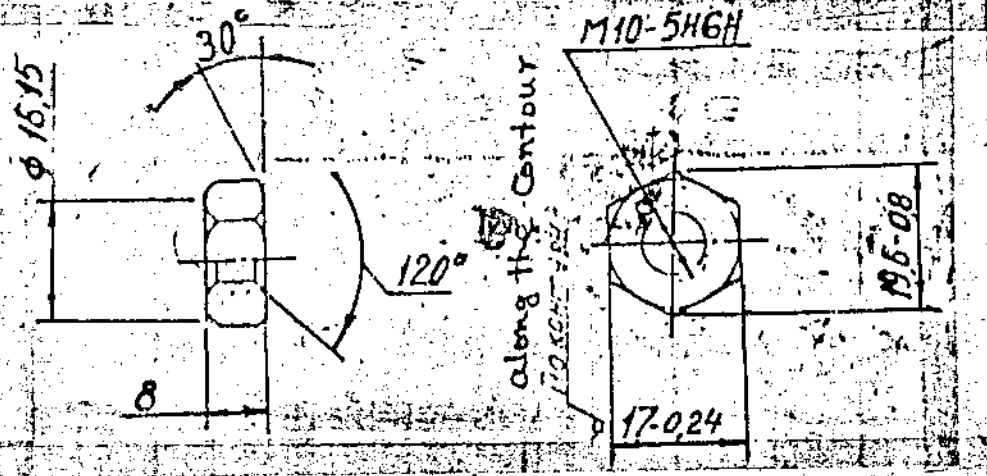

1. CHAMFER 120° SHOULD BE MADE UPTO THE MAJOR DIAMETER OF THREAD.
2. THE THREAD MAY BE CHECKED BEFORE COATING.
3. COATING : CADMIUM 9, CHROMATIZING AS PER 349-104 WITH ELIMINATION OF HYDROGEN EMBRITTLEMENT.
4. THE REST OF THE TECHNICAL REQUIREMENTS - AS PER STANDARD 82052-00.
5. ALTERNATE MATERIAL : STEEL, GRADES 40 AND 50 GOST 1050-74.
6. ROLLED STOCK OF GROUP 'B' CLASS 4 GOST 1051-73-MAY BE USED. TO ENSURE HIGH QUALITY OF COATING, IT IS ALLOWED TO ELIMINATE SURFACE DEFECTS OF ROLLED STOCK WITH DECREASE OF DIMENSION AS PER ACCURACY CLASS 5.

(B) Material: STEEL 709M40 (EN-19) TO BS-970 Pt-1-1983

EXPLANATORY NOTE:

HEXAGONAL BAR: 17-4GOST 8560-78 (B)
 45GOST 1051-73
 ALTERNATE MATERIAL QUOTED: 40 & 50, GOST. 1050-74
 BRIGHT, STEEL HEXAGONAL BAR 17mm ACROSS FLATS,
 CLASS OF ACCURACY-4, TO GOST 8560-78. GRADE 45, GOST. 1051-73
 B = WITH SURFACE QUALITY

Rz40/ (1)

(a) CHEMICAL COMPOSITION:

GRADE OF STEEL	CONTENTS OF ELEMENTS %							
	C	Si	Mn	Cr	P	S	Cu	Ni
	MAXIMUM							
40	0.37 - 0.45	0.17 - 0.37	0.50 - 0.80	0.25	0.035	0.040	0.25	0.25
45	0.42 - 0.50	0.17 - 0.37	0.50 - 0.80	0.25	0.035	0.040	0.25	0.25
50	0.47 - 0.55	0.17 - 0.37	0.50 - 0.80	0.25	0.035	0.040	0.25	0.25

(b) MECHANICAL PROPERTIES

GRADE OF STEEL	TENSILE STRENGTH Kgf/mm ² (min)	YIELD POINT Kgf/mm ² (min)	ELONGATION % (min)	REDUCTION IN AREA % (min)	IMPACT STRENGTH Kgf/cm ² (min)
40	58	34	19	45	6
45	61	36	16	40	5
50	64	38	14	40	4

(A) CB 3335-00-9, CB 3336-00-11, CB 3301-15-30, CB 3320-00-33, CB 3301-00-44, CB 3342-00-21, CB 3301-15-44, CB 3320-00-43, CB 329-75-1

MATERIAL: (B) 17-4 GOST 8560-78
 45-5 GOST 1051-73
 USED ON: CB 20-35-00-5
 CB 20-06-01-5, CB 306-04-2,
 CB 20-06-02-5, CB 20-06-04

PILOT SAMPLE SHOULD BE APPROVED BY A H S P BEFORE BULK PRODUCTION

EST. WT. 0.012 Kg TO BE STAMPED OR MARKED WHERE INDICATED THIS # LETTERS


ALL SHARP EDGES AND CORNERS TO BE REMOVED UNLESS OTHERWISE STATED MACHINED CORNERS TO HAVE R OUT-SIDE INSIDE EQUIVALENT CHAMFERS ARE PERMISSIBLE

DRM	CHD	TCD	APPO	DATE	SCALE	DIMENSIONS IN mm	TOLERANCE ON DIMS UNLESS OTHERWISE STATED IS: 2102-69	TITLE	D S CAT NUMBER	DRAWING NUMBER
				15-7-89	1:1			NUT M10		351-50
B	18.5.09	Authy: Third Alt. Comm. Minutes Point: 5 Dated 27-02-2009.				ALL THREADS TO CONFORM TO				
A	25.8.08	USED ON NUMBER ADDED								
ISSUE DATE		NATURE OF AMENDMENTS								

COMMON TO V-92S2 & UTD-20 ENGINES

A-11
42
SIZE A3

351-67

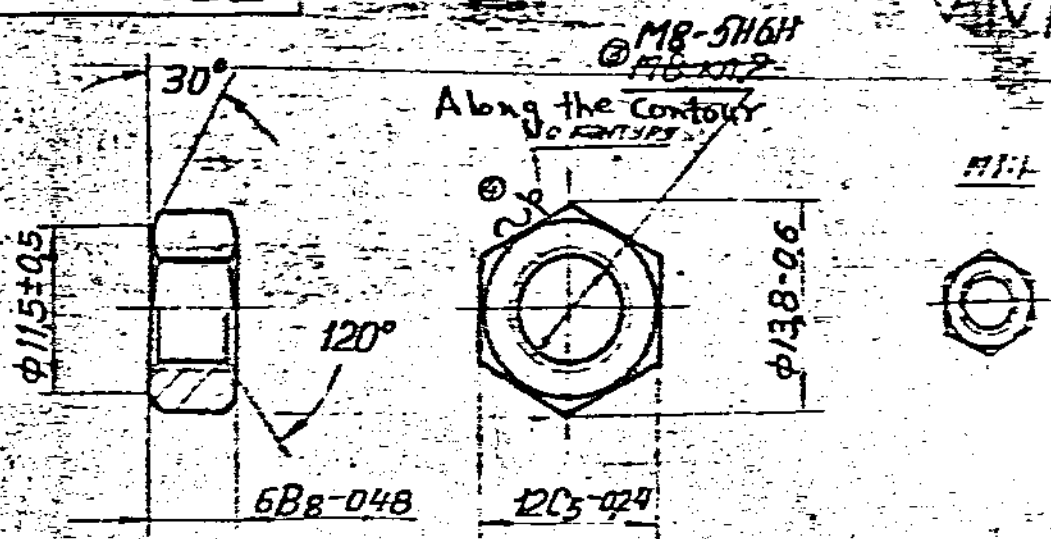

EXPLANATORY NOTE:

Material Quoted: Hexagon bar 12-5 GOST 8560-78
45 GOST 1051-73

Bright steel Hexagon bar from grade 45 to GOST 1050-74 with across flats 12 mm, of accuracy class 5.

Chemical composition

Carbon = 0.42-0.50 Chromium = 0.25 max.
 Silicon = 0.17-0.37 Sulphur = 0.040 max.
 Manganese = 0.50-0.80 Phosphorus = 0.035 max.
 Copper = 0.25 max. Nickel = 0.25 max.

Mechanical Properties:

yield point kgf/mm² = 36 (min)
 ultimate tensile strength = 61 (min)
 Elongation % = 16 (min)
 Reduction in area % = 40 (min)
 Impact strength kgf/cm² = 5 (min)

4. The thread may be checked before coating.
5. The rest of the technical requirements as per standard 82052-00.
6. Coating: - Cadmium & Chromating as per 434-104 with elimination of hydrogen embrittlement.

HEXAGON BAR 12-5 GOST 8560-78
45 GOST 1051-73

Ⓐ EQUIVALENT MATERIAL STEEL
 45C8 TO IS:1570

PILOT SAMPLE SHOULD BE APPROVED BY A H S P BEFORE BULK PRODUCTION

		EST. MASS	TO BE STAMPED OR MARKED WHERE INDICATED THIS #
		0.004 Kg	(LETTERS)
A	13.8.10	4 th All. Com. Meeting Minute Point No.11 Dt: 26-10-09	ALL SHARP EDGES AND CORNERS TO BE REMOVED UNLESS OTHERWISE STATED MACHINED CORNERS TO HAVE R OUTSIDE EQUIVALENT CHAMFERS ARE PERMISSIBLE.
ISSUE	DATE	NATURE OF AMENDMENTS	
DRN		SCALE: 2:1	MATERIAL: * SEE ABOVE
CHD		DIMENSIONS IN mm	USED ON: C53338-401-10
TCB		TOLERANCE ON DIMS UNLESS OTHERWISE STATED	CONTROLLERATE OF INSPECTION (HEAVY VEHICLES) AYAD
APPROV		ALL THREADS CONFORM TO	TITLE: NUT M8
DATE: 11/57			D/S CAT NUMBER: DRAWING NUMBER: 351-67



DRAWING NUMBER

353-21


Rz80 (V)

F

E

D

C

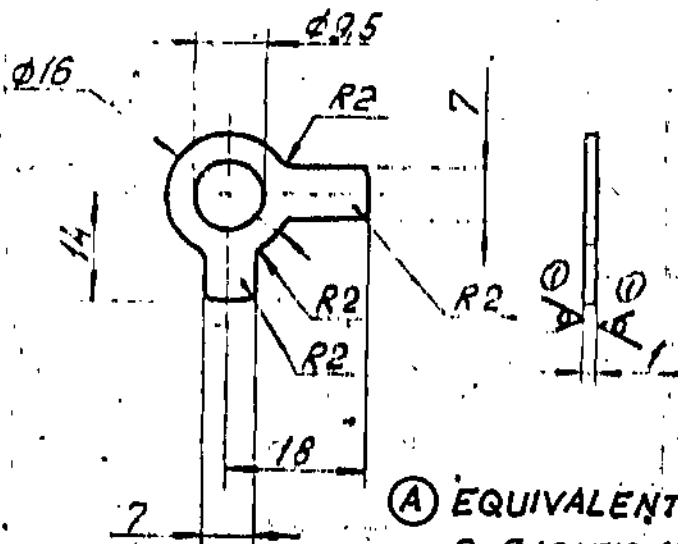

Ⓐ EQUIVALENT MATERIAL
Gr. OIS: 513-1994

2. Requirements for stamping as per standard 82050-16
3. The component should be straightened after stamping.
4. Burrs are not allowed.
6. Coating :- Cd 9, Chromating as per 1125A-104 with elimination of Hydrogen embrittlement.
7. Required finishing of surfaces being stamped should be ensured by tool.

A-11
69

PILOT SAMPLE SHOULD BE APPROVED BY A H S P BEFORE BULK PRODUCTION.


		EST. WT. 0.0016 kg	TO BE STAMPED OR MARKED WHERE INDICATED THUS # 1 LETTERS)
		ALL SHARP EDGES AND CORNERS TO BE REMOVED UNLESS OTHERWISE STATED MACHINED CORNERS TO HAVE R OUT-SIDE R INSIDE EQUIVALENT CHAMFERS ARE PERMISSIBLE.	
A	17-3-10	4 th Alt. Comm. Meet. Minutes Point No.1 Dt:26-10-09.	MATERIAL:- STRIP 08NC-M-2-1 GOST 508-71
ISSUE DATE		NATURE OF AMENDMENTS	USED ON CB 306-01-20, CB 20-06-01-5 CB 306-02-23 CB 20-06-02-5
DRN	lg.	SCALE:- 1:1 DIMENSIONS IN mm	CONTROLLERATE OF QUALITY ASSURANCE (HEAVY VEHICLES) AVADI.
CHD	gany.	TOLERANCE ON DIMENSIONS UNLESS OTHERWISE STATED IS 2102 -69	TITLE LOCK WASHER 9
TCD	Dwy	ALL THREADS CONFORM TO	
APPO	208		U S CAT NUMBER
DATE	15-2-89		DRAWING NUMBER 353-21

SIZE A4



DRAWING NUMBER

353-24

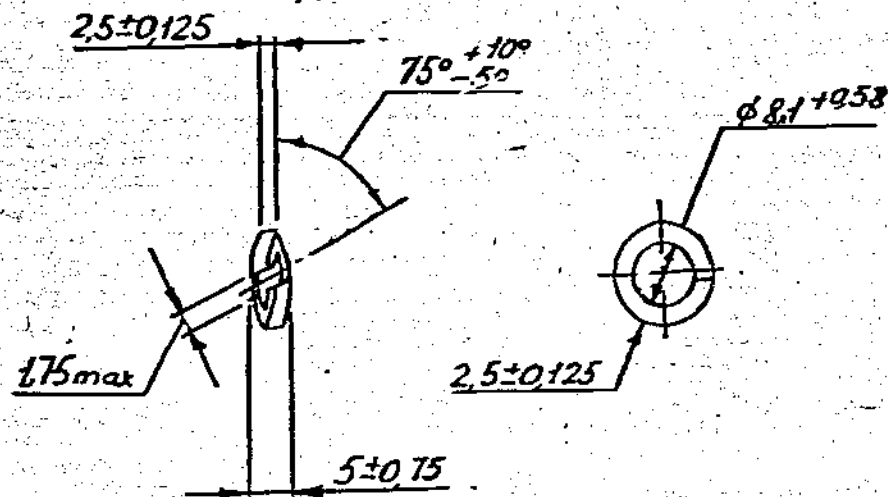

- 2. COATING ; CADMIUM 9, CHROMATIZING, AS PER UZ A-104 WITH ELIMINATION OF HYDROGEN EMBRITTLEMENT.
- 3. WASHER 8T 65Г 09 GOST 6402-70 MAY BE USED.

PILOT SAMPLE SHOULD BE APPROVED BY A H S P BEFORE BULK PRODUCTION.

COMMON TO V-92S2 & UTD-20 ENGINES

A-8

EXPLANATORY NOTE:

MATERIAL QUOTED: WASHER 8T, 65Г, 06 GOST 6402-70.
ALT. MAT. QUOTED: WASHER 8T, 65Г, 09 GOST 6402-70.
 CORRESPONDS DESIGN AND DIMENSIONS OF SPRING (LOCK) WASHERS.
 06 = CONVENTIONAL SYMBOL OF FINISH. (PARKERISING FOLLOWED BY OILING).
 09 = ZINC PLATING
 T = HEAVY ; 65Г = GRADE OF STEEL AS PER GOST 1050-74. (65G)

CHEMICAL COMPOSITION: AS PER GOST 1050-74.

CONTENT OF ELEMENTS %							
C	Si	Mn	Cr	S	P	Cu	Ni
MAXIMUM							
0.62-0.70	0.17-0.37	0.90-1.20	0.25	0.040	0.035	0.25	0.25

WEIGHT OF STEEL WASHERS AND THEIR RESILIENCE PROPERTIES AS PER GOST 6402-70.

- THEORETICAL WEIGHT OF 1000 STEEL WASHERS IN kg = 1.638
- ESTIMATED RESILIENCE OF WASHERS FROM STEEL GRADE 65G = 66.4 IN kg
- MECHANICAL PROPERTIES : AS PER GRADE 65G GOST 1050-74.
- YIELD POINT kgf/mm² (MIN) = 44
- ULTIMATE TENSILE STRENGTH (MIN) = 75 kgf/mm²
- ELONGATION % (MIN) = 9


(B) EQUIVALENT MATERIAL
 75 C6 TO IS:2507/EN42 J BS:970

		EST WT T-630 Kg 1000 PIECES	TO BE STAMPED OR MARKED WHERE INDICATED THUS # (LETTERS)
		ALL SHARP EDGES AND CORNERS TO BE REMOVED UNLESS OTHERWISE STATED MACHINED CORNERS TO HAVE R OUTSIDE R INSIDE EQUIVALENT CHAMFERS ARE PERMISSIBLE.	
B	16.8.10 4 th Alt. Comm. Meeting Minutes Point No:12 Dt: 26-10-09	MATERIAL 65Г06 GOST 6402-70	USED ON Cb 334-2-00-8 Cb 334-73-1, Cb 3334-02-3 Cb 3338-401-10
A	28-8-08 USED ON NUMBER ADDED		
ISSUE DATE	NATURE OF AMENDMENTS		
DRN	SCALE: 1:1	CONTROLLERATE OF INSPECTION (HEAVY VEHICLES) AVADI	
CHKD	DIMENSIONS IN mm	TITLE WASHER 8 T	
TCD	TOLERANCE ON DIMNS UNLESS OTHERWISE STATED		
APPD	ALL THREADS CONFORM TO	D S CAT NUMBER	DRAWING NUMBER
DATE			353-24

- Cb 303-00-16, Cb 406-12-44, Cb 345-00-4, Cb 447-00-1
 Cb 406-13-44, Cb 3301-00-37
 Cb 3301-15-30, Cb 3308-00-17
 Cb 3312-90-9, Cb 3320-00-33
 Cb 3321-00-16
 Cb 3301-00-44, Cb 3301-15-44
 Cb 406-12-75, Cb 406-13-75
 Cb 3308-15-2, Cb 3312-00-22
 Cb 3320-00-43, Cb 3321-00-26
 Cb 3334-00-47, Eb 3334-02-10
 Cb 3336-00-11, Cb 3342-00-21
- VARIOUS ASSEMBLIES OF UTD-20
 Cb 20-01-00-8, Cb 20-01-08-7
 Eb 20-06-12-6, Cb 20-06-13-6
 Eb 20-13-01-8, Cb 20-19-00-1
 Cb 20-20-00-10, Cb 20-22-00-7
 Cb 20-63-00-5



DRAWING NUMBER
353-26

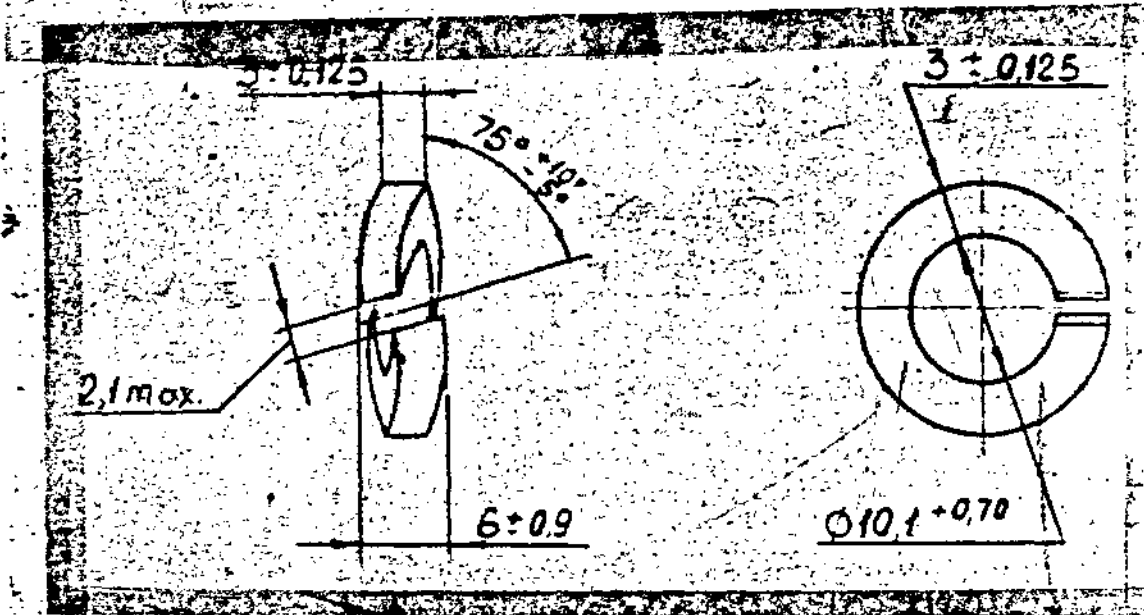

1. Washer 10 TO 65Г 06 GOST 6402-70
may be used.

EXPLANATORY NOTE:

Material Quoted: 65Г 06 GOST 6402-70

Alternate material quoted: washer 10 TO 65Г 06 GOST 6402-70

65Г : Spring (lock) washers (Heavy washer) manufactured from
Steel grade of 65Г to GOST 1050-74.

06 : Parkerising followed by oiling

washer 10: oxy-anodizing followed by chromate passivation.

Chemical Composition: as per GOST 1050-74

C	Si	Mn.	Cr	S	P	Cu	Ni
			MAXIMUM				
0.62-0.70	0.17-0.37	0.70-1.00	0.25	0.040	0.035	0.25	0.25

(i) General Properties: as per GOST 6402-70.

1. Theoretical weight of 1000 washers in kg \approx 2.914

2. Estimated resilience of washers from steel of
grade 65 G in kg \approx } = 87.0

(ii) Mechanical Properties: for 65Г, as per GOST 1050-74

1. yield point kgf/mm^2 (min) = 44

2. ultimate tensile strength kgf/mm^2 (min) = 75

3. Elongation % (min) = 9

4. Hardness BHN (max) = 229

PLOT SAMPLE SHOULD BE APPROVED BY A H S P BEFORE
BULK PRODUCTION

EST. WT. 1000 PIECES 2.914 kg
TO BE STAMPED OR MARKED WHERE INDICATED THUS # 1 LETTERS)

ALL SHARP EDGES AND CORNERS TO BE REMOVED UNLESS OTHERWISE STATED. MACHINED CORNERS TO HAVE R OUT SIDE
INSIDE EQUIVALENT CHAMFERS ARE PERMISSIBLE.

DRN	<i>Subraha</i>	MATERIAL:-	USED ON C53338-00-16
CHD	<i>see P/number</i>	65Г.06 GOST 6402-70	CE 20-09-01-6
TCD	<i>Devendra</i>		
APPD	<i>S.E.</i>	CONTROLLERATE OF QUALITY ASSURANCE (HEAVY VEHICLES)	
DATE	20-4-89	AVADI	
SCALE:-	2:1	TITLE	
DIMENSIONS IN mm		WASHER 10T	
TOLERANCE ON DIMNS UNLESS OTHERWISE STATED IS: 2102-69		D S CAT NUMBER	
ALL THREADS TO CONFORM TO		DRAWING NUMBER	
ISSUE DATE		353-26	
NATURE OF AMENDMENTS			


KVD No. 78687
(V-46)

KVD No. 63634
(UTD)

SIZE A3

KVD.No. 78696

DRAWING NUMBER
353-93-1

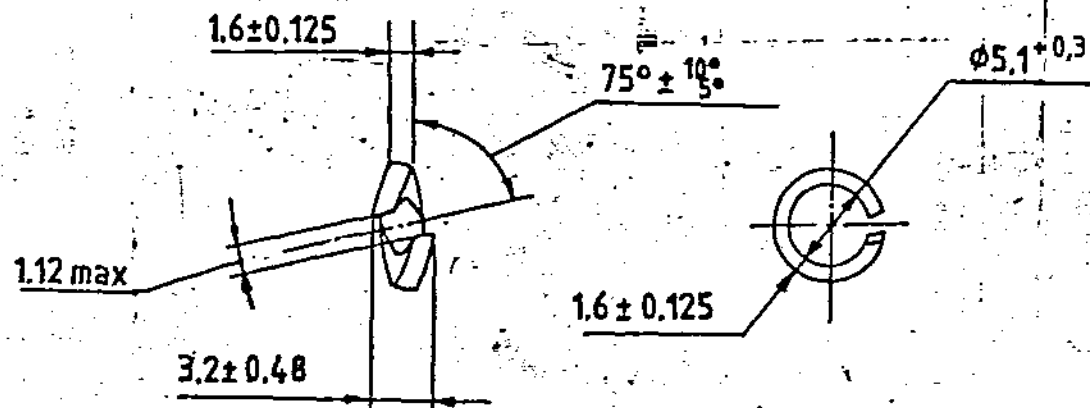

1. IN TROPICAL MANUFACTURE, COATING Cd 9 Cr AS PER UCL-104 WITH REMOVAL OF HYDROGEN EMBRITTLEMENT.
2. WASHER ST65Γ09 GOST 6402-70 MAY BE USED, IN VISUAL AND TROPICAL MANUFACTURE.

PILOT SAMPLE SHOULD BE APPROVED BY A H S P BEFORE BULK PRODUCTION.

		EST. WT. ¹⁰⁰⁰ / _{Pcs} 0.424 Kg	TO BE STAMPED OR MARKED WHERE INDICATED THUS (LETTERS)
ALL SHARP EDGES AND CORNERS TO BE REMOVED UNLESS OTHERWISE STATED MACHINED CORNERS TO HAVE R OUTSIDE R INSIDE EQUIVALENT CHAMFERS ARE PERMISSIBLE.			
A	16.8.10	1 st Alt. Comm. Meeting Minutes Point No.12 Dt: 26-10-09	MATERIAL:- ST 65 Γ 06 GOST 6402-70
ISSUE DATE		NATURE OF AMENDMENTS	USED ON Cb 311-10-4 Cb 311-10-4
DRN	<i>Ughle</i>	SCALE:- 2 : 1 DIMENSIONS IN mm	CONTROLLERATE OF QUALITY ASSURANCE (HEAVY VEHICLES) AVADI.
CHOC	<i>S. S. S.</i>	TOLERANCE ON DIMENSIONS UNLESS OTHERWISE STATED IS 2102 -69	TITLE WASHER
APPO	<i>S. S. S.</i>	ALL THREADS CONFORM TO	D S CAT NUMBER
DATE	<i>28.5.01</i>		DRAWING NUMBER 353-93-1
SIZE A4			

EXPLANATORY NOTE:

MATERIAL QUOTED: WASHER 5T, 65Γ, 06 GOST 6402-70.

CORRESPONDS DESIGN AND DIMENSIONS OF SPRING (LOCK) WASHERS.

06 = CONVENTIONAL SYMBOL OF FINISH. (PARKERISING FOLLOWED

5 = NOMINAL THREAD DIA OF BOLT OR SCREW BY OILING).

T = HEAVY ; 65Γ = GRADE OF STEEL AS PER GOST 1050-74.
(65G)

CHEMICAL COMPOSITION: AS PER GOST 1050-74.

CONTENT OF ELEMENTS %							
C	Si	Mn	Cr	S	P	Cu	Ni
MAXIMUM							
0.62-0.70	0.17-0.37	0.90-1.20	0.25	0.040	0.035	0.25	0.25

WEIGHT OF STEEL WASHERS AND THEIR RESILIENCE PROPERTIES AS PER GOST 6402-70.

THEORITICAL WEIGHT OF 1000 STEEL WASHERS IN kg = 0.424.

ESTIMATED RESILIENCE OF WASHERS FROM STEEL GRADE 65G = 28.7.
IN kg

MECHANICAL PROPERTIES: AS PER GRADE 65G GOST 1050-74.

YIELD POINT kgf/mm² (MIN) = 44

ULTIMATE TENSILE STRENGTH (MIN) = 75
kgf/mm².

ELONGATION % (MIN) = 9

REFERENCE NOTE: 09 = ZINC PLATING (CONVENTIONAL SYMBOLOF FINISH)


Ⓐ EQUIVALENT MATERIAL
75 C6 TO IS: 2507/EN 42 J BS: 970



DRAWING INDIANISED BASED ON RUSSIAN ORIGINAL ISSUE - 7



DRAWING NUMBER
356-22-2

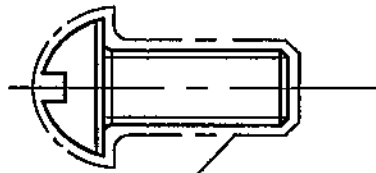

Coating : Zinc-6 microns, chromium-1micron as per
ИЛ-749-88 by removing hydrogen embrittlement.

1. In tropical construction, plating cadmium-9microns, chromium-1 micron as per ИЛ-569-84 with removal of hydrogen embrittlement.
2. Blank should match with requirement Gost 1759.0-87 for class of accuracy B.

PILOT SAMPLE SHOULD BE APPROVED BY A H S P BEFORE BULK PRODUCTION.

		EST. WT. (Kg) 0.003		TO BE STAMPED OR MARKED WHERE INDICATED THUS # (LETTERS)	
		ALL SHARP EDGES AND CORNERS TO BE REMOVED UNLESS OTHERWISE STATED MACHINED CORNERS TO HAVE R OUT-SIDE R INSIDE EQUIVALENT CHAMFERS ARE PERMISSIBLE.			
		MATERIAL :- <i>Blank</i> Screw M5-6gx12.58 GOST 17473-80		USED ON :- CB 322-14-9 CB 322-15-9 CB 323-00-10 CB 3320-00-43	
ISSUE	DATE	NATURE OF AMENDMENTS			
DRN	<i>[Signature]</i>	SCALE :- 2:1		CONTROLLERATE OF QUALITY ASSURANCE (HEAVY VEHICLES) AVADI	
		DIMENSIONS IN mm			
CHD	<i>[Signature]</i>	TOLERANCE ON DIMENSIONS UNLESS OTHERWISE STATED IS : 2102 - 69		TITLE :- SCREW M5x12	
APPD	<i>[Signature]</i>	ALL THREADS TO CONFORM TO			
DATE	<i>25/11/07</i>	D S CAT NUMBER		DRAWING NUMBER 356-22-2	


SIZE A4

As per the item list SB 3342-00-8, the drawing 356-138 can be used in place of 356-138-1

	DRAWING NUMBER 356 138	Rz40
D		
C		
B	<ol style="list-style-type: none"> 1. Inspection group <u>IV</u> - TT - U 2. HRC, 35-39 3. The thread may be made by rolling with the diameter of unthreaded portion within the pitch diameter of thread. 4. The rest of the technical requirements - as per standard 82052-00. 5. Coating: Cu 6 - as per 92421-124 6* Dimensions for reference. 	
A		
A-11	PILOT SAMPLE SHOULD BE APPROVED BY A H S P BEFORE BULK PRODUCTION	

			EST. WT 0.014 Kg	TO BE STAMPED OR MARKED WHERE INDICATED THUS # (LETTERS)
			ALL SHARP EDGES AND CORNERS TO BE REMOVED UNLESS OTHERWISE STATED MACHINED CORNERS TO HAVE R OUTSIDE R INSIDE EQUIVALENT CHAMFERS ARE PERMISSIBLE	
(A)	25/118 P.S.C.D.	TITLE WAS M8x25, AUTHY. dt LETTER 81152/CIHV/DB IV 5/1/87	MATERIAL: HEXAGON BAR 14-5 GOST 8560-78	USED ON: CB 3342 00 8 CB
ISSUE	AMDT	NATURE OF AMENDMENTS	38xA GOST 1051-73	
DRN		SCALE: 1 : 1	CONTROLLERATE OF INSPECTION (HEAVY VEHICLES) AVADI	
CHD		DIMENSIONS IN mm		
TCD		TOLERANCE ON DIMNS UNLESS OTHERWISE STATED		TITLE: BOLT M8 x 20 (A)
APPD		ALL THREADS TO CONFORM TO	D S CAT NUMBER	DRAWING NUMBER 356 138
DATE	20/1/86			

As per the item list SB 3342-00-8, the drawing 356-138 can be used in place of 356-138-1

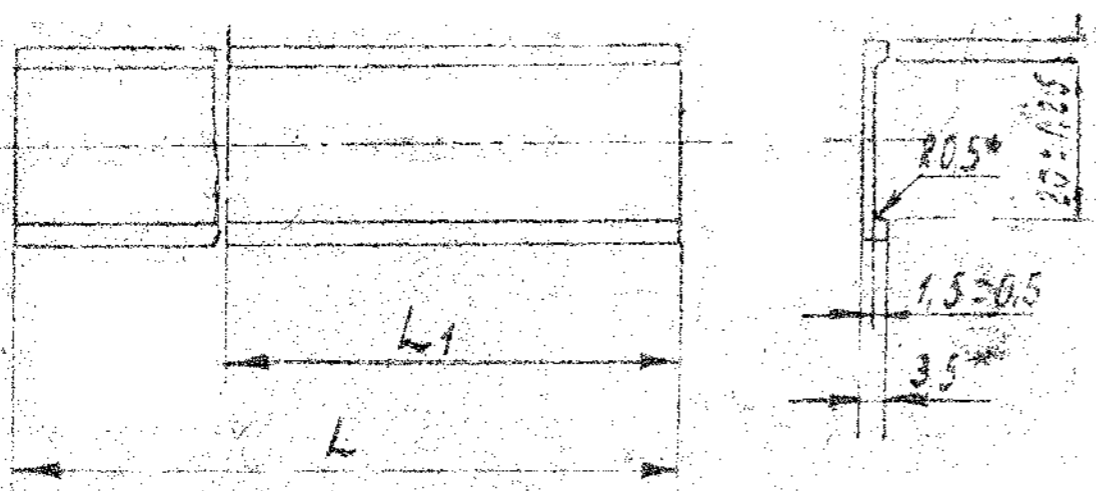

EXPLANATORY NOTE:

6. REFERENCE MATERIAL QUOTED :
UNVULCANISED OIL AND PETROL RESISTANT RUBBER CODE OF CLASSIFIER
IS - 1231, RUBBER GRADE HO- 68-1 TO TY DMS-216-75.

7. MECHANICAL PARAMETERS :
- i) RUPTURE STRENGTH Kgf/cm² - - - - - 90 Min.
 - ii) ELONGATION OF RUPTURE % - - - - - 250 Min.
 - iii) RESIDUAL ELONGATION AFTER RUPTURE % - - - - - 12 Max.
 - iv) HARDNESS No DP TO TM P DEVIE ARBITORY - - - - - 55 - 70
7. LIKELY EQUIVALENT GRADE / SPECIFICATION FOR NITRILE CHLOROPRENE
BASE TO BA 60 BS 2751-82 AND C 60 BS 2752-82.

KVD-No	PART NO	L ₁ - mm	MASS Kg	USED ON
78558	420-149-1	37±2	0.0026	CB 3335 00 24 30
78234	420-149-2	42±2	0.0029	CB 3335 00 24 30 CB 3342-00-8 CB
78235	420-149-3	60±2	0.0042	
②	420-149-4	104±2		
78236	420-149-5	135±2	0.01	CB 3342-00-8 CB


1. *DIMENSIONS SHOULD BE ENSURED WITH TOOL.
2. LENGTH OF STRIP L₁ BEING SUPPLIED SHOULD NOT BE LESS THAN 1000 mm.
3. TO BE MANUFACTURED AS PER -T III H:100 GOST 15152-59
4. CO 420-149-1 SHOULD BE MARKED ON LABEL OF GASKETS BEING DELIVERED.
5. THE REST OF THE REQUIREMENTS AS PER SPECIFICATIONS 005216-75.

PILOT SAMPLE SHOULD BE APPROVED BY A M S P BEFORE BULK PRODUCTION.


EST MASS TO BE STAMPED OR MARKED WHERE INDICATED THUS # LETTERS)
ALL SHARP EDGES AND CORNERS TO BE REMOVED UNLESS OTHERWISE STATED MACHINED CORNERS TO HAVE R OUT-SIDE R INSIDE EQUIVALENT CHAMFERS ARE PERMISSIBLE

DRW	CHK	TCD	APPL	DATE	SCALE	DIMENSIONS IN mm	TOLERANCE ON DIMNS UNLESS OTHERWISE STATED.	ALL THREADS CONFORM TO	ISSUE	DATE	NATURE OF AMENDMENTS
					1:1						
MATERIAL - RUBBER HO-68-1 SPECIFICATIONS 005216-75								USED ON - SEE ABOVE			
CONTROLLERATE OF INSPECTION (HEAVY VEHICLES) AVADI								TITLE - GASKET			
D'S CAT NUMBER								DRAWING NUMBER 420-149-1 TO 5			

700-41-3442


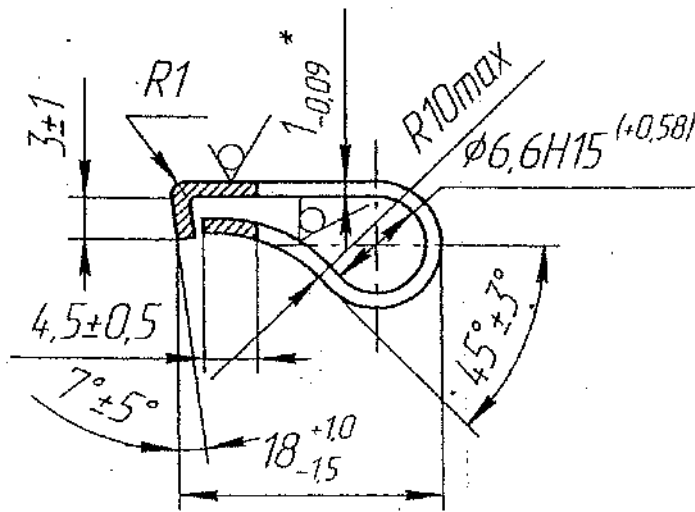


variant
Вариант

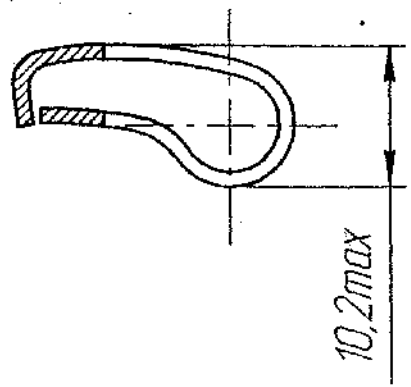

A

A-A

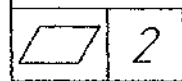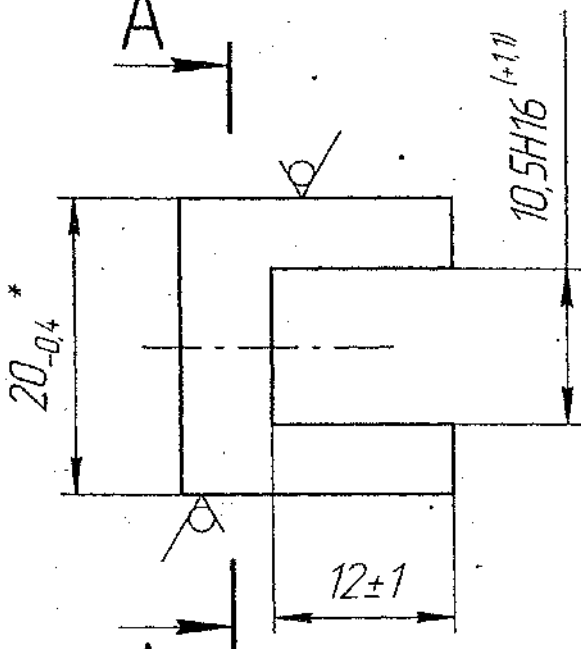

62
76

ТРІПЛІКАТЕ
T-905.

1. Remarks: steel grade 08nc, 10nc GOST 1058-88 is Allowed

1. Допускается применение сталей марок 08nc, 10nc ГОСТ 1050-88.
2. Трещины и вмятины не допускаются.

3. *Размеры для справок.
2. Cracks and dents are not Allowed
3. * Dimensions for reference

Обозначение (A)	Покрытие (B)
700-41-3442	Zn-Zn9 с/тн
-01	© Ц9.хр.т.


FRAME 700-41-3442 88/8
Рамка

2	-	95-791		
Изм.	Лист	№ докум	Подп.	Дата
Разраб.				
Проб.				
Т.контр.				
Н.контр.				
Чтв				

РАМКА	Лист	Масса	Масштаб
	A	0,004	2:1
BAND Лента 10 М-3-1×20 ГОСТ 503-81	Лист	Листов	1
		F	6/58

DRAWING NUMBER

3320-140

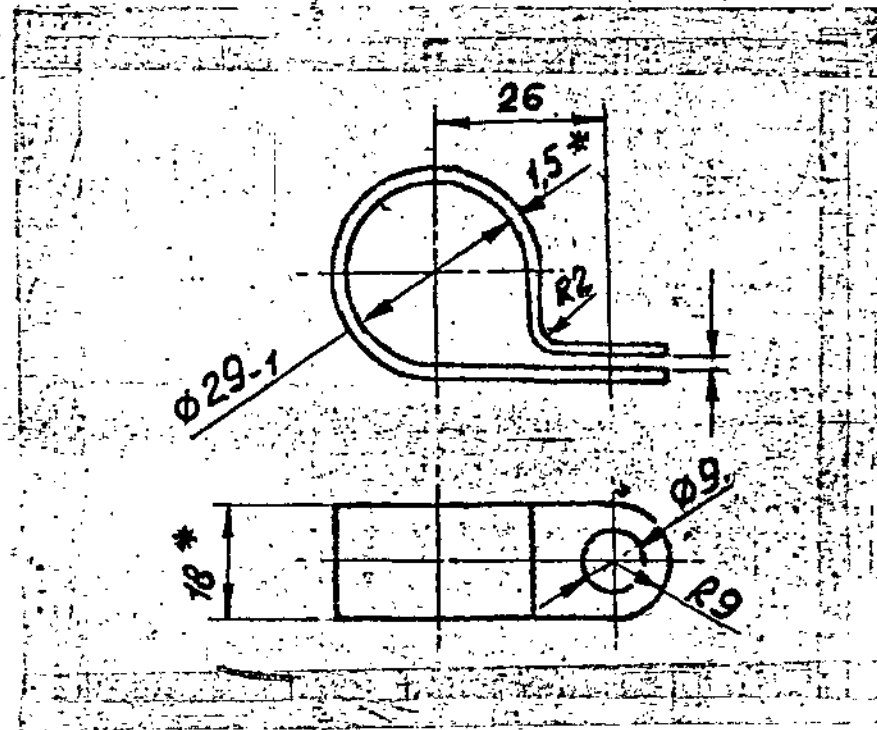

1. REQUIREMENTS PLACED UPON STAMPING ARE AS PER STANDARD 82050-16.
2. ALTERNATE MATERIAL IS 08KN GOST 1050-74.
3. TOTAL LENGTH IS APPROXIMATELY = 138.
4. *DIMENSIONS ARE GIVEN FOR REFERENCE.
5. COATING: ZINC-PLATED, 15 MICRONS THICK, OILED, WITH REMOVAL OF HYDROGEN EMBRITTLEMENT.
6. PERMISSIBLE COATING: VARNISH ГФ-95, GOST 8018-70.

Ⓐ EQUIVALENT MATERIAL
Gr.DD IS: 513-1994.

PILOT SAMPLE SHOULD BE APPROVED BY A H S P BEFORE BULK PRODUCTION

EST. WT. TO BE STAMPED OR MARKED WHERE INDICATED THIS # (LETTERS)
0.0235 kg.

ALL SHARP EDGES AND CORNERS TO BE REMOVED UNLESS OTHERWISE STATED MACHINED CORNERS TO HAVE R OUT SIDE INSIDE EQUIVALENT CHAMFERS ARE PERMISSIBLE.

EXPLANATORY NOTE:-MATERIAL QUOTED:

STRIP 08ΠC-M-2-1.5x18 GOST 503-71.

08ΠC= COLD ROLLED LOW CARBON STEEL STRIP

M = CONDITION OF MATERIAL- SOFT

2 = GROUP OF SURFACE QUALITY (ROUGHNESS PARAMETERS $R_a \leq 1.25$ MICRON)

1.5 = THICKNESS. 18 = WIDTH OF STRIP.

CHEMICAL COMPOSITION (AS PER GOST 1050-74)

CARBON = 0.05 - 0.11 ; SILICON = 0.05 - 0.17 ;

MANGANESE = 0.35 - 0.65

CHROMIUM 0.1

SULPHUR 0.040

PHOSPHORUS 0.035 MAXIMUM

COPPER 0.25


NICKEL 0.25

MECHANICAL PROPERTIES :-ULTIMATE TENSILE STRENGTH $Kgf/mm^2 = 32-45$

RELATIVE ELONGATION % = 17 (MIN)

KVD NO. 63357

EXPLANATORY NOTE ADDED ON 16-4-91.

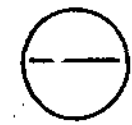

SIZE A3

			DRN		MATERIAL: STRIP 08ΠC-M-2-1.5x18 GOST 503-71.	USED ON CB20-20-00-10 CB 3342-00-8
			CHK	<i>Pathan</i>		
			TCD	<i>Pathan</i>		
			APPO	<i>Pathan</i>		
			DATE	19-8-87	CONTROLLERATE OF QUALITY ASSURANCE (HEAVY VEHICLES)	
			SCALE:-	1:1	AVADI	
			DIMENSIONS IN mm		TITLE SUSPENSION CLAMP	D S. CAT NUMBER
			TOLERANCE ON DIMNS UNLESS OTHERWISE STATED IS: 2102-69			
			ALL THREADS TO CONFORM TO		DRAWING NUMBER 3320-140	
	A	18.03.10	4 th Alt. Comm. Mt. Minutes Pt. No. 1 Dt. 26.10.09		ISSUE DATE NATURE OF AMENDMENTS	





DRAWING NUMBER

3320 - 386

ECKA

Rz 320

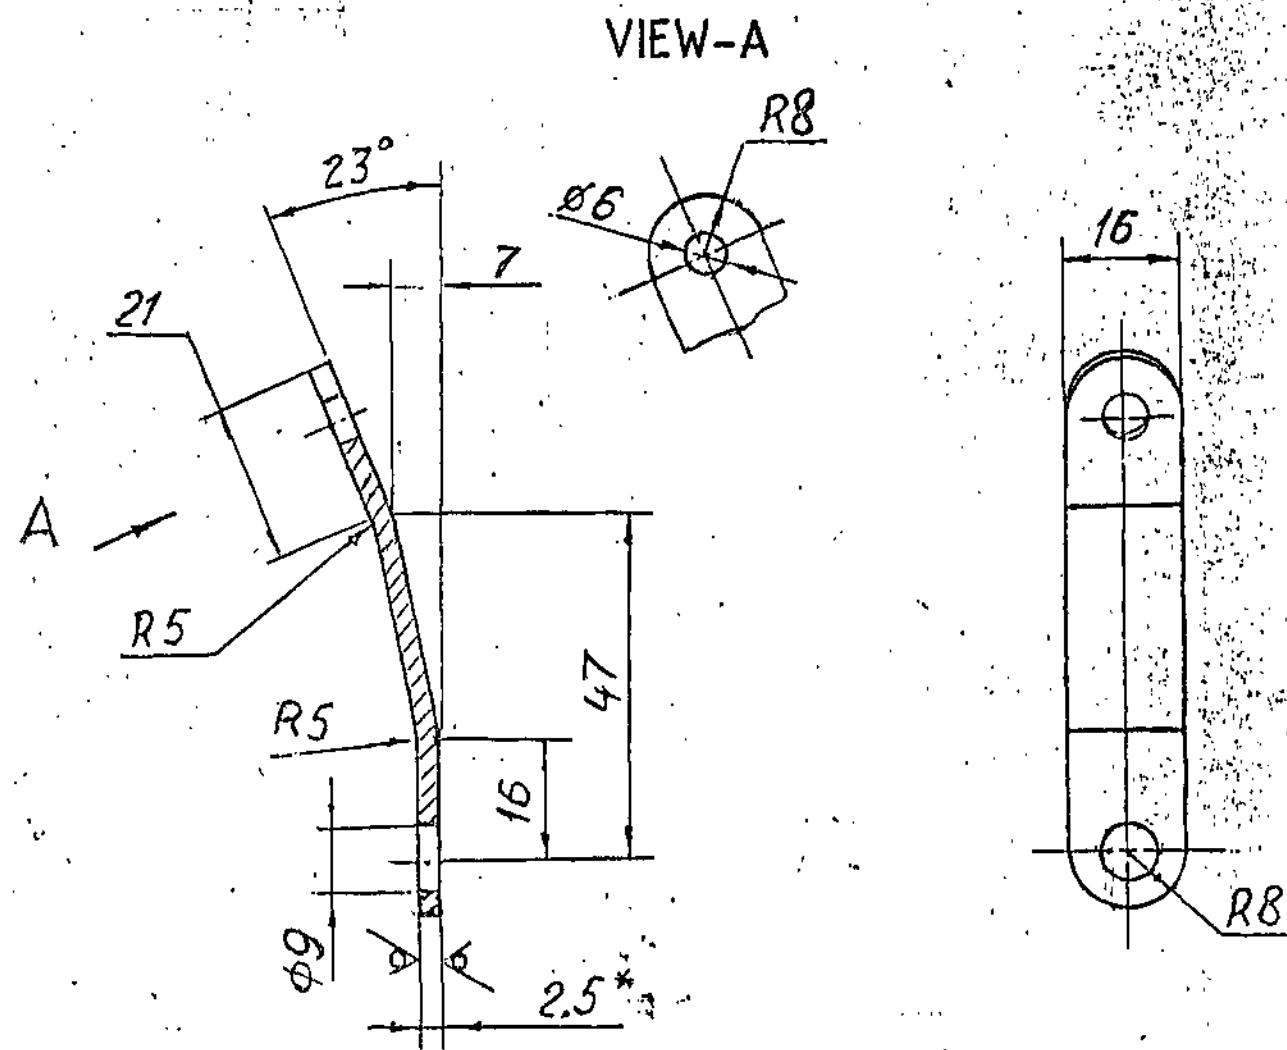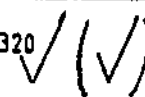

1. LENGTH OF STRAIGHTENED COMPONENT L = 77mm.
2. TOLERANCE UNLESS OTHERWISE STATED ± 0,5mm.
3. *DIMENSION FOR REFERENCE.

Ⓐ EQUIVALENT MATERIAL
Gr. D IS: 513-1994.

PILOT SAMPLE SHOULD BE APPROVED BY A H S P BEFORE BULK PRODUCTION

EST WT 0,022 Kg TO BE STAMPED OR MARKED WHERE INDICATED THUS # (LETTERS)

ALL SHARP EDGES AND CORNERS TO BE REMOVED UNLESS OTHERWISE STATED MACHINED CORNERS TO HAVE R OUT-SIDE R INSIDE EQUIVALENT CHAMFERS ARE PERMISSIBLE


DRN		MATERIAL :-	USED ON :-
CHO		SHEET A 2,5 GOST 19904-74	Cb 3320-385
TCD		IV 10 GOST 16523-70.	
APPO		CONTROLLERATE OF INSPECTION (HEAVY VEHICLES)	
DATE	31-08-87	AVADI	
SCALE :-	1 : 1	TITLE	
DIMENSIONS IN MM		PLATE	
TOLERANCE ON DIMNS UNLESS OTHERWISE STATED IS: 2102-69		D S CAT NUMBER	
ALL THREADS TO CONFORM TO		DRAWING NUMBER	
- A	1-7-10	3320 - 386	
ISSUE	DATE	NATURE OF AMENOMENTS	

A-7
81


SIZE A3



DRAWING NUMBER
3335 77 3

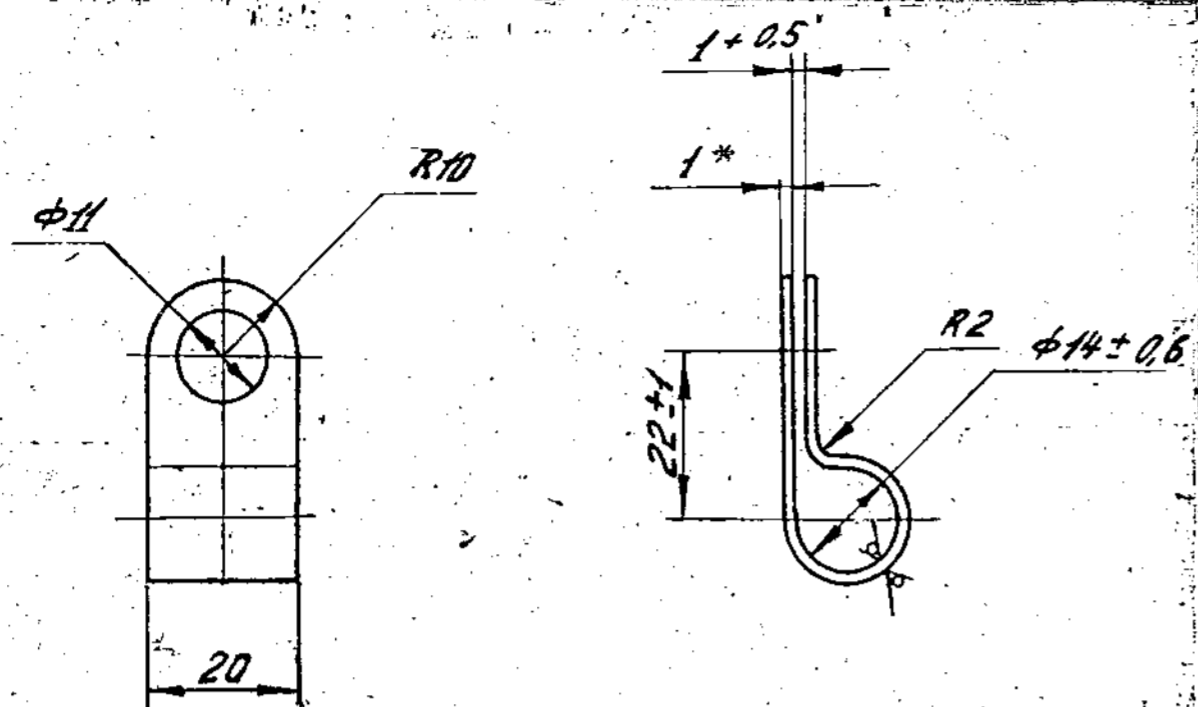

ALTERNATIVE
Вариант

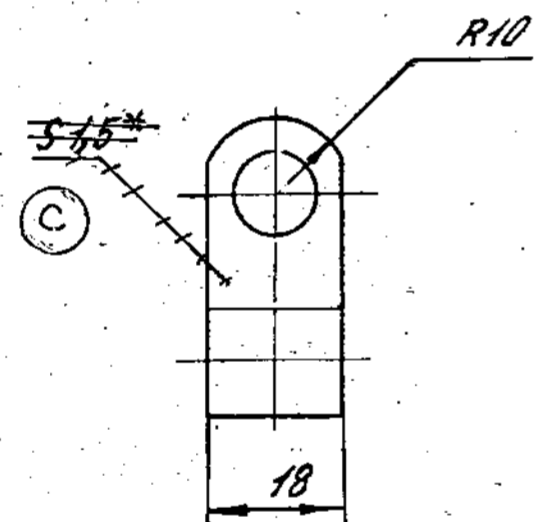

1. MAY BE MANUFACTURED FROM BAND 08nc-M-2-1.5, GOST 503-71, AS PER ALTERNATIVE
2. UNSPECIFIED LIMIT DEVIATIONS OF DIMENSIONS ± 0.5 mm.
3. LENGTH OF STRAIGHTENED CLAMP $L = 94$ mm.
4. COATING: Cd 9, CHROMATIZING AS ER INSTRUCTIONS ЦУЛ-104 WITH ELIMINATION OF HYDROGEN EMBRITTLEMENT.
5. * DIMENSIONS FOR REFERENCE.
6. IN TROPICAL DESIGN COATING Cd.9, CHROMATIZING AS PER ЦУЛ-569-84 REMOVING HYDROGEN EMBRITTLEMENT.

PILOT SAMPLE SHOULD BE APPROVED BY A H S P BEFORE BULK PRODUCTION.

EST. MASS 0.012 Kg TO BE STAMPED OR MARKED WHERE INDICATED THUS # (LETTERS)

ALL SHARP EDGES AND CORNERS TO BE REMOVED UNLESS OTHERWISE STATED MACHINED CORNERS TO HAVE R OUTSIDE R INSIDE EQUIVALENT CHAMFERS ARE PERMISSIBLE.

EXPLANATORY NOTE:

6. REFERENCE MATERIAL QUOTED:

COLD ROLLED CARBON STEEL STRIP MATERIAL CONDITION SOFT 'M', SURFACE QUALITY GROUP '2' WITH TRIMMED EDGES. NORMAL MANUFACTURING ACCURACY, 1.0(-0.09)mm THICK TO GOST 503-81 AND MANUFACTURED IN ACCORDANCE WITH QUALITY CARBON STRUCTURAL SEMI KILLED STEEL STRIP GRADE 08nc TO GOST 1050-74.

a) CHEMICAL COMPOSITION AS PER GOST 1050-74:

GRADE OF STEEL	CONTENT OF ELEMENTS %					
	C	Si	Mn	Cr	S	P
08nc	0.05 - 0.11	0.05 - 0.17	0.35 - 0.65	0.10	0.040	0.035

RESIDUAL CONTENT OF COPPER AND NICKEL SHOULD NOT EXCEED 0.25% EACH.

b) MECHANICAL PROPERTIES AS PER GOST 503-81:

CONDITION OF MATERIAL	GRADE OF STEEL	ULTIMATE TENSILE STRENGTH Kgf/mm ²	ELONGATION % min
M	08nc	32 - 45	17

Ⓓ EQUIVALENT MATERIAL
GOST 15:513-1994

DRN	CHD	TCD	APPD	DATE	SCALE - 1:1	TOLERANCE ON DIMNS UNLESS OTHERWISE STATED.	ALL THREADS CONFORM TO	D S CAT NUMBER	DRAWING NUMBER
				02/20					3335 77 3
MATERIAL:- STRIP 08nc-M-2-1 GOST 503-71 81					USED ON:- C 33342-00-805 C 5 3335 00 2430 C 5 3342-				
CONTROLLERATE OF INSPECTION (HEAVY VEHICLES) AVADI					TITLE:- CLAMP				
EST. MASS 0.012 Kg					PILOT SAMPLE SHOULD BE APPROVED BY A H S P BEFORE BULK PRODUCTION.				
TO BE STAMPED OR MARKED WHERE INDICATED THUS # (LETTERS)					ALL SHARP EDGES AND CORNERS TO BE REMOVED UNLESS OTHERWISE STATED MACHINED CORNERS TO HAVE R OUTSIDE R INSIDE EQUIVALENT CHAMFERS ARE PERMISSIBLE.				































DRAWING NUMBER
3342-27-2

SHEET No. 1 OF 1

80/ (✓)

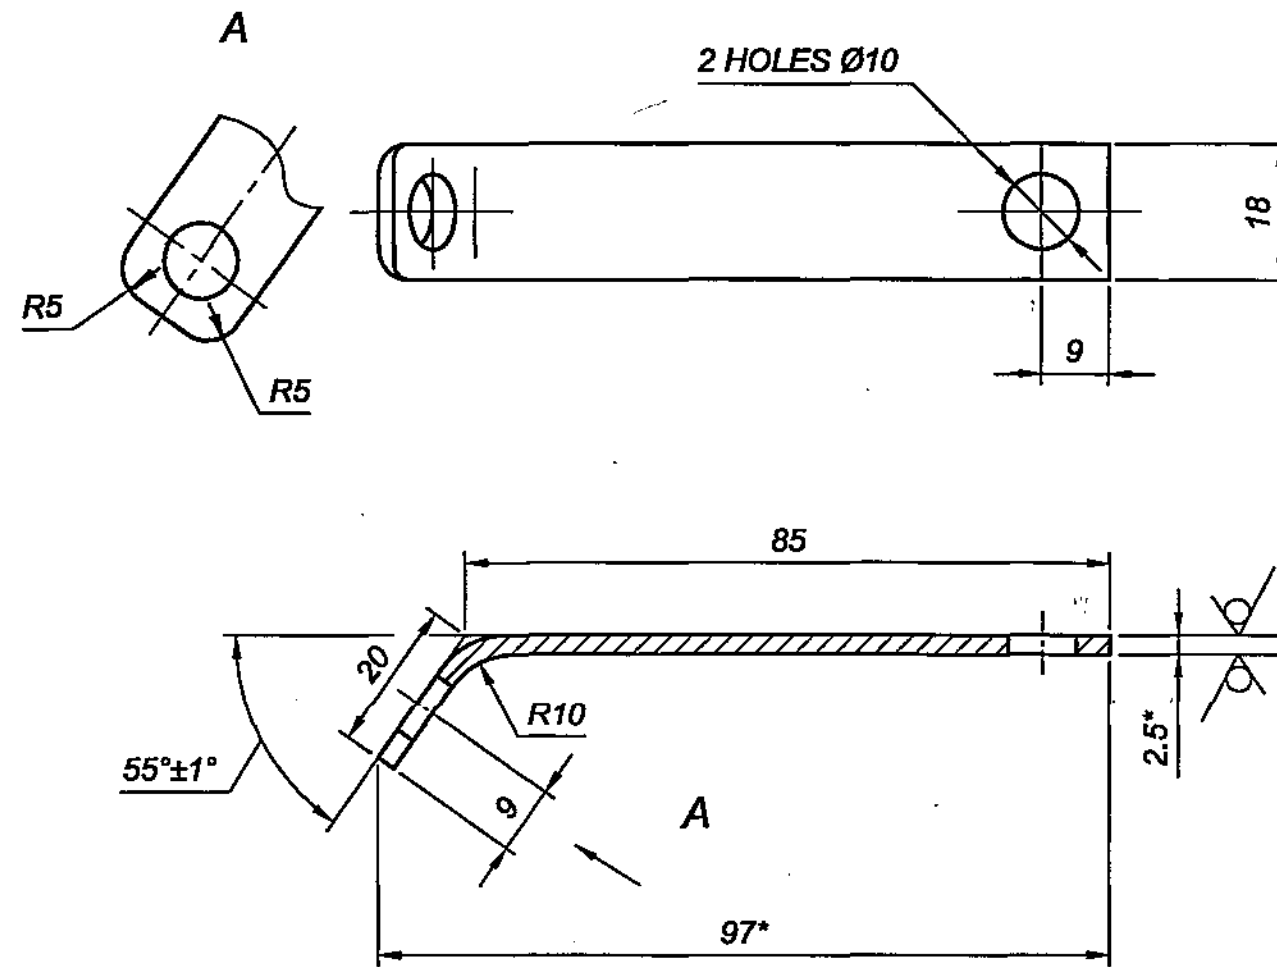

1. Allowed to make Roll AT-2.5 GOST 19904-90
5-II-CB-08nc GOST 9045-93
2. Straightened length $L \approx 105\text{mm}$.
3. Coating to be carried out with thickness of Zinc-6microns, chromium-1micron as per instructions ИП-749-88.
4. Unspecified limit deviations of dimensions are $\pm 0.5\text{mm}$.
5. *Dimension is given for reference.
6. In tropical use, coating of cadium - 9microns, chromium - 1micron, Titanium - 1micron is allowed as per instruction ИП-569-84.

(A) EQUIVALENT MATERIAL
Gr. D IS: 513-1994

PILOT SAMPLE SHOULD BE APPROVED BY A H S P
BEFORE BULK PRODUCTION.

EST. WT. (kg) **0.023** TO BE STAMPED OR MARKED WHERE
INDICATED THUS # (LETTERS)

ALL SHARP EDGES AND CORNERS TO BE REMOVED UNLESS
OTHERWISE STATED MACHINED CORNERS TO HAVE R OUT-
SIDE R INSIDE EQUIVALENT CHAMFERS ARE PERMISSIBLE.

DRN		MATERIAL :- SHEET	USED ON :-
CHD		AT-2.5 GOST 19904-90	CB 3342-00-21
APPD		5-II-CB-08nc GOST 9045-93	
DATE	09.5.07	CONTROLLERATE OF QUALITY ASSURANCE (HEAVY VEHICLES)	
SCALE:-	1:1	AVADI	
DIMENSIONS IN mm		TITLE :-	STRIP
TOLERANCE ON DIMNS UNLESS OTHERWISE STATED IS : 2102 - 69		D S CAT NUMBER	DRAWING NUMBER
ALL THREADS TO CONFORM TO			3342-27-2

ISSUE	DATE	NATURE OF AMENDMENTS
A	17-3-10	6 th Alt.Comm.Mt.Minutes Pt.No.1 Dt.26.10.09

DRG. INDIANISED BASED ON RUSSIAN ORIGINAL ISSUE - NIL

F-6
30
106

SIZE A3




DRG. INDIANISED BASED ON RUSSIAN ORIGINAL ISSUE - NIL

F-6
31
106

DRAWING NUMBER
3342-28

SHEET No. 1 OF 1

80 / (✓)

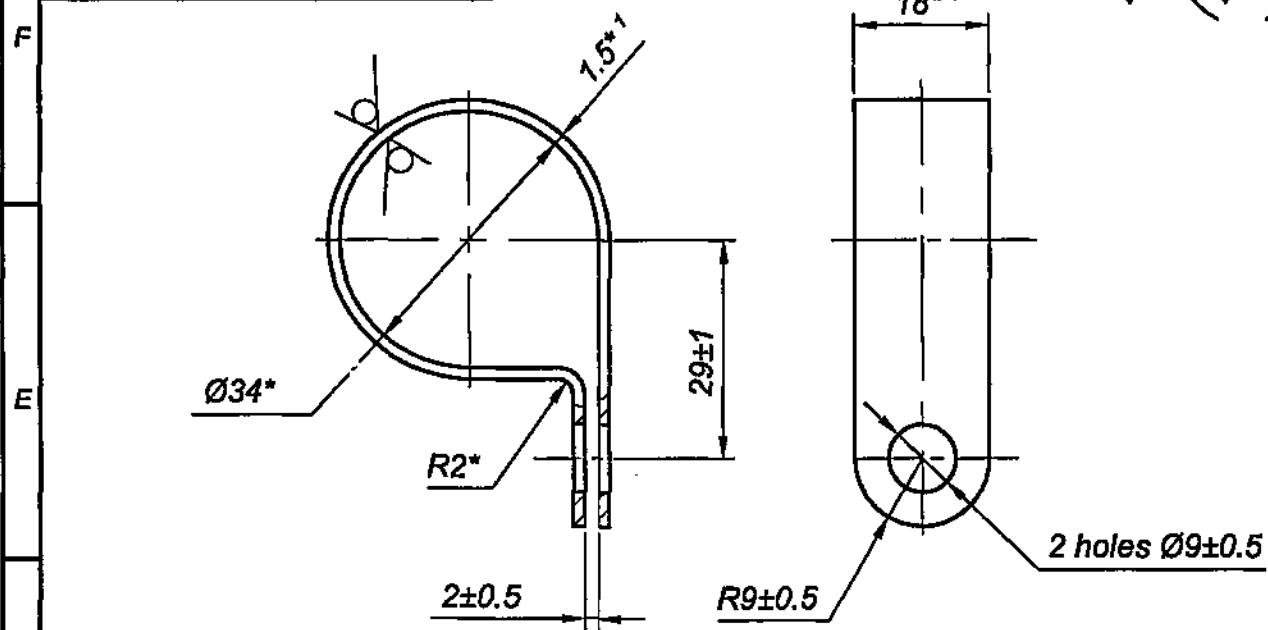

1. Straightened length L = 157mm.
2. Alternate material is steel 08 K17 Gost 1050-88.
3. Coating to be carried out with thickness of Zinc-6microns, Chromium-1micron, tungsten-1micron as per instruction ВЛ-749-88.
4. Coating for tropical use : Cadium-9microns, chromium-1micron, Titanium-1micron is allowed as per instruction ВЛ-569-84.
5. *Dimensions are ensured by tool.
6. *Dimensions are given for reference.

(A) EQUIVALENT MATERIAL
Gr.D.D IS: 513-1994

PILOT SAMPLE SHOULD BE APPROVED BY A H S P BEFORE BULK PRODUCTION.

			EST. WT. 0.03	TO BE STAMPED OR MARKED WHERE INDICATED THUS # (LETTERS)
			ALL SHARP EDGES AND CORNERS TO BE REMOVED UNLESS OTHERWISE STATED MACHINED CORNERS TO HAVE R OUT-SIDE R INSIDE EQUIVALENT CHAMFERS ARE PERMISSIBLE.	
			MATERIAL :- BAND 08nc-M-2-1.5x18 GOST 503-81	USED ON :- Cb 3342-00-21
A	17.3.10	*Alt.Comm.Mf.Minutes Pf.No.1Dt.26.10.09		
ISSUE	DATE	NATURE OF AMENDMENTS		
DRN		SCALE :- 1:1	CONTROLLERATE OF QUALITY ASSURANCE (HEAVY VEHICLES) AVADI	
CHD		DIMENSIONS IN mm		
APPD		TOLERANCE ON DIMENSIONS UNLESS OTHERWISE STATED IS : 2102 - 69		TITLE :- CLIP
DATE	09.5.07	ALL THREADS TO CONFORM TO	D S CAT NUMBER	DRAWING NUMBER 3342-28
SIZE A4				




